


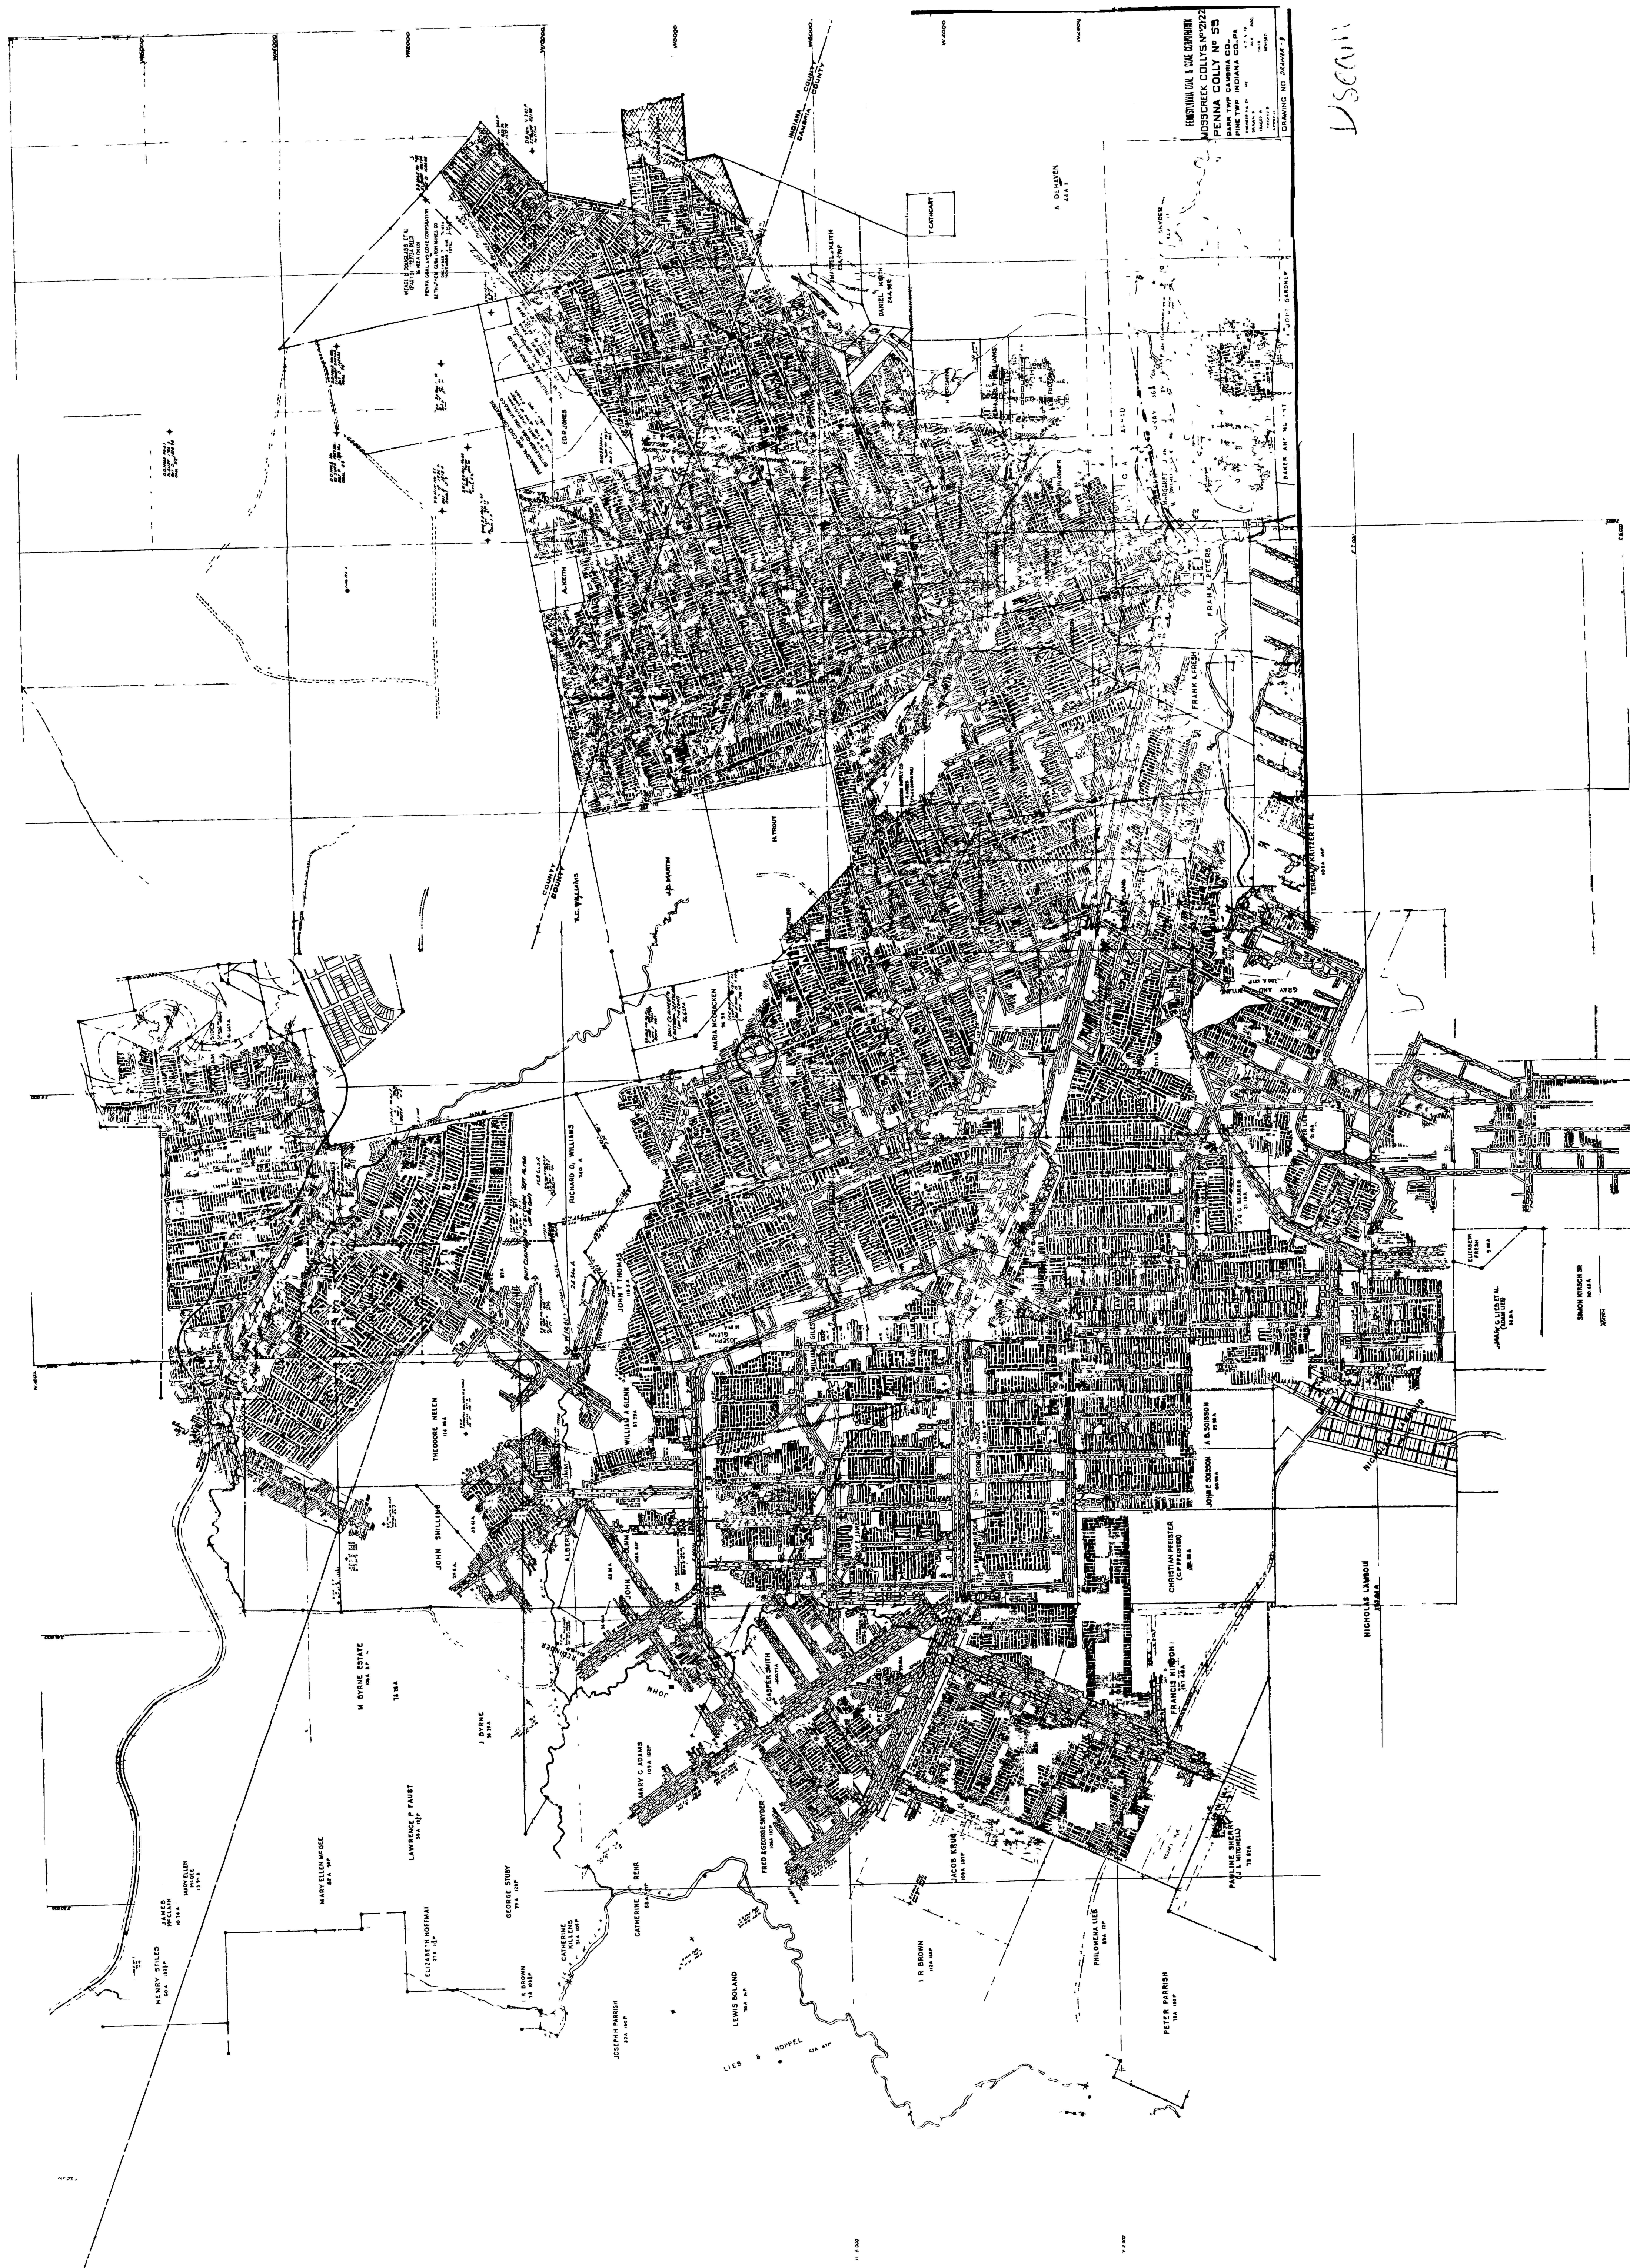

Desai