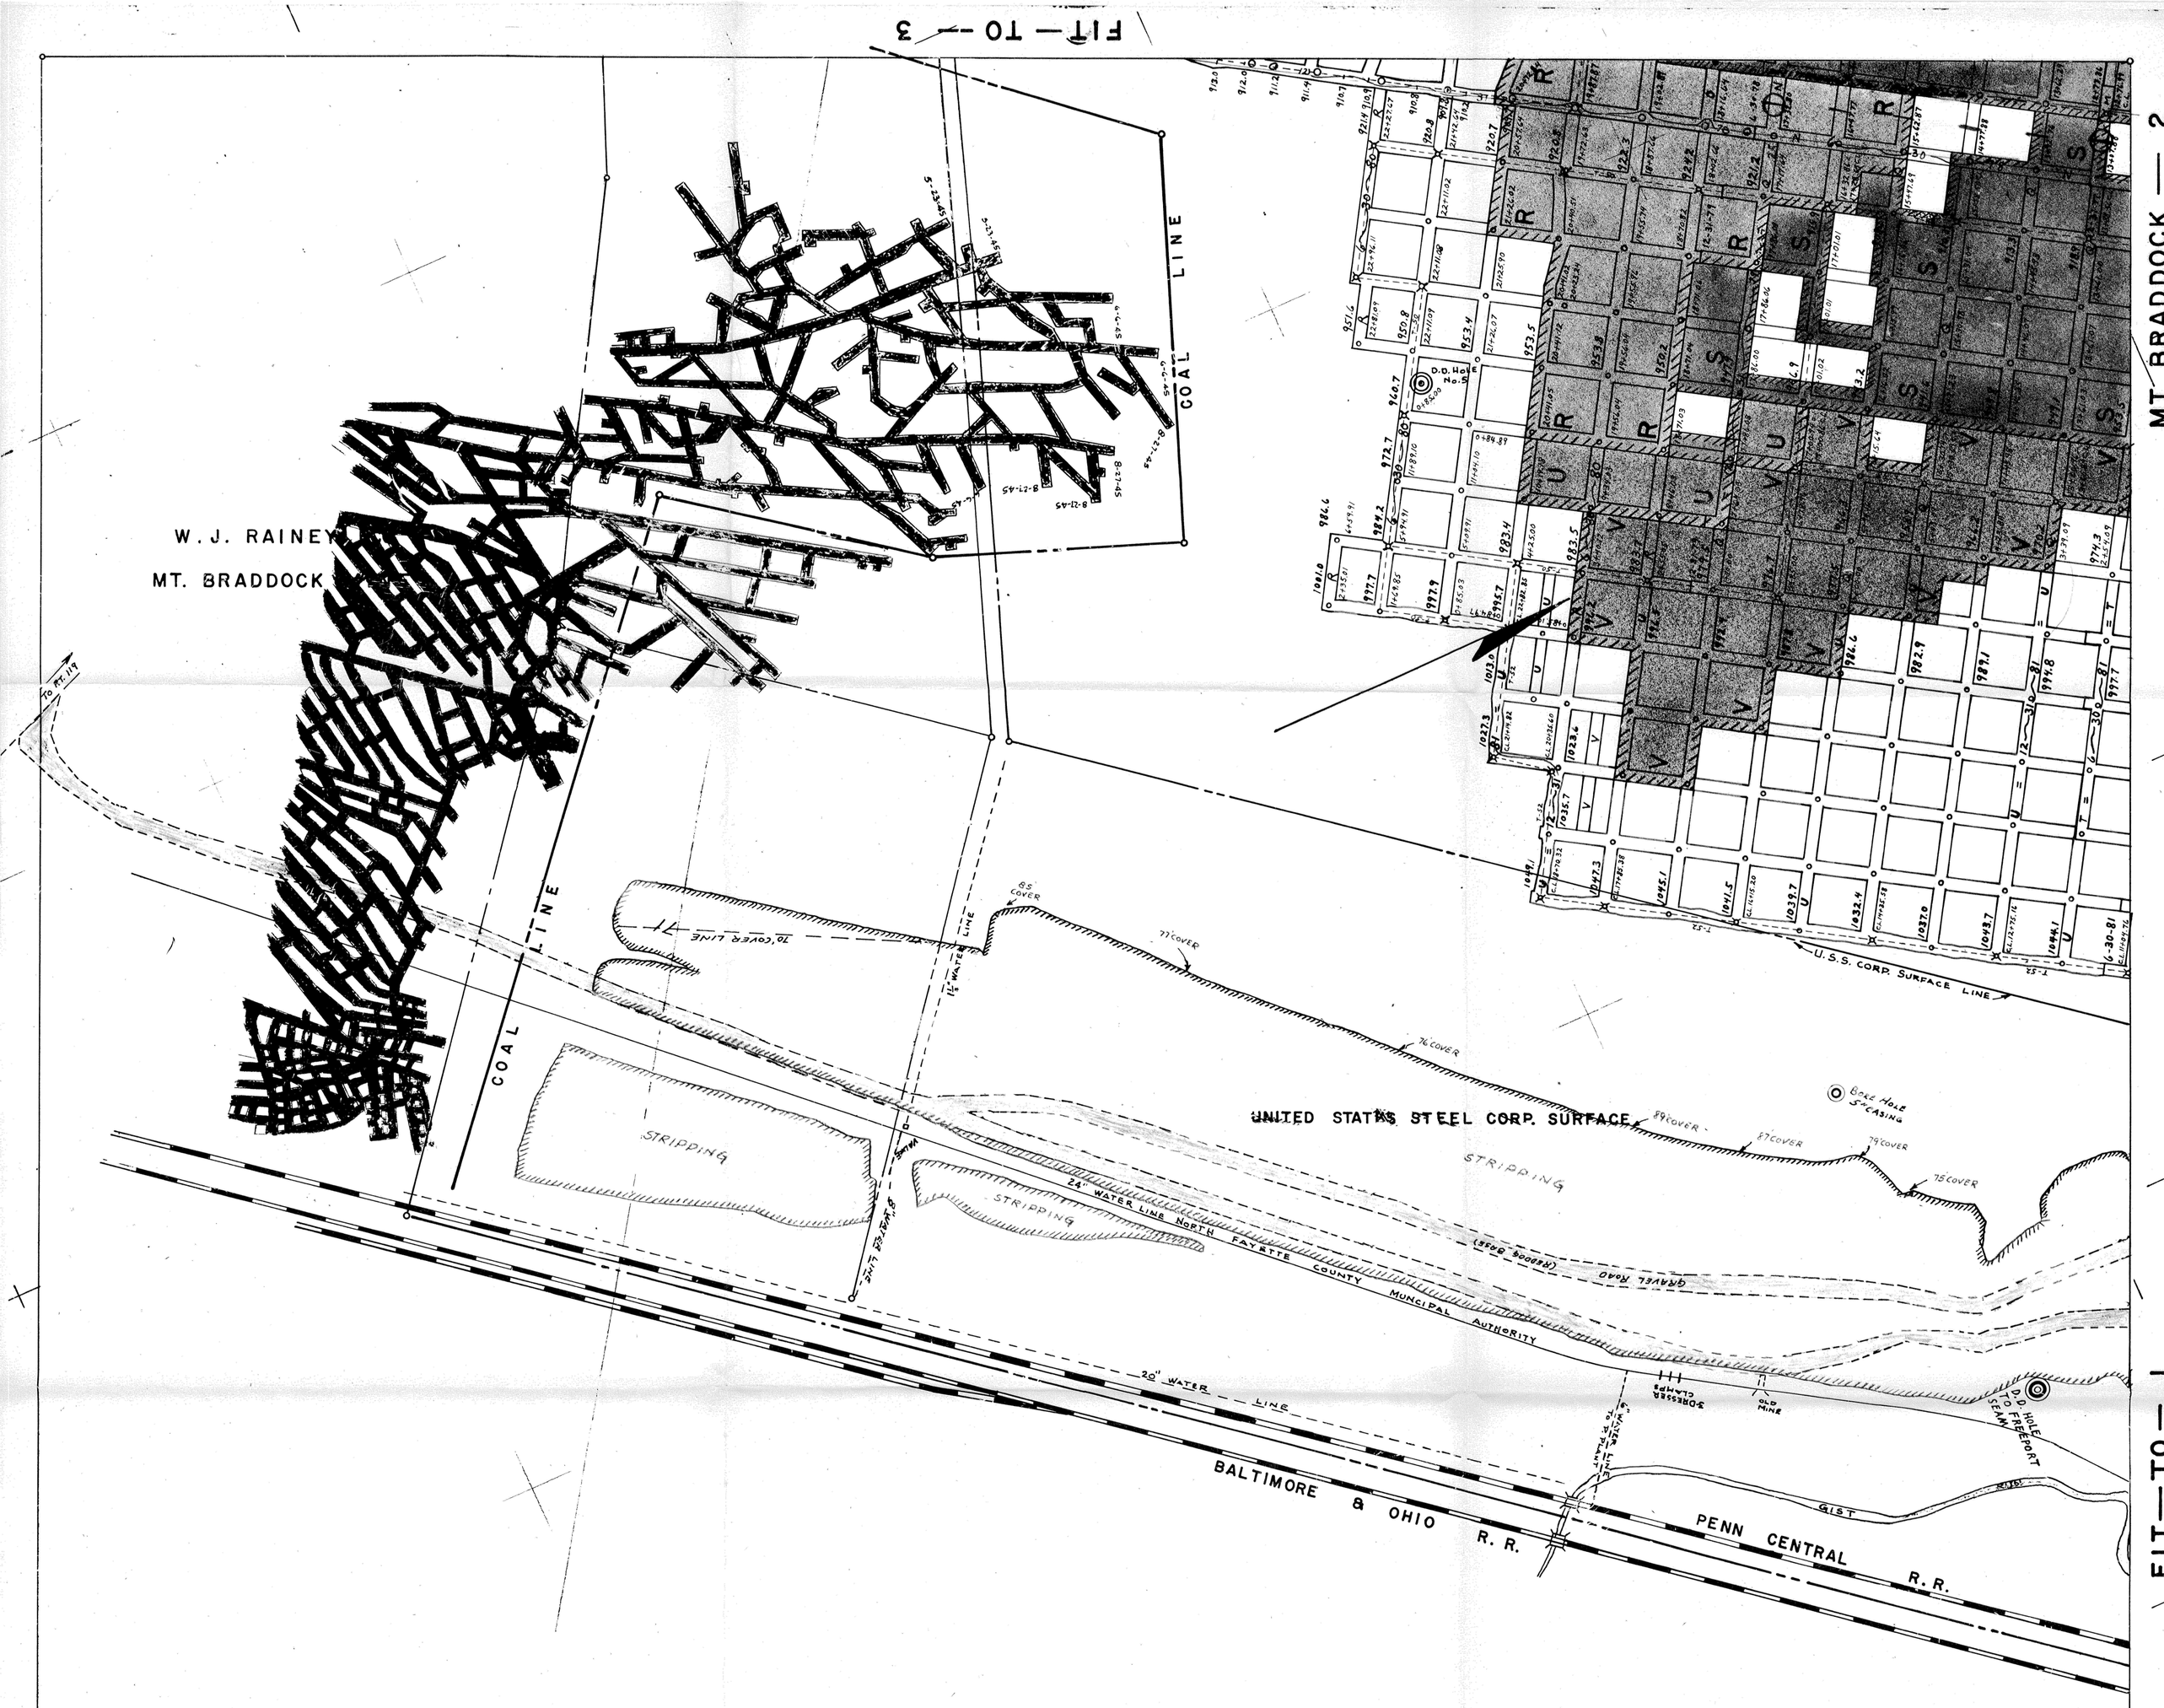

U. S. STEEL MINING CO., INC.

MT. BRADDOCK MINE

FAYETTE COUNTY, PENNSYLVANIA

DUNBAR TWP. NORTH UNION TWP.

DATUM OF LEVELS
BASE ON U.S. GEOLOGICAL SURVEY

SCALE 1" = 100' JANUARY 1, 1970

FIT-TO-PLAN

3	4
2	1

DATE OF LAST SURVEY

DATE OF SURVEY	LETTER	PLOTTED	TRACED	DATE OF SURVEY	LETTER	PLOTTED	TRACED	DATE OF SURVEY	LETTER	PLOTTED	TRACED
12-31-71	A	E.L.	E.L.	12-31-75	I	E.L.	E.L.	12-31-79	Q	F.P.	F.P.
6-30-72	B	E.L.	E.L.	6-30-76	J	E.L.	E.L.	6-30-80	R	F.P.	F.P.
12-31-72	C	E.L.	E.L.	12-31-76	K	E.L.-A.M.	A.M.M.	12-31-80	S	J.H.	J.H.
6-30-73	D	E.L.	E.L.	6-30-77	L	F.P.	F.P.	6-30-81	T	F.P.	F.P.
12-31-73	E	E.L.	E.L.	12-31-77	M	J.H.	J.H.	12-31-81	U	J.H.-F.P.	F.P.
6-30-74	F	E.L.	E.L.	6-30-78	N	F.P.	F.P.	6-30-82	V	J.H.	J.H.
12-31-74	G	E.L.	E.L.	12-31-78	O	F.P.	E.A.				
6-30-75	H	E.L.	E.L.	6-30-79	P	J.H.	J.H.				

FIT—TO—1

MT. BRADDOCK—2