

W. J. RAINEY CO.
MT. BRADDOCK MINE

BARRIER

BARRIER

COAL LINE

DUNBAR FURNACE CO.
FERGUSON MINE

BARRIER

COAL LINE

DUNBAR FURNACE CO.
FERGUSON MINE

COAL LINE

United States Steel Corp.
Surface

U.S. STEEL CORP. SURFACE LINE

STRIPPING

STRIPPING


STRIPPING

STRIPPING

UNITED STATES STEEL CORPORATION
36-02810-0
MT. BRADDOCK MINE

FAYETTE COUNTY, PENNSYLVANIA
DUNBAR TWP. NORTH UNION TWP.

SCALE
1"=200'

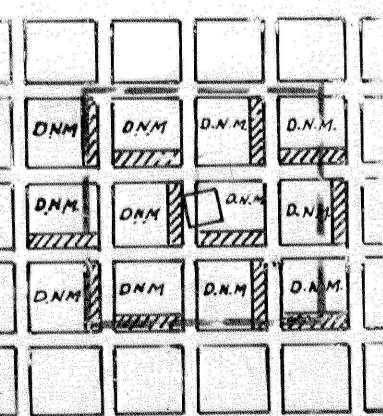


TYPICAL PLAN OF 50% MINING
FOR DWELLING SUPPORT

1970

SURVEY DATE 6-30-80

SHOWN IN GREEN — PROJECTION OF MINING TO BE PERFORMED FROM 6-30-80 TO 12-31-80

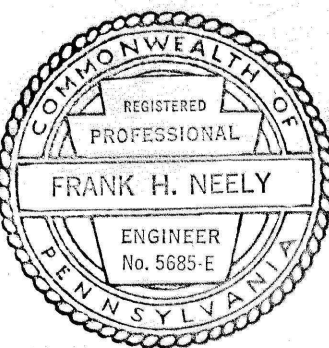

Frank H. Neely 12-6-80

