


FIT TO №1

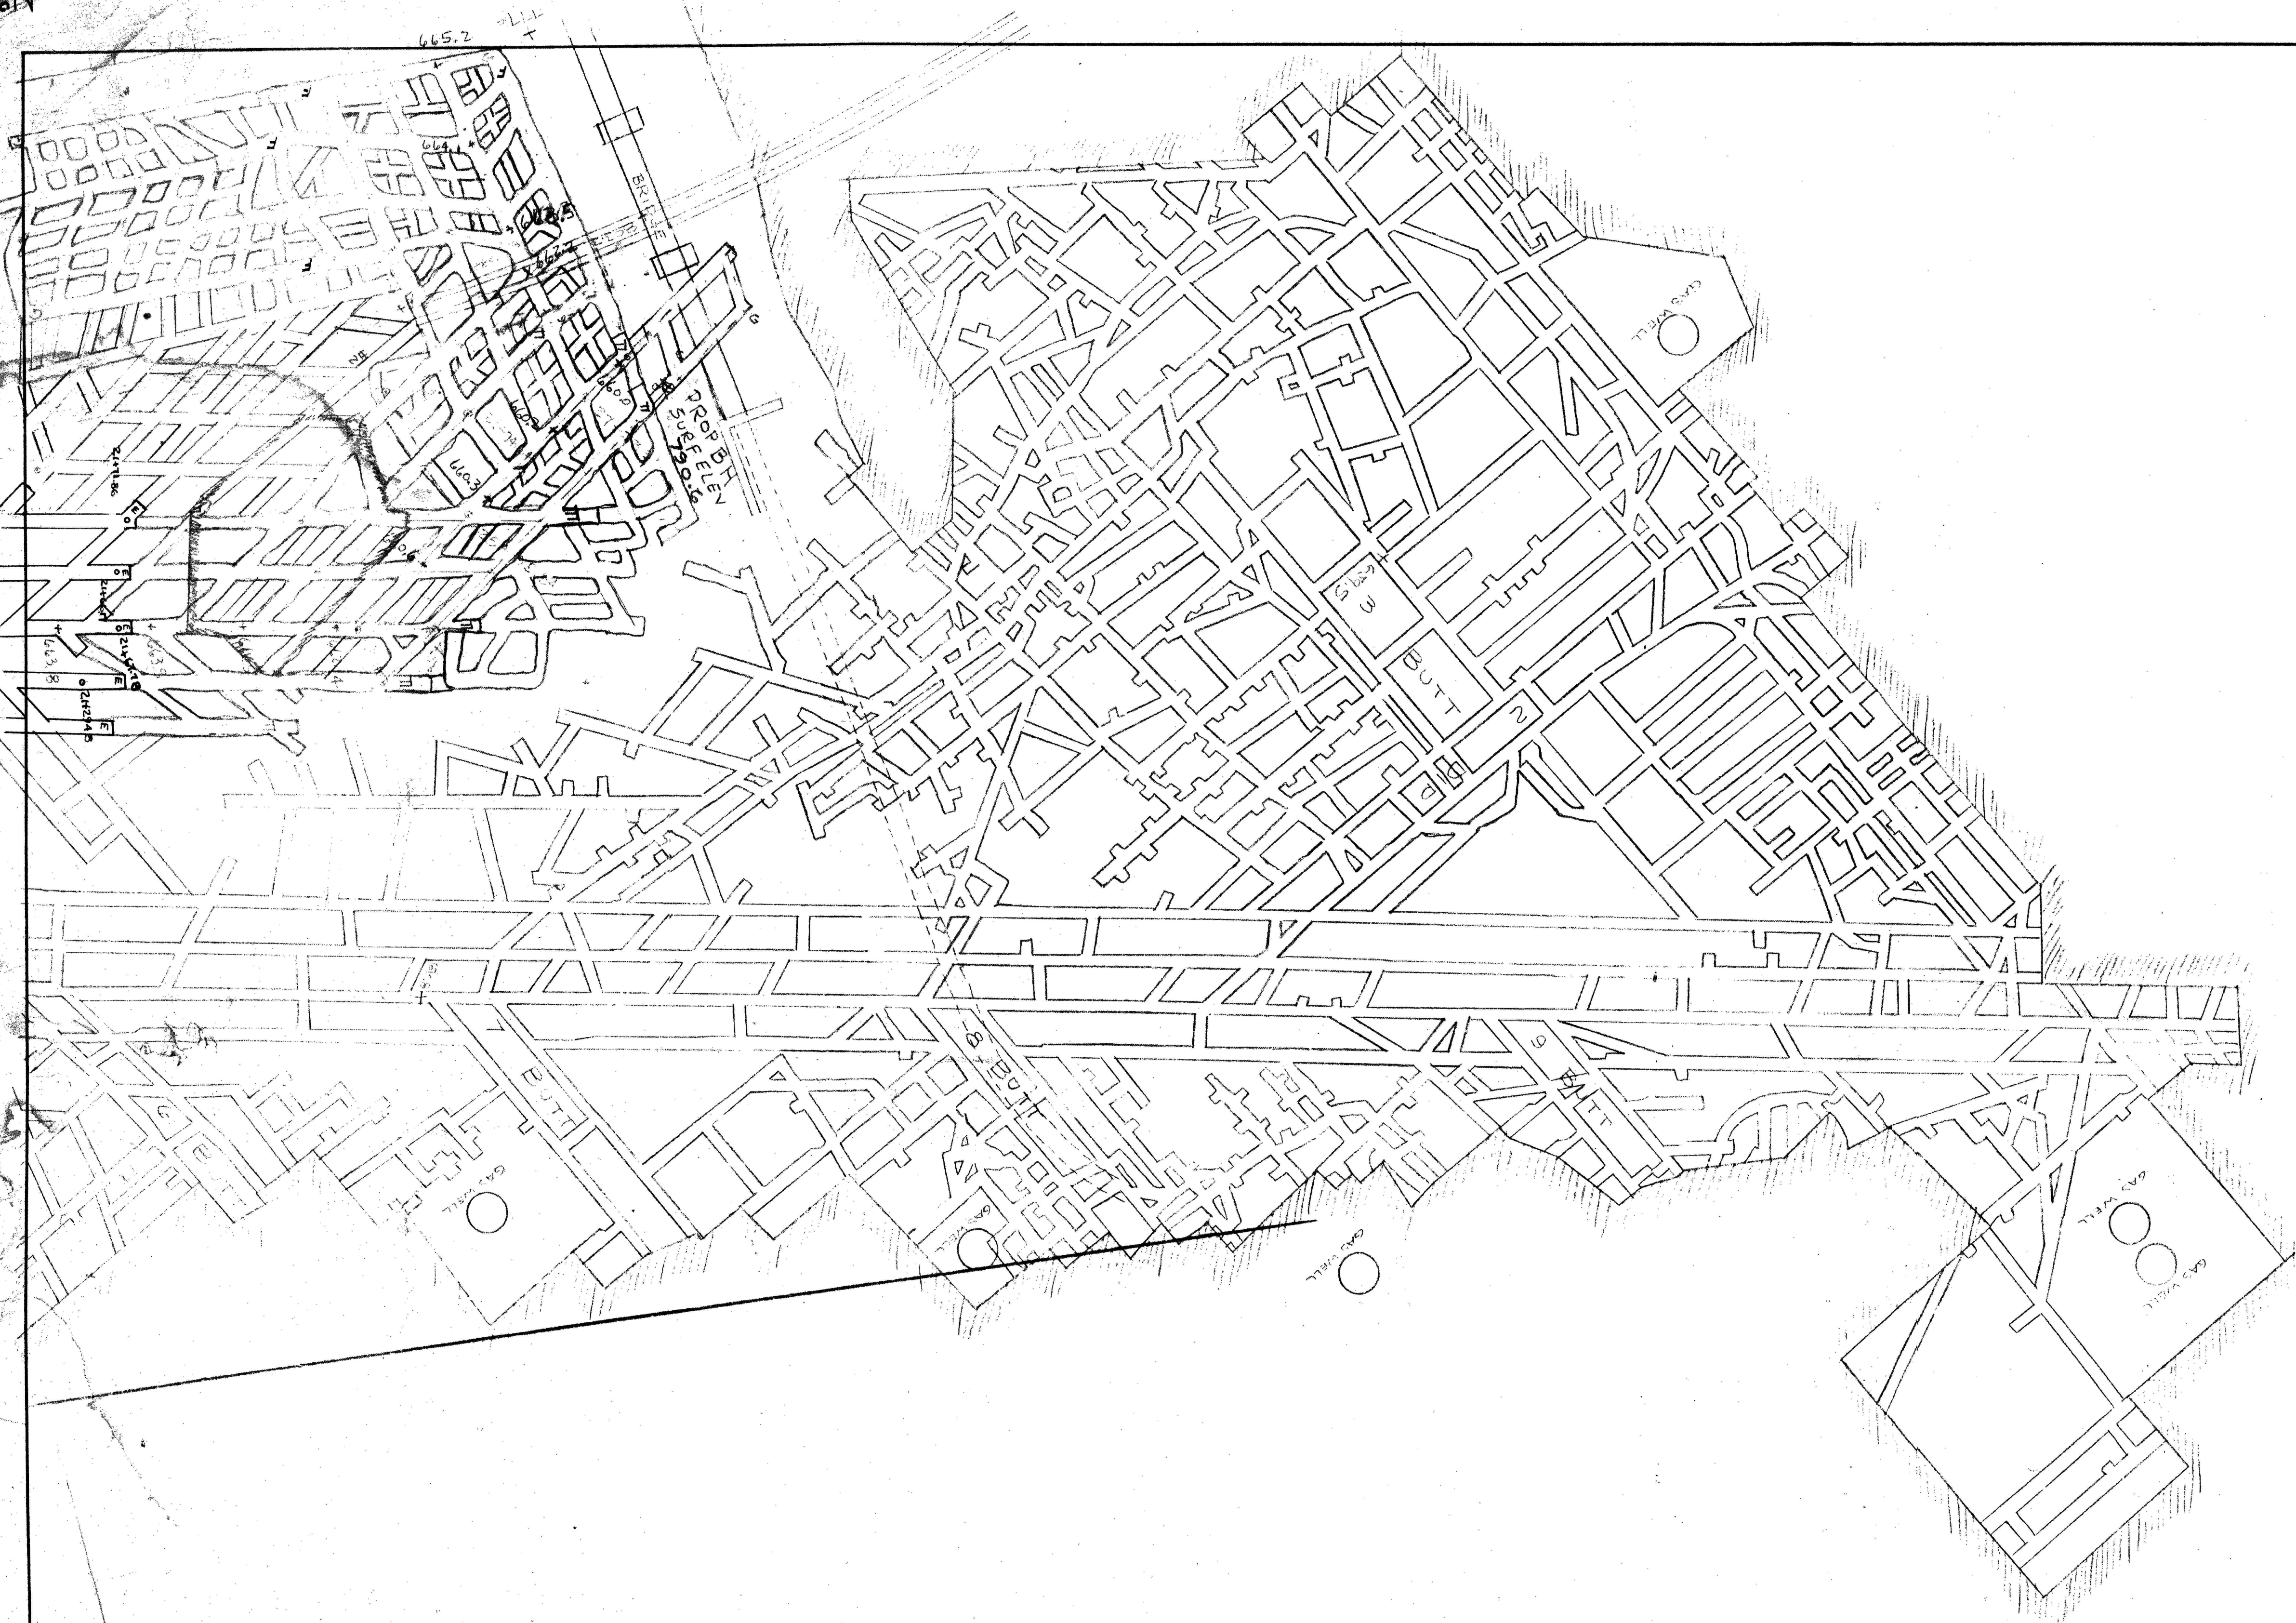

FIT TO №3