


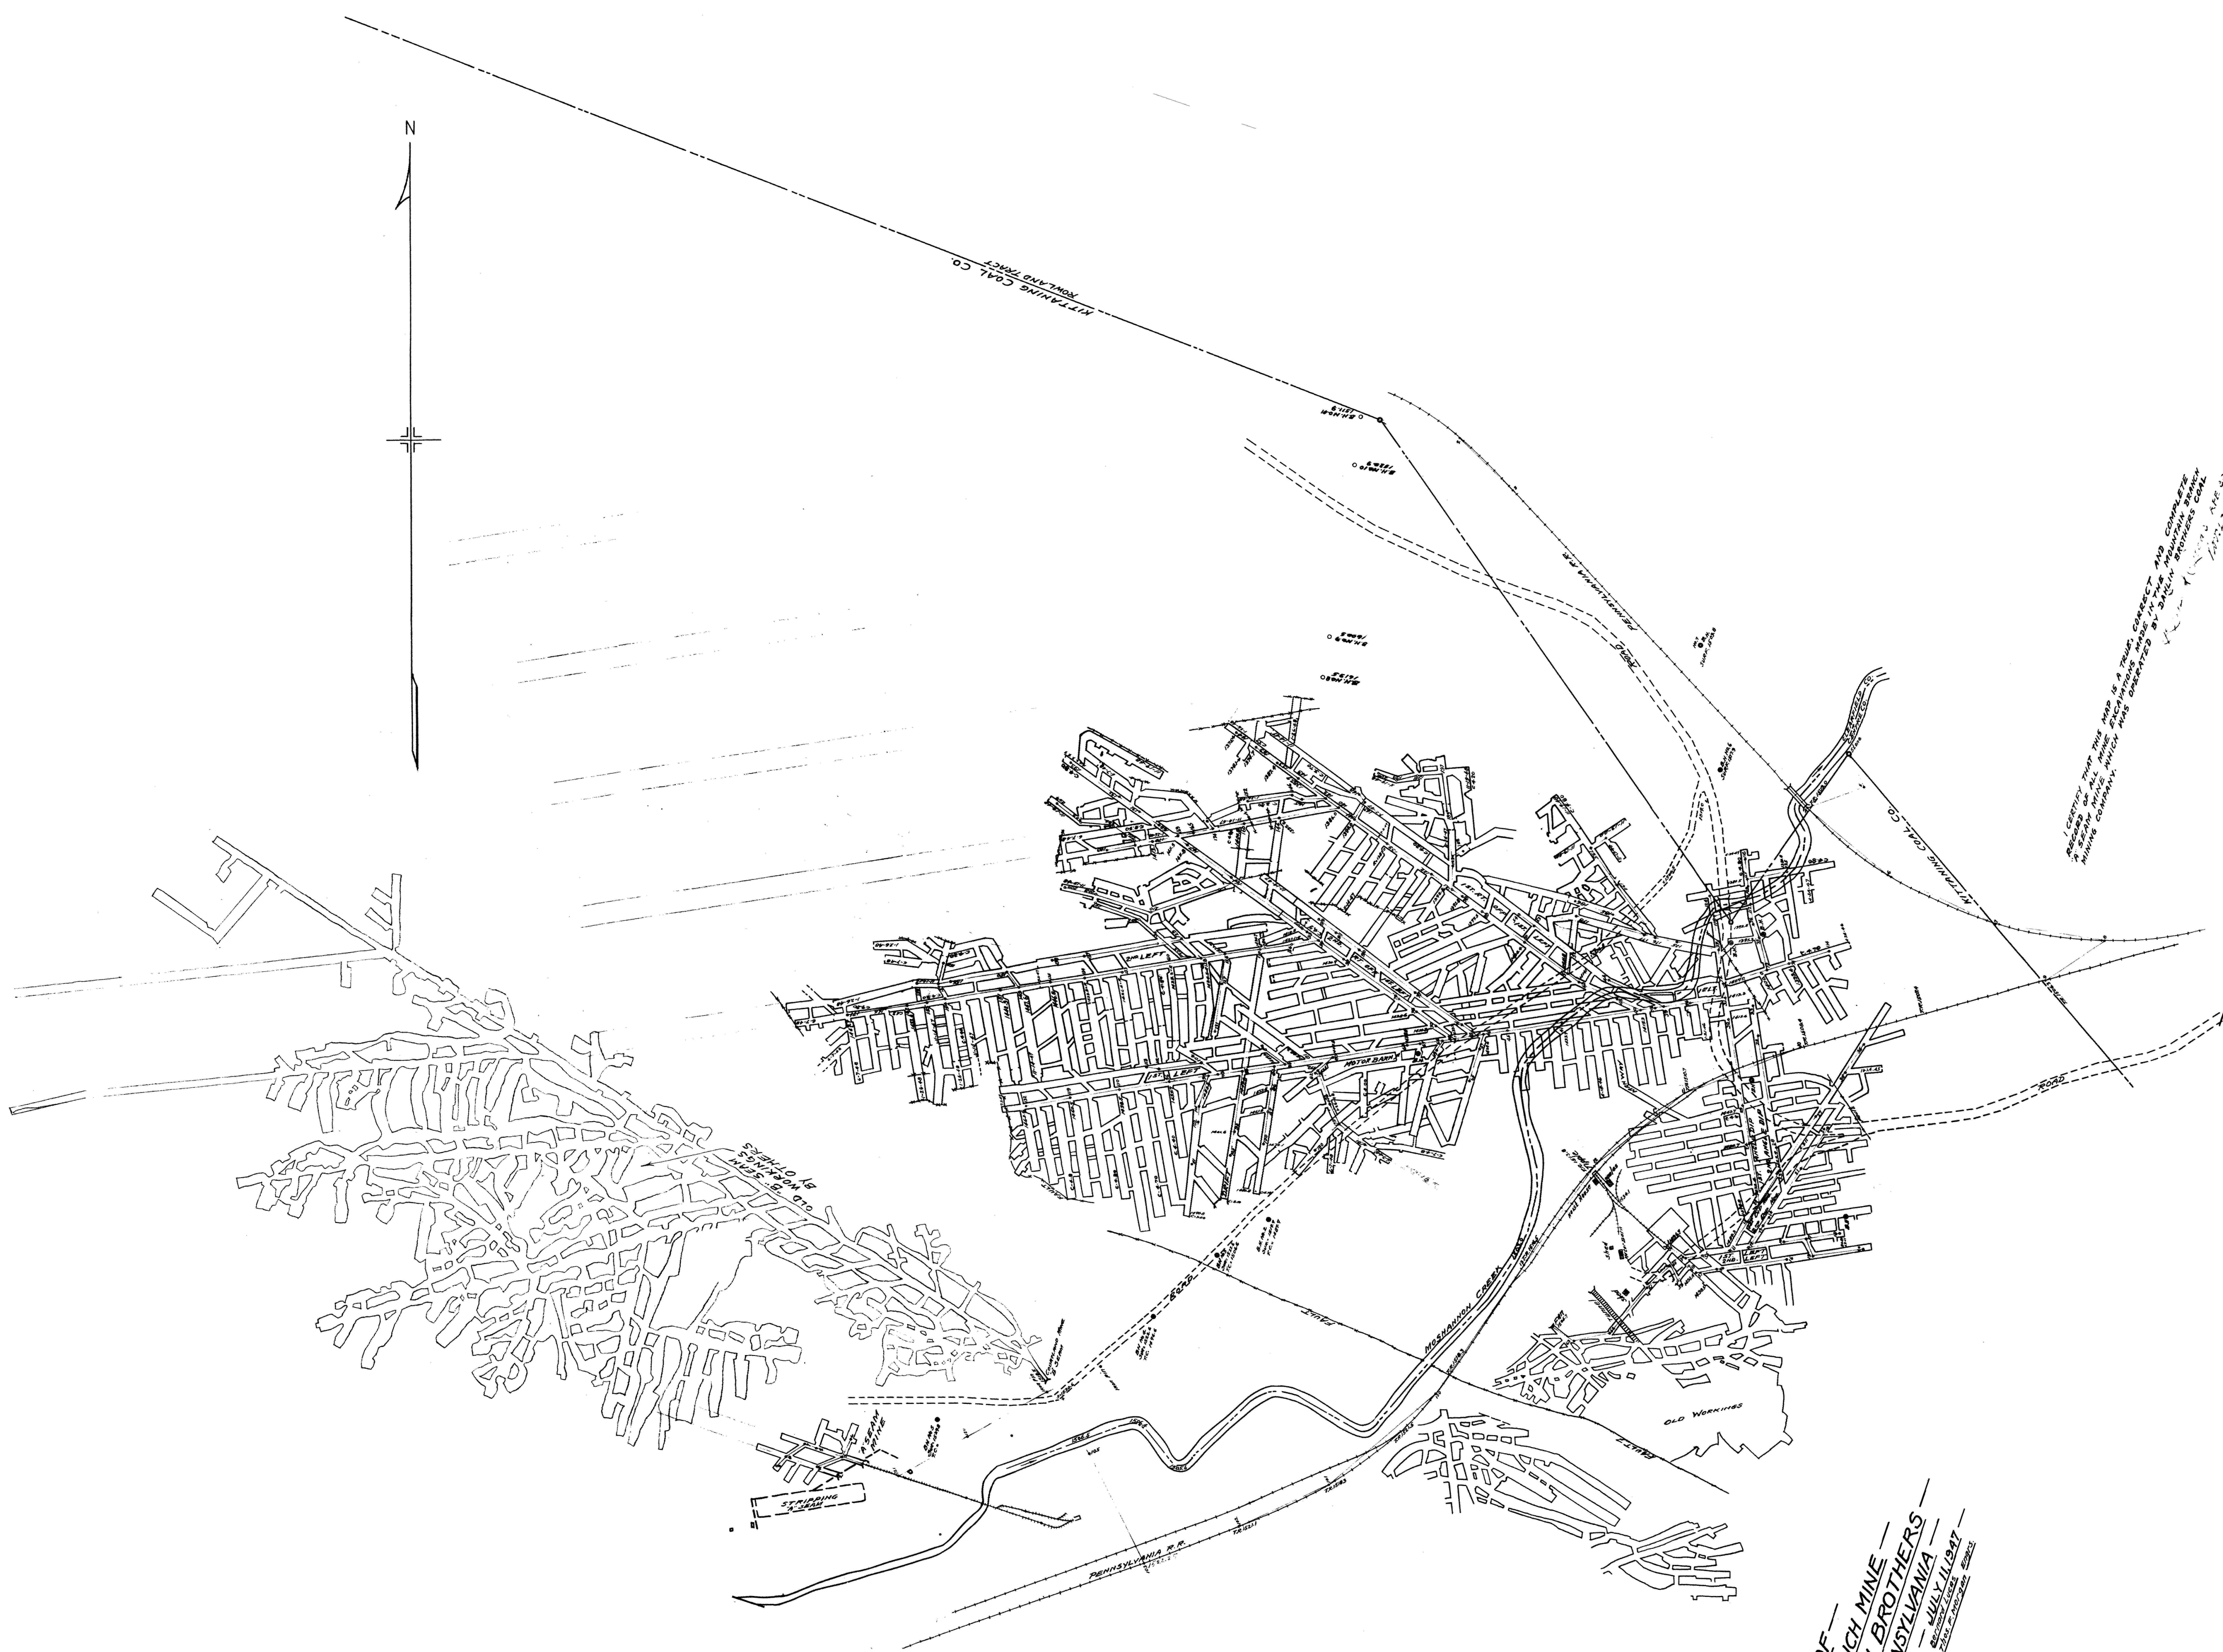

I HEREBY CERTIFY THAT THIS MAP IS A TRUE, CORRECT, AND COMPLETE
REPRESENTATION OF ALL WORKINGS AND SHAFTS OF THE MOUNTAIN BRANCH CO.
AS OF THE DATE HEREON DATED AND AS THE SAME ARE NOW
BEING OPERATED.

MAP OF
MOUNTAIN BRANCH MINE
OPERATED BY DAHLIN BROTHERS
HOUTZDALE PENNSYLVANIA
JULY 1914
SCALE 1/2" = 100'

A. SEAM