


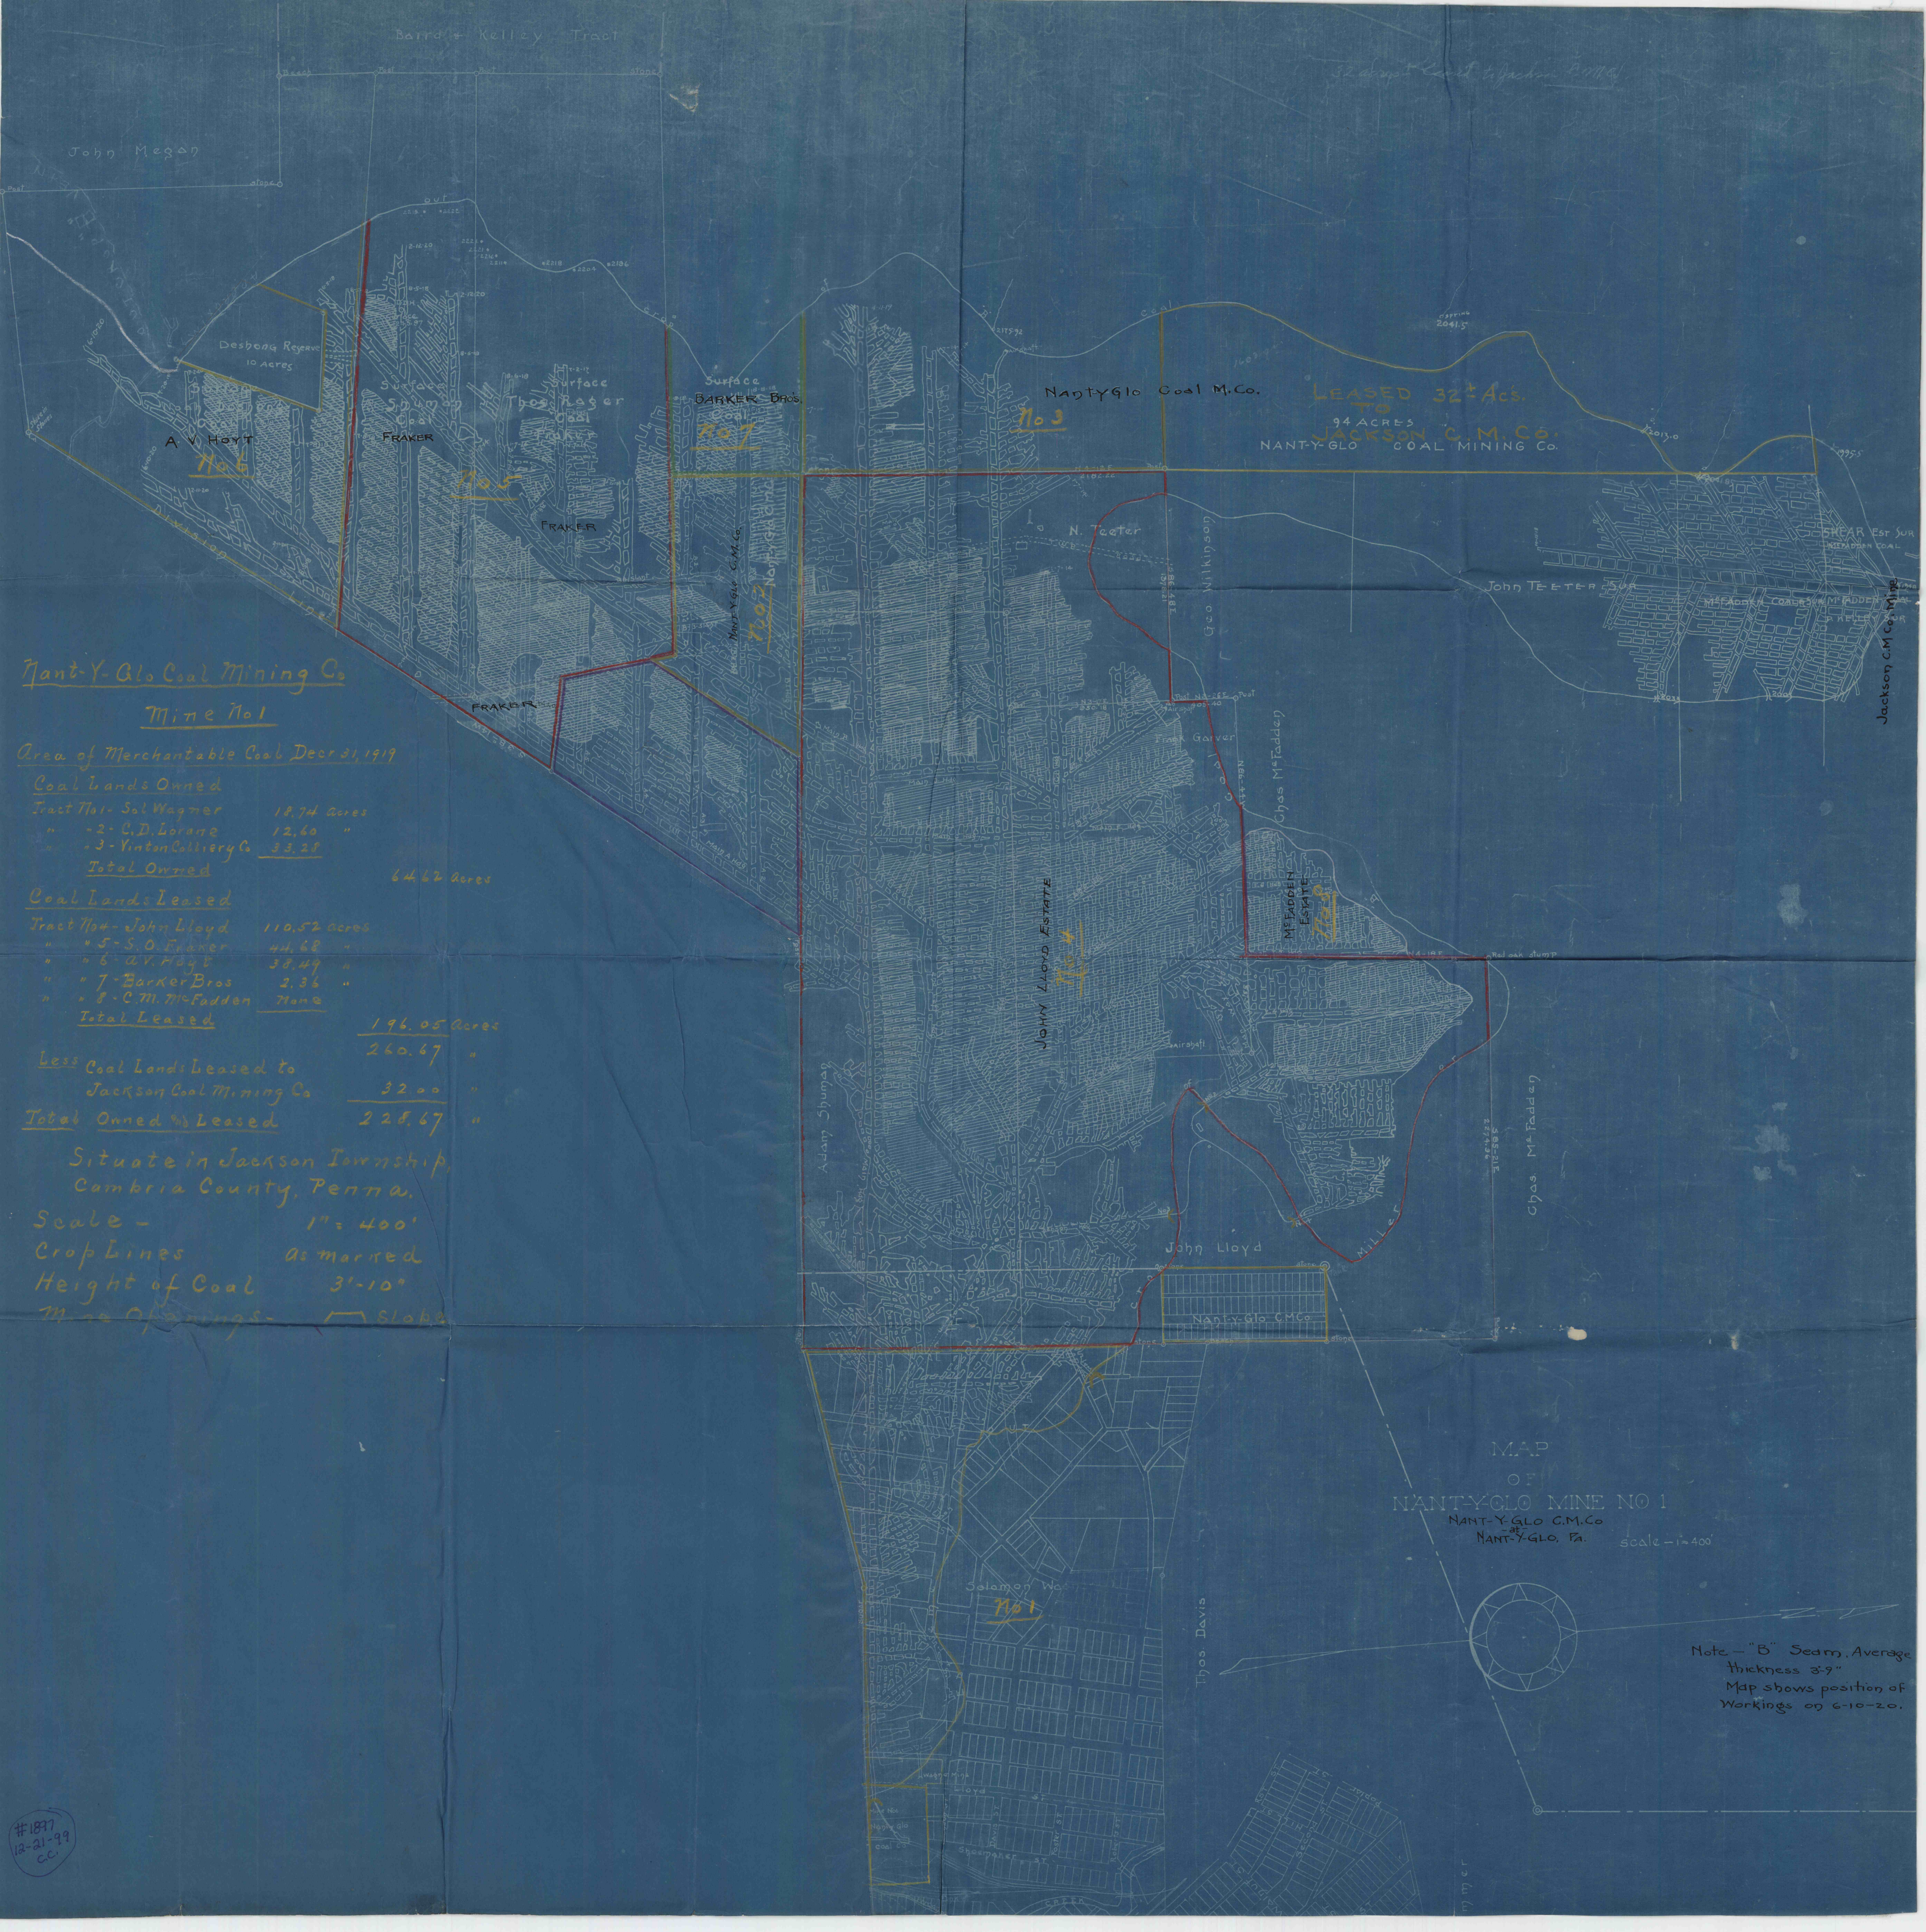

Nanty-glo Coal Mining Co.

Mine No. 1

Area of Merchantable Coal Decr 31, 1919

<u>Coal Lands Owned</u>	
Tract No. 1 - Sal Wagner	18.74 Acres
" " 2 - C. D. Lorange	12.60 "
" " 3 - Vinton Colliery Co.	33.28 "
<u>Total Owned</u>	<u>64.62 Acres</u>

<u>Coal Lands Leased</u>	
Tract No. 4 - John Lloyd	110.52 Acres
" " 5 - S. O. Franer	44.68 "
" " 6 - A. V. Hoyt	38.49 "
" " 7 - Barker Bros	2.36 "
" " 8 - C. M. McFadden	71.00 "
<u>Total Leased</u>	<u>196.05 Acres</u>

<u>Less Coal Lands Leased to</u>	<u>260.67 "</u>
<u>Jackson Coal Mining Co.</u>	<u>32.00 "</u>
<u>Total Owned & Leased</u>	<u>228.67 "</u>

Situate in Jackson Township,
Cambria County, Penna.

Scale - 1" = 400'

Crop Lines as marked

Height of Coal 3'-10"

Min. Openings - Slabs

MAP
OF
NANTY-GLO MINE NO. 1
NANTY-GLO C.M. CO.
NANTY-GLO, PA. Scale - 1" = 400'

Note - "B" Seam, Average
thickness 3'-9"
Map shows position of
Workings on 6-10-20.

#1877
12-21-99
C.C.