


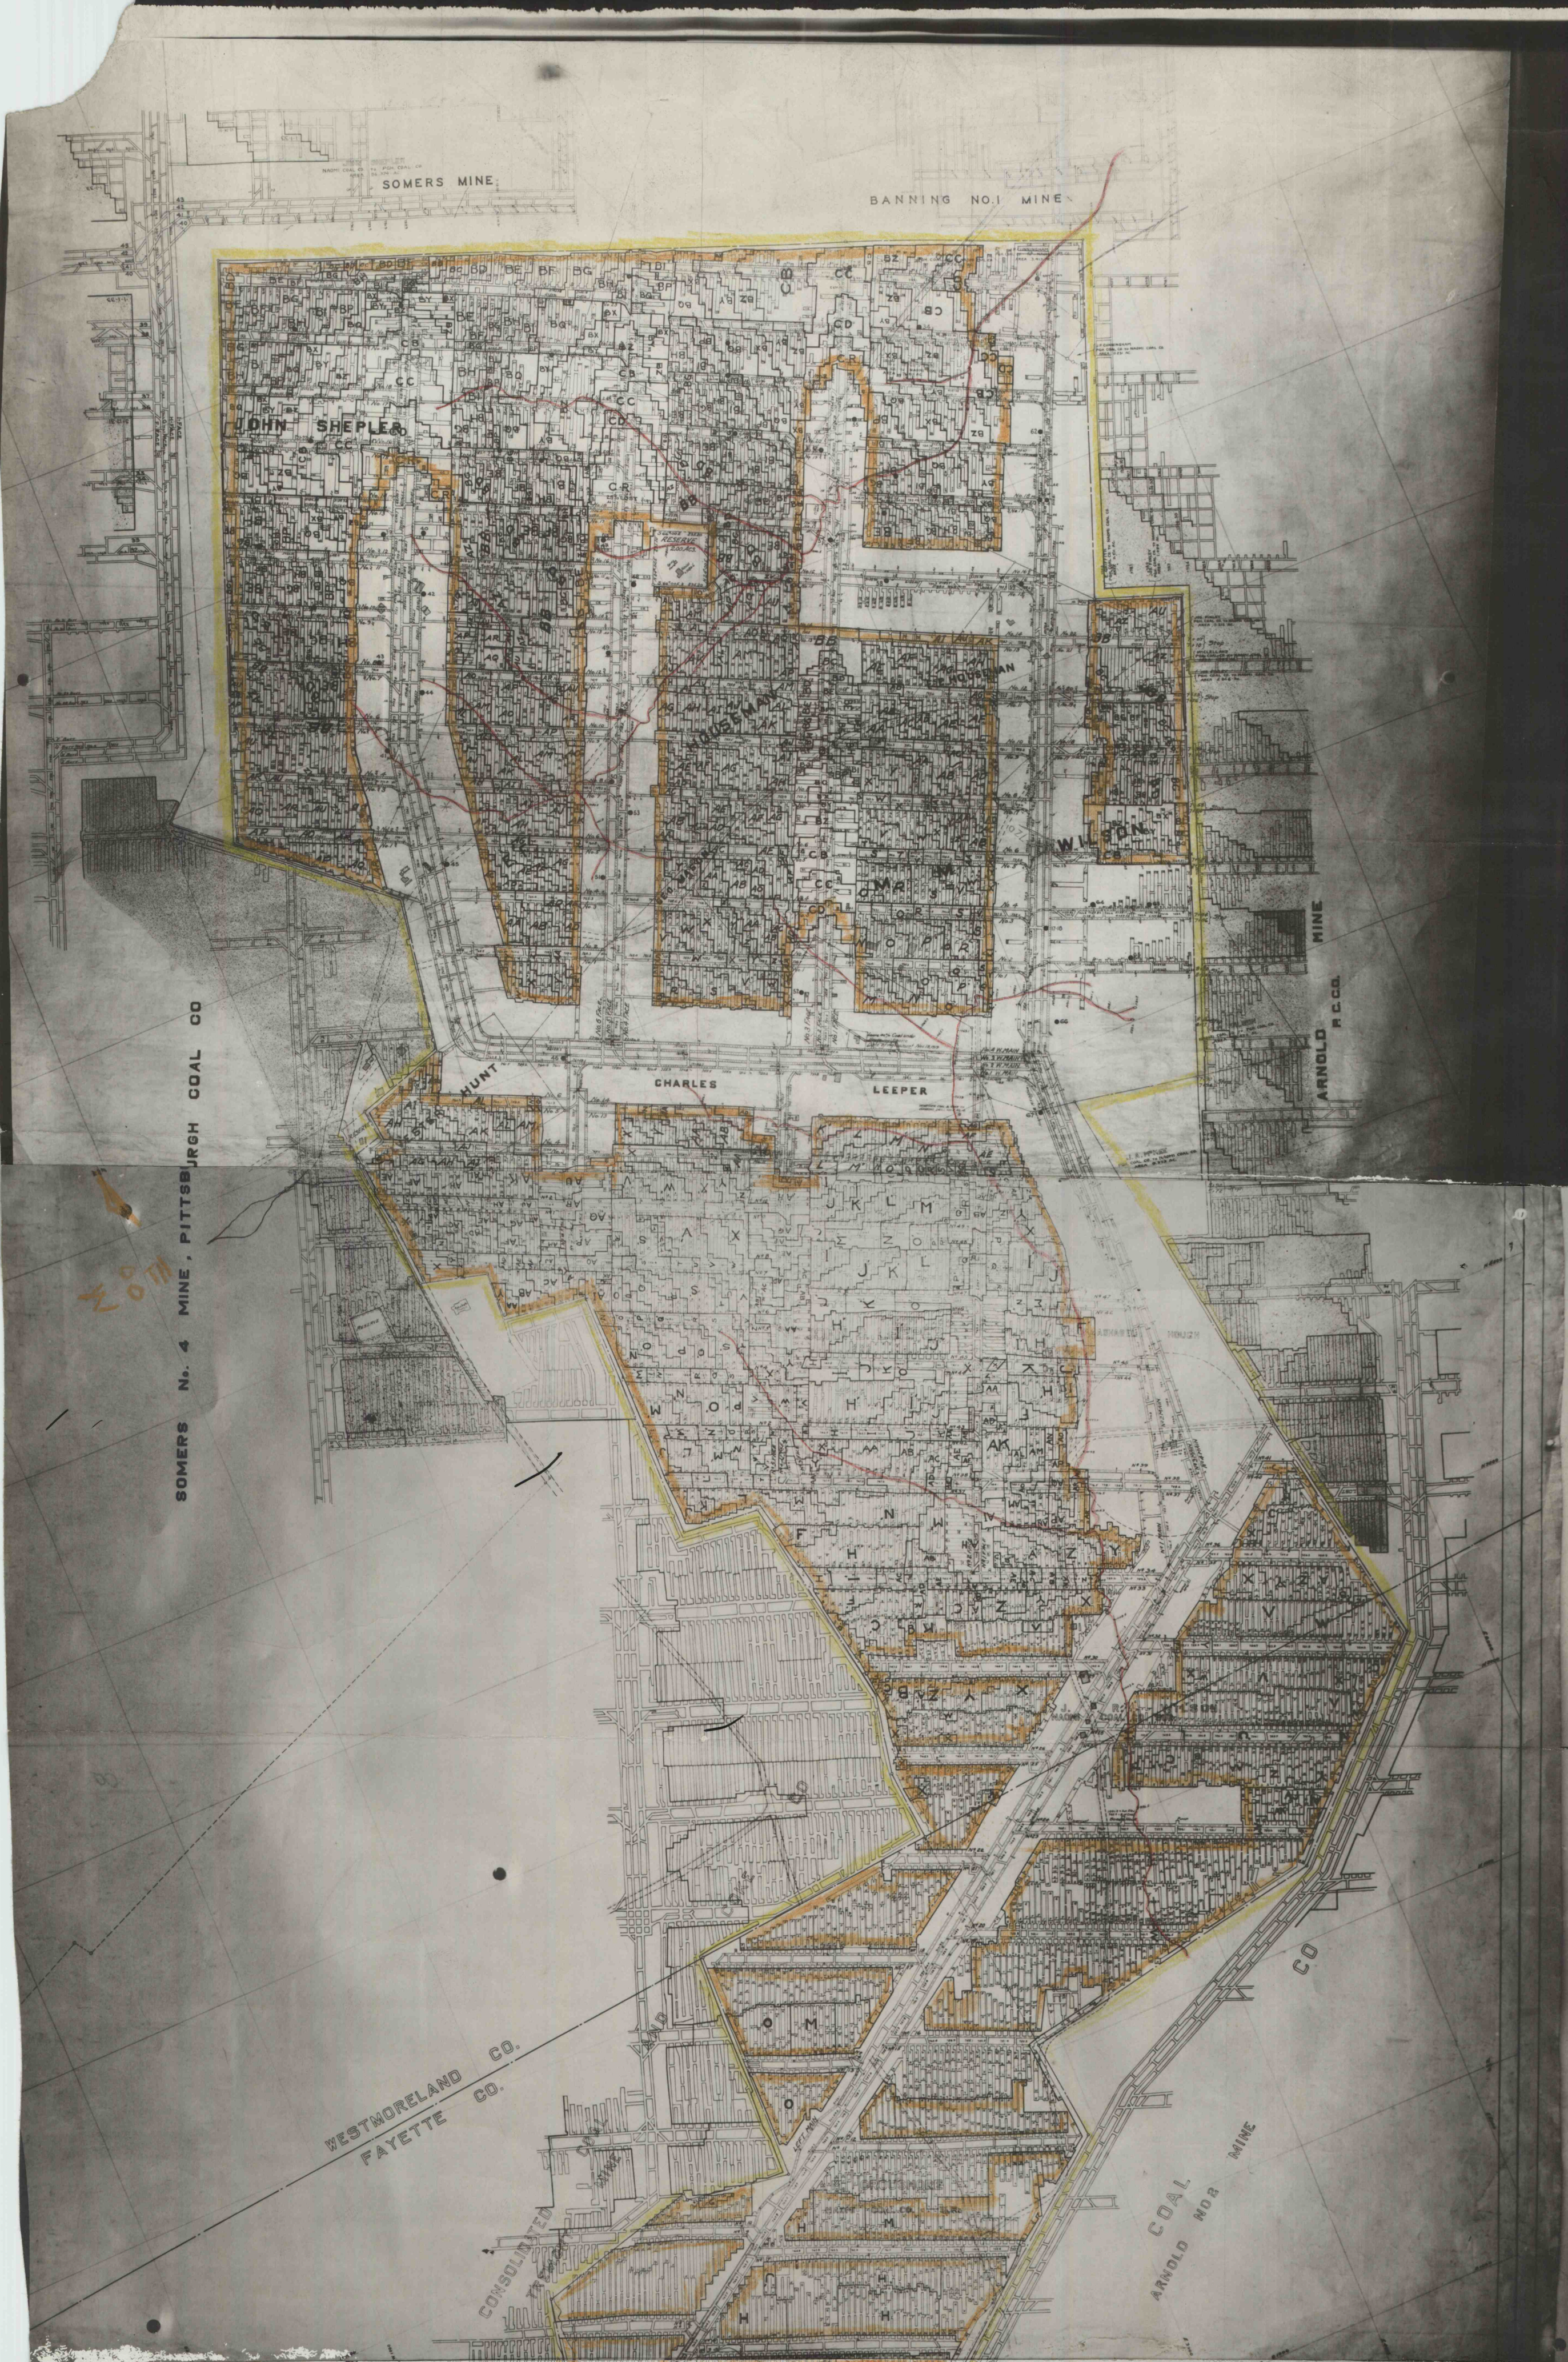

SOMERS No. 4 MINE, PITTSBURGH COAL CO

WESTMORELAND CO.
FAYETTE CO.

*Reduced
200 to 1200' per unit
4/30/34
Salem Gates*

*MM
305
HILLMAN*

Brownsville

MAP OF
NAOMI MINE
SITUATE IN
WASHINGTON TWP. FAYETTE CO.
AND
ROSTRAVER TWP. WESTMORELAND CO.
ENG. DEPT. HILLMAN COAL & COKE CO.
SCALE 1"=200' OCT. 12, 1914.

INDEX

SECTION	DATE OF ADJUSTMENT	DATE OF SURVEY
1	1914	1914
2	1914	1914
*#1899
12-21-79
CC*