THE BUCKEYE COAL CO.
NEMACOLIN PA.

ASH AND SULFUR MAP

SCALE: 1"=400' DATE:

LOCATION: WEST END OF MINE

FIGURES ARE FULL SEAM COMPOSITES

SAMPLE 0.00 ASH 0.00 SULFUR

DWG. #66037- G.E.K.

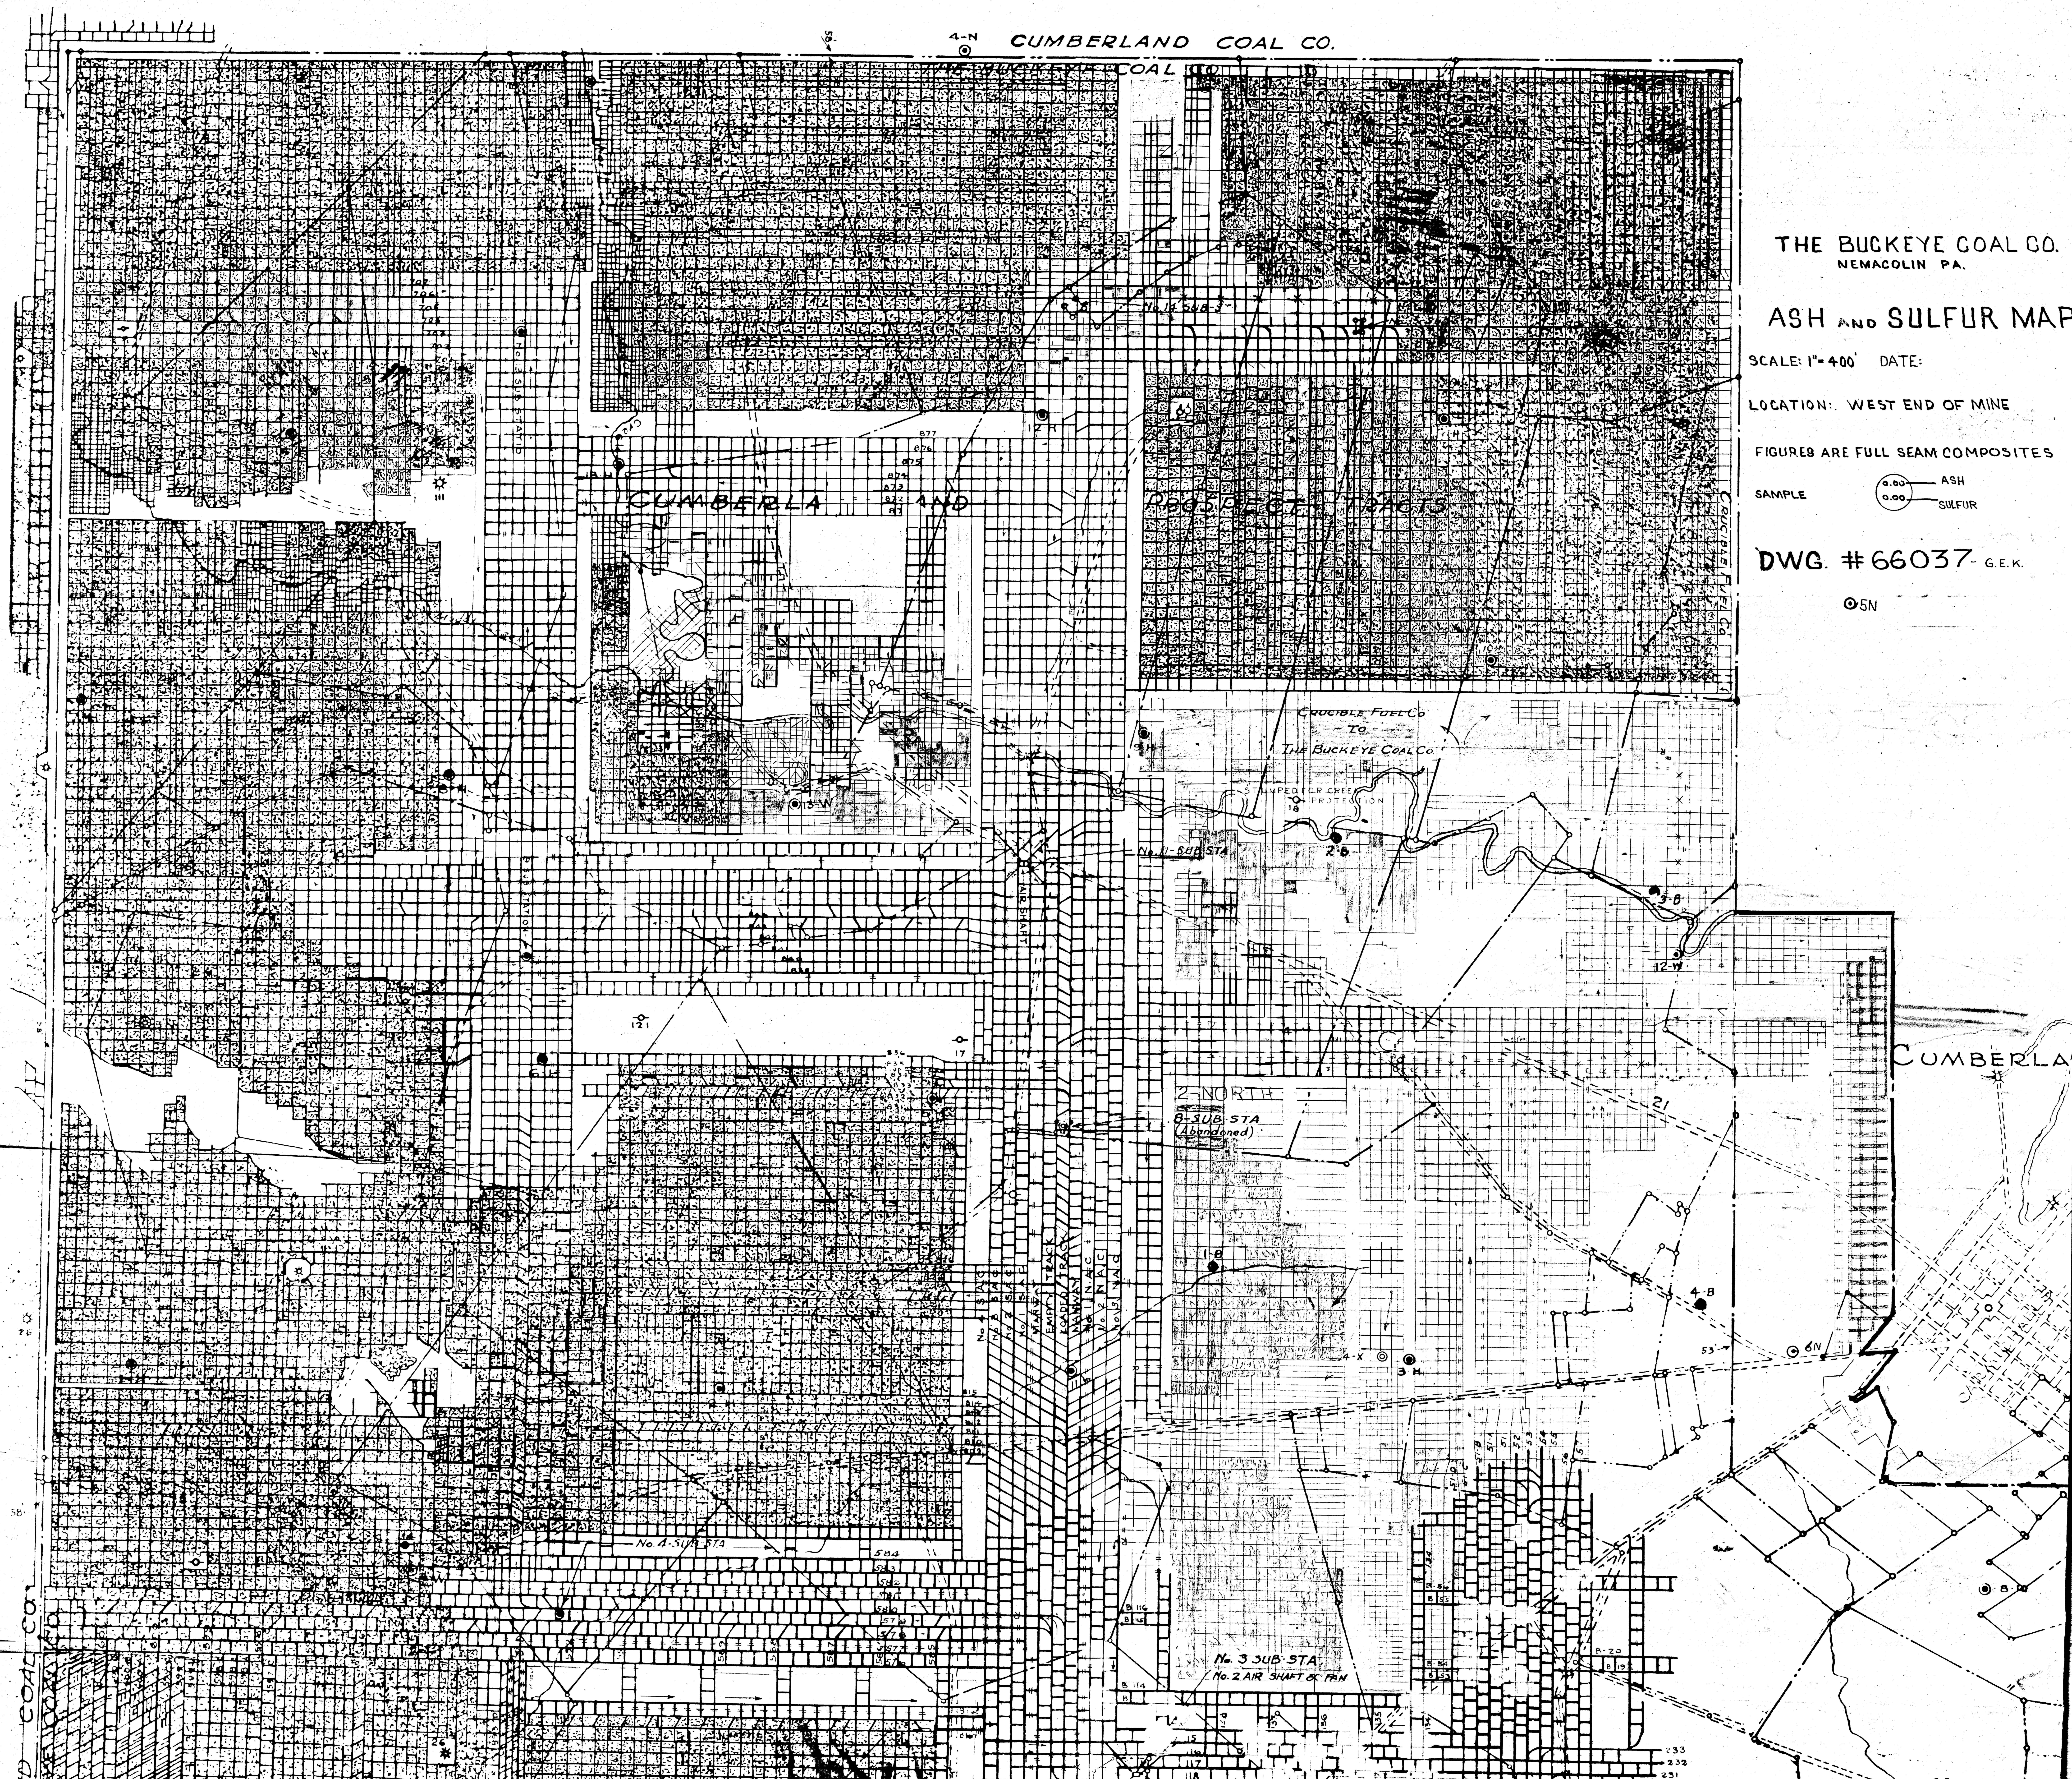
4-N
CUMBERLAND COAL CO.
THE BUCKEYE COAL CO.
CUMBERLA AND
PROSPECT TRACTS
CRUCIBLE FUEL Co
CRUCIBLE FUEL Co
TO
THE BUCKEYE COAL Co
STUMPED FOR CREEK PROTECTION
No. 14 SUB-ST
No. 11 SUB STA
AIR SHAFT
9 SUB STATION
No. 13 SUB STATION
2-NORTH
8-SUB STA
(Abandoned)
No. 3 SUB STA
No. 2 AIR SHAFT & FAN
No. 4 SUB STA
No. 1 S.A.C.
No. 2 S.A.C.
No. 3 S.A.C.
No. 4 S.A.C.
MANWAY
EMPTY TRACK
LOADED TRACK
MANWAY
No. 1 N.A.C.
No. 2 N.A.C.
No. 3 N.A.C.
CUMBERLA
AND COAL CO.
5N
6N
4-B
5-B
3-B
2-B
1-B
3-H
4-X
12-W
13-W
8
17
121
21
53
58
B 114
B 116
B 115
B 17
B 18
B 19
B 20
233
232
231
230
584
583
582
581
580
579
578
577
576
877
876
875
874
873
872
871