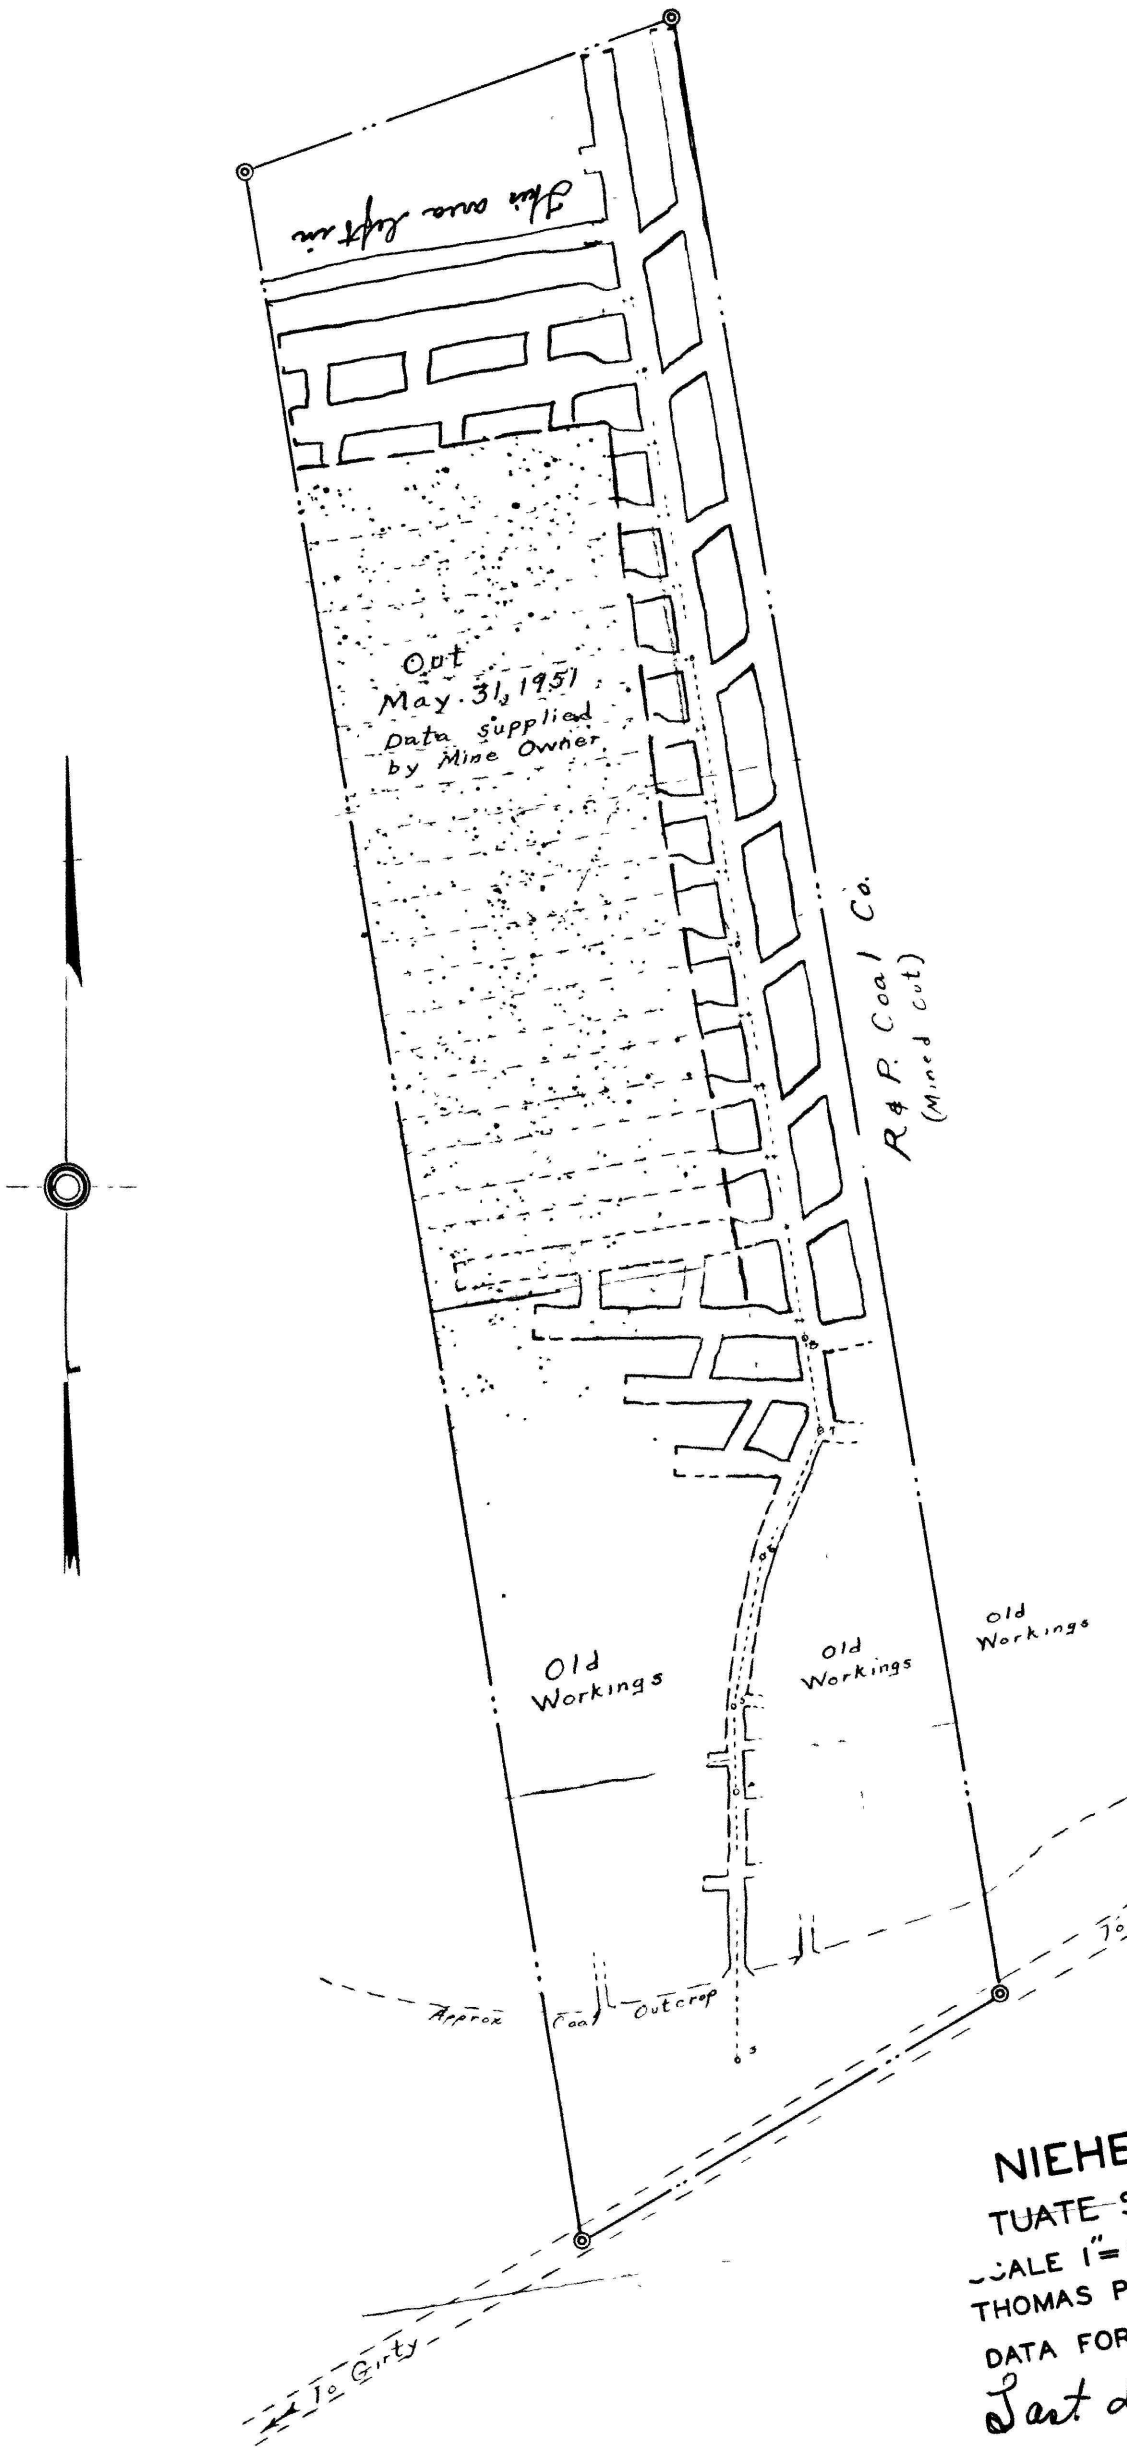

MAP OF
NIEHENKE MINE No. 1
TUATE ~~SOUTH BEND~~ TWP., ARM. ~~CO.~~
SCALE 1" = 100'
MAY 31, 1951
THOMAS PEALER, REG. PRO. ENGR.
DATA FOR MAP SUPPLIED BY OWNER
Last day operated March 30, 1953

#1922
12-21-99
C.C.

31 5/H