


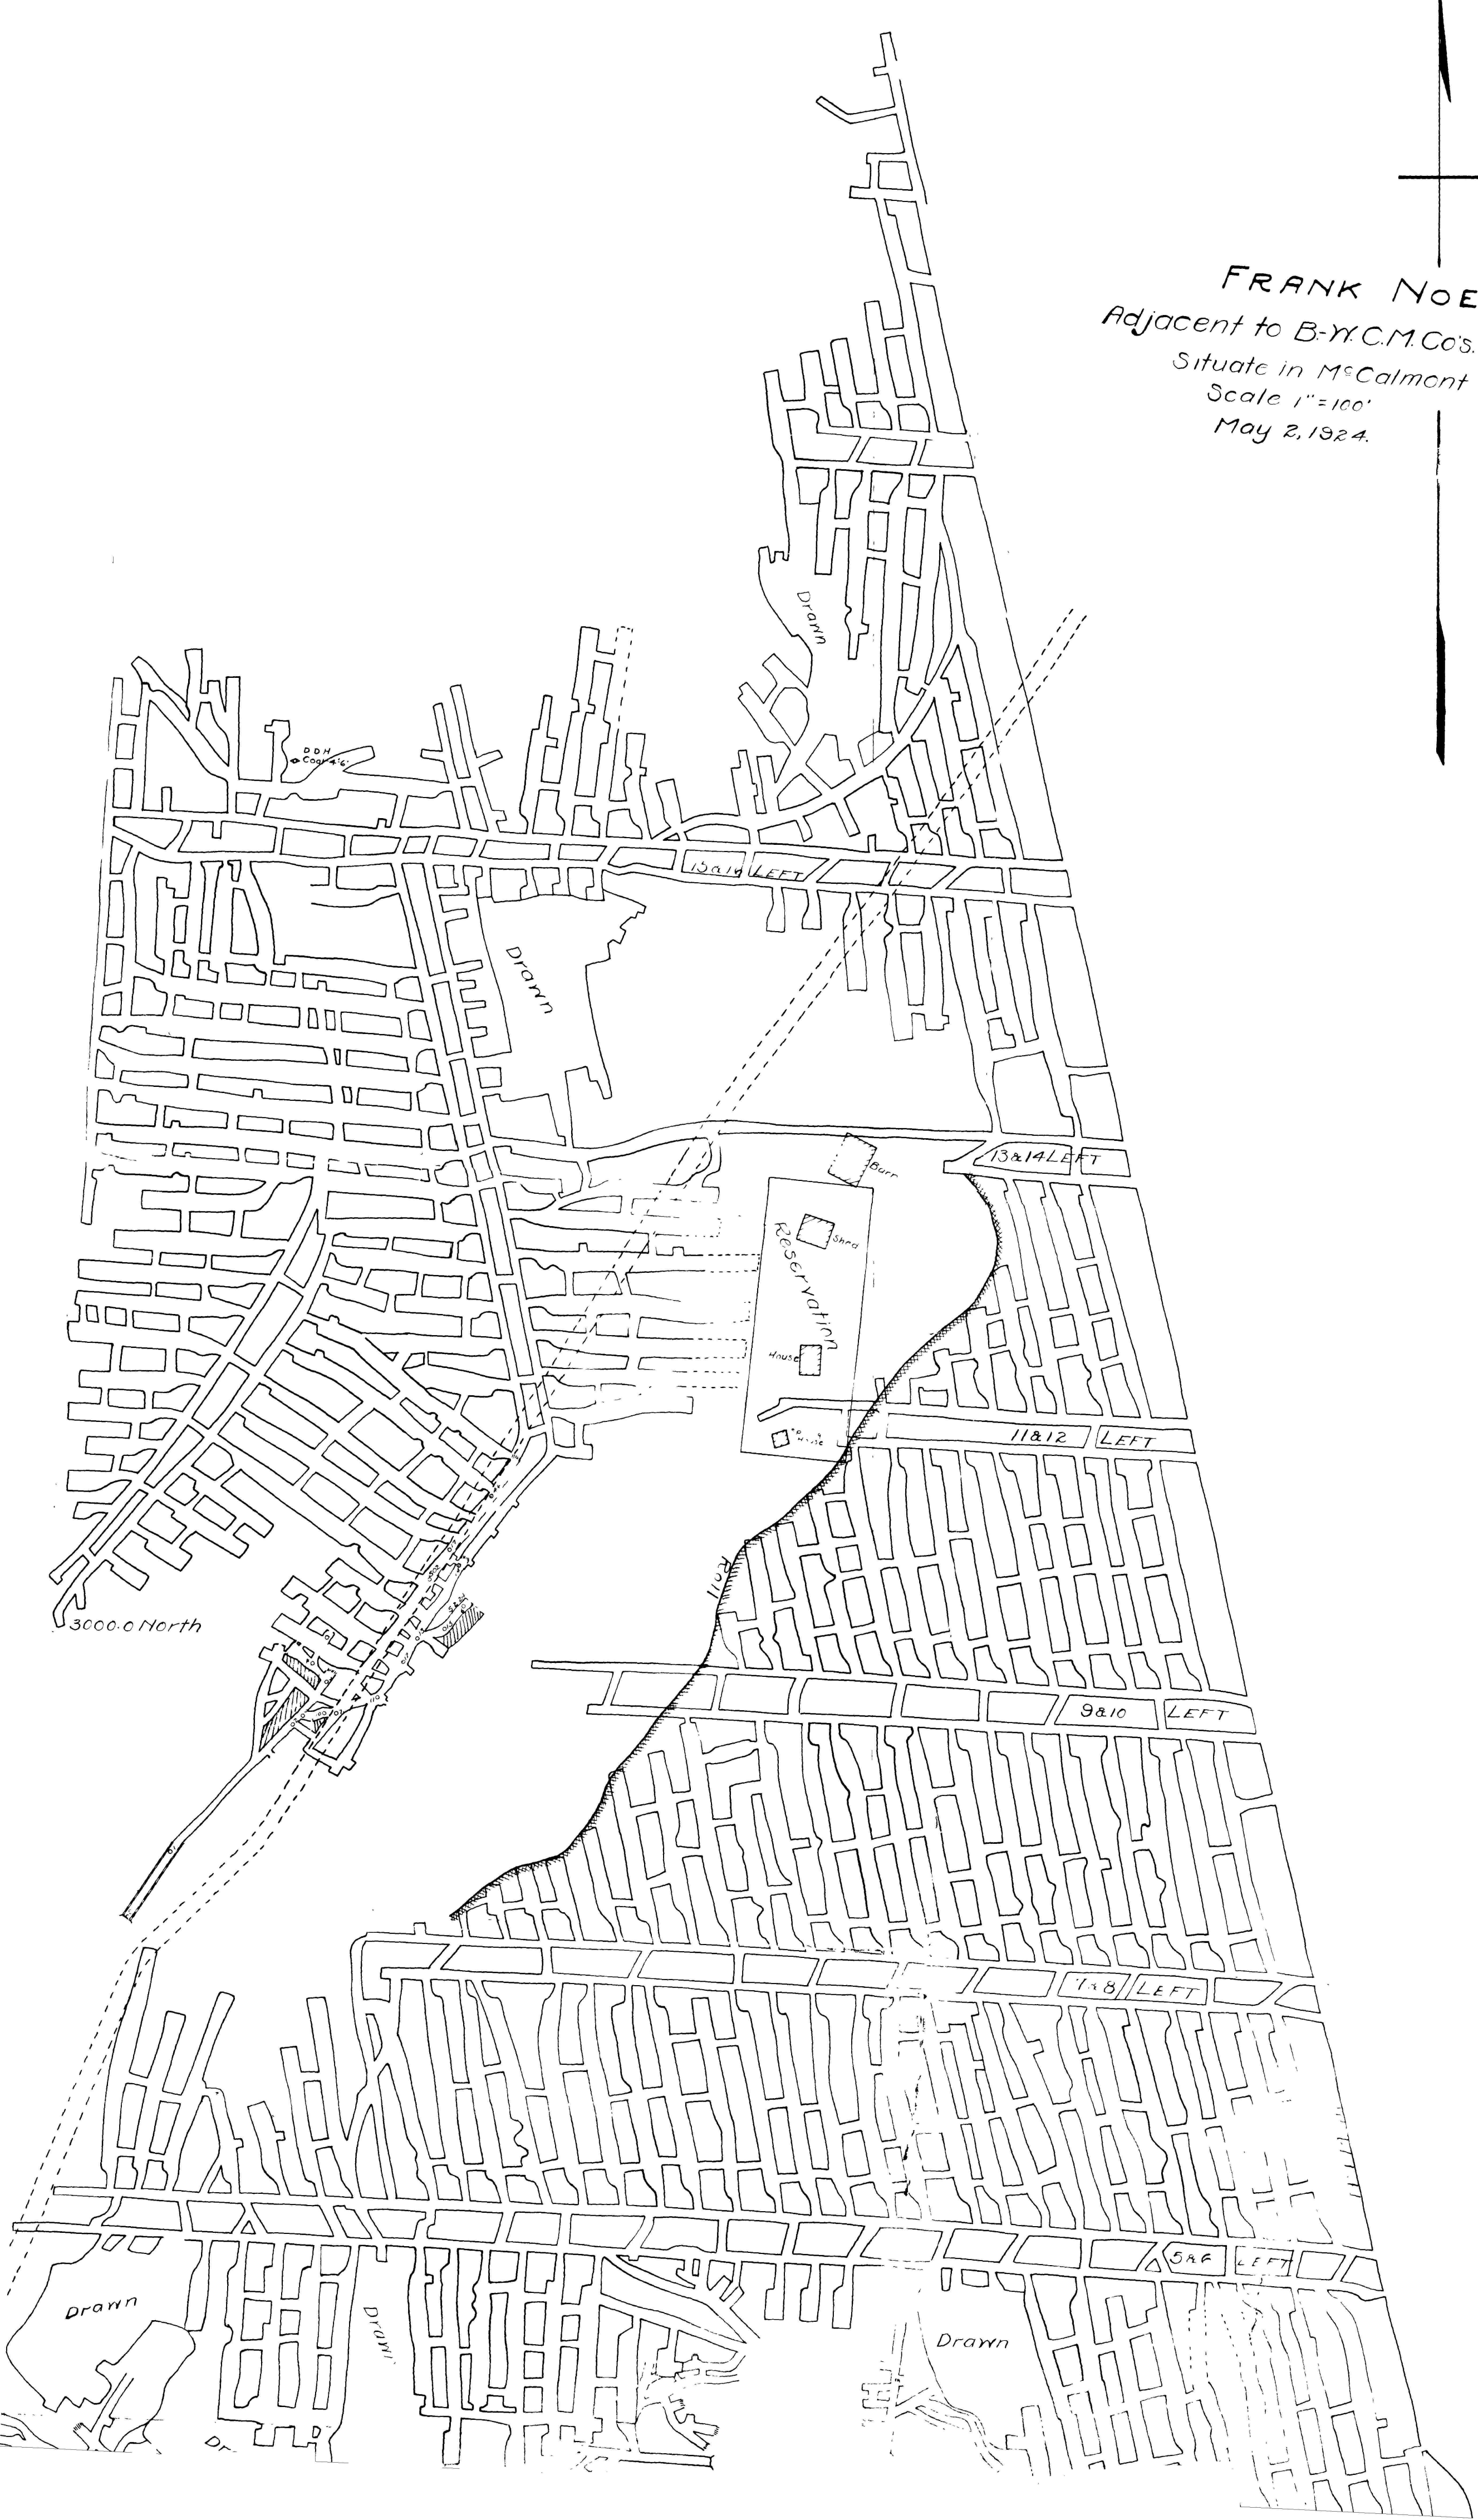

FRANK NOERR MINE
Adjacent to B.M.C.M. Co's. West Eureka No. 11
Situate in McCalmont Twp. Jeff. Co., Pa.
Scale 1"=100'
May 2, 1924.
H.M. Kanarr.
Eng'r.
Punxsutawney, Pa.