


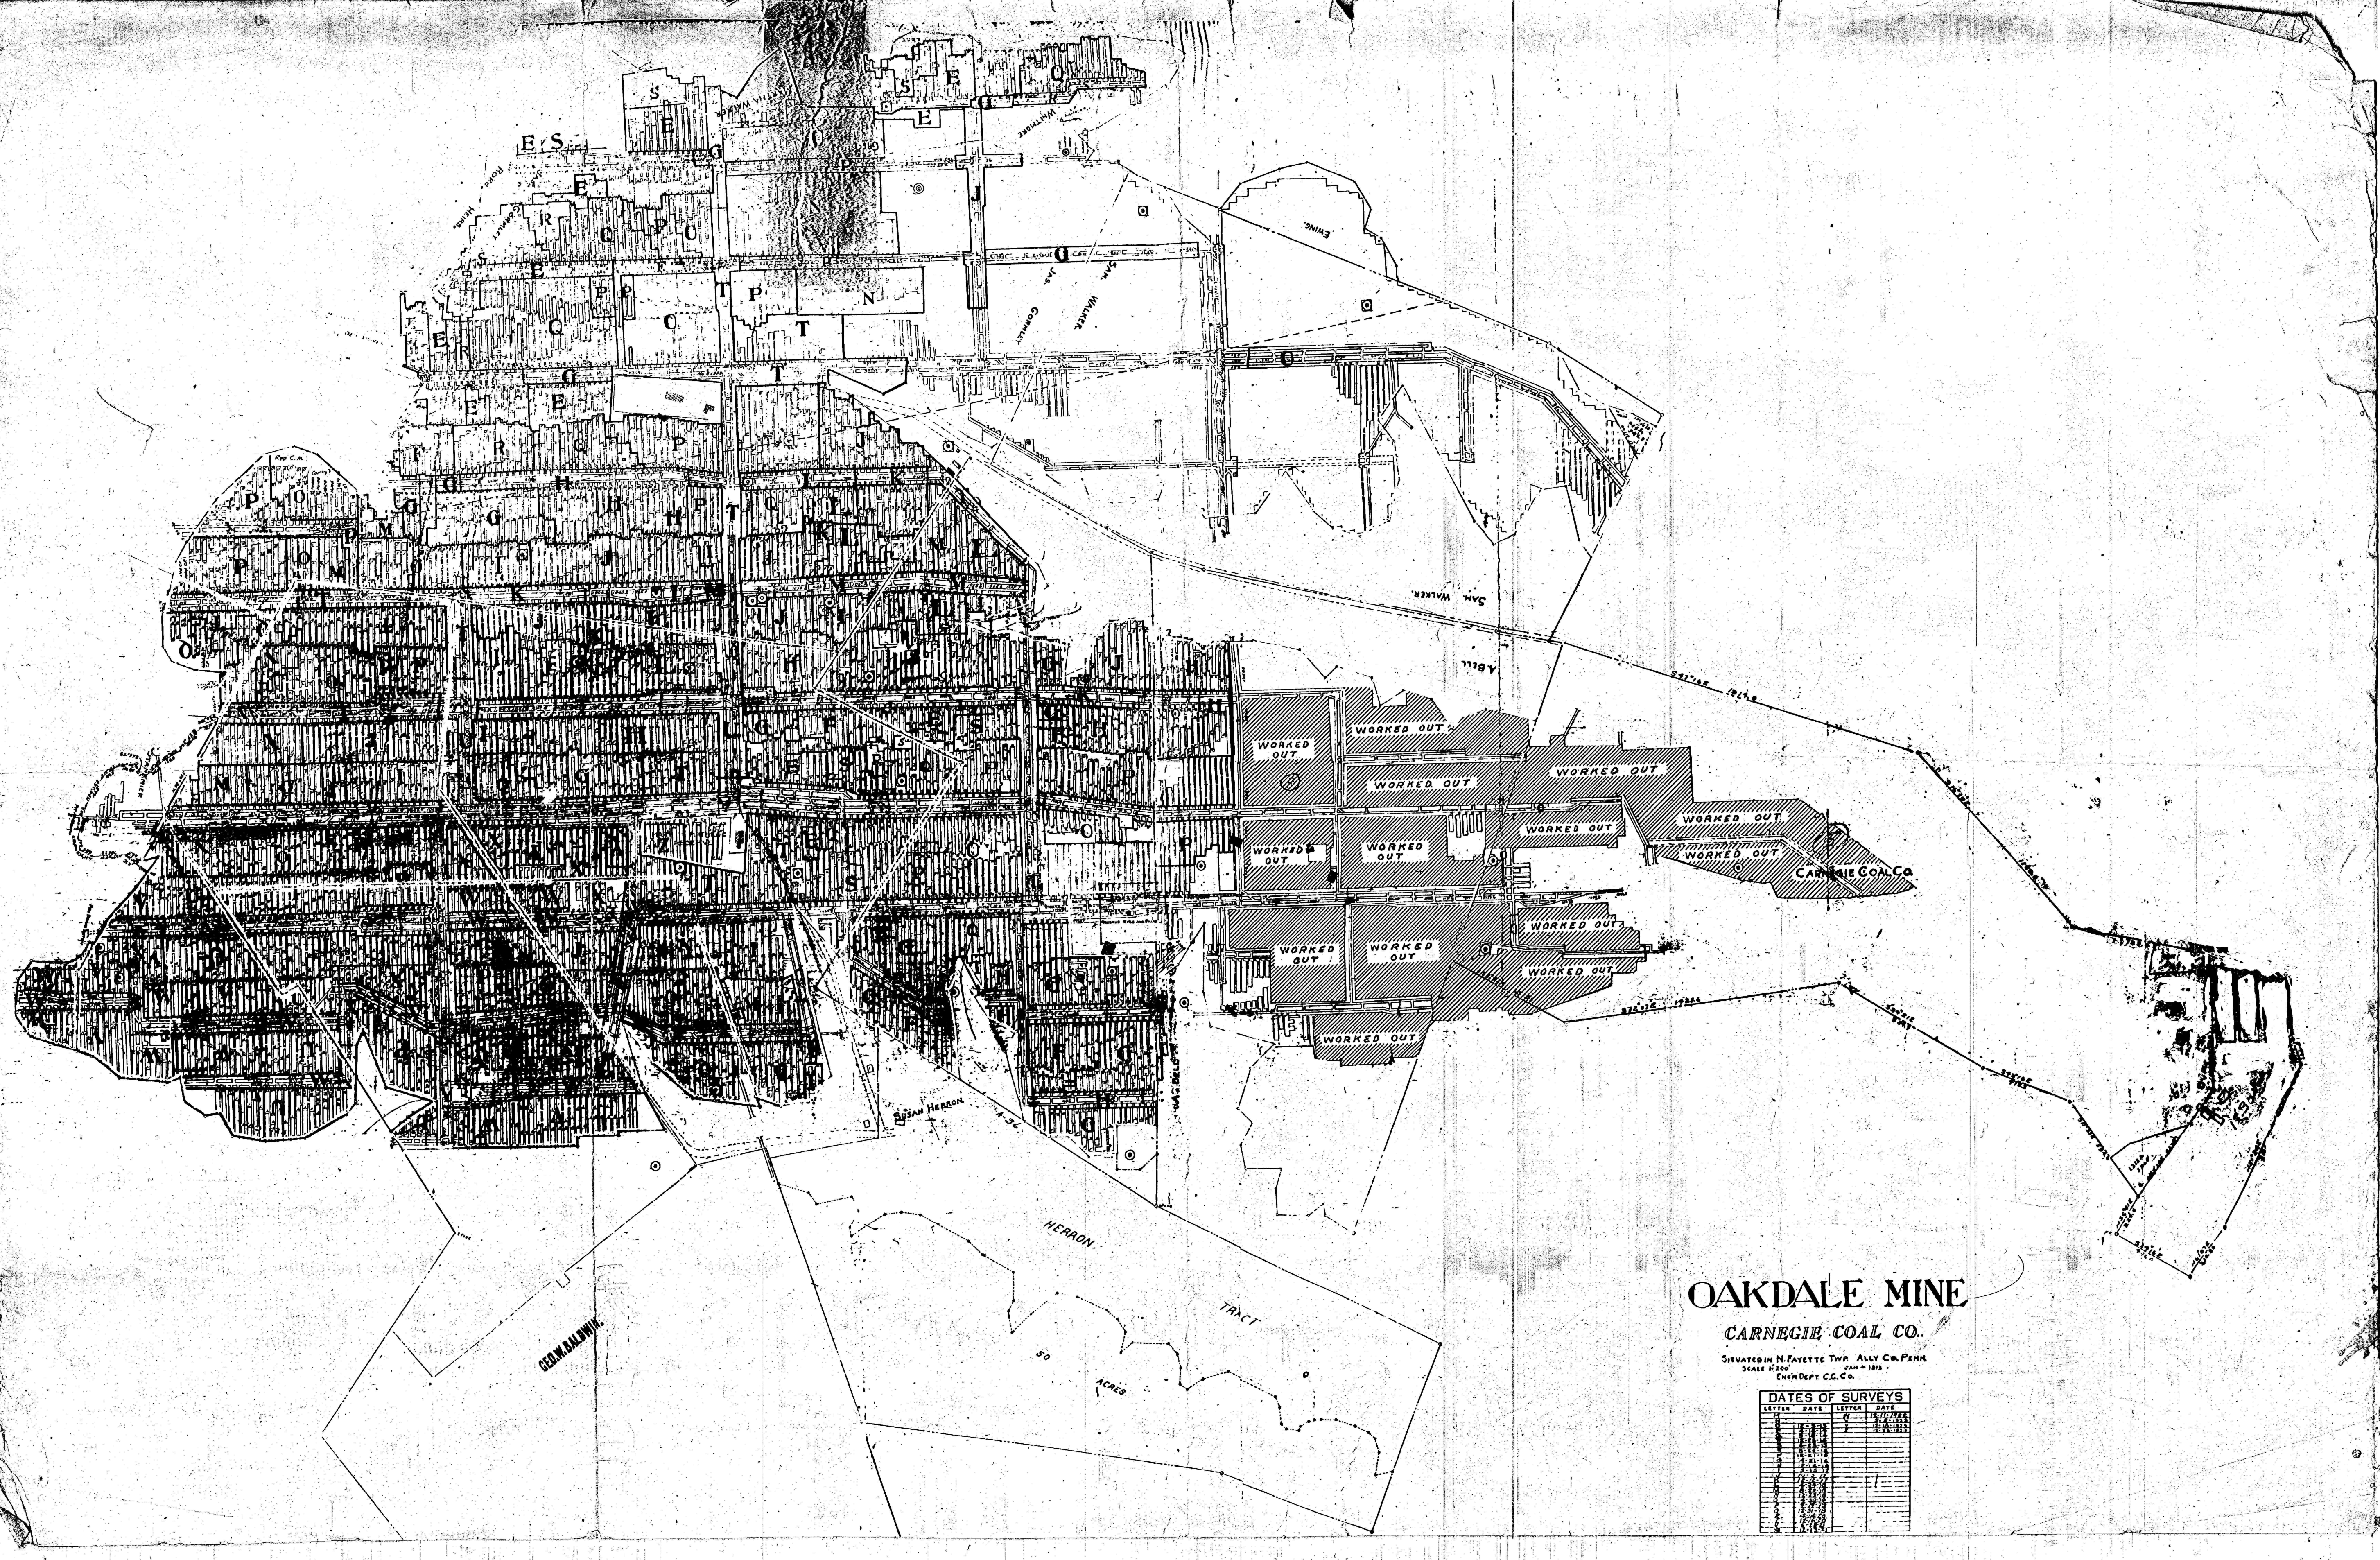

OAKDALE MINE

CARNEGIE COAL CO.

SITUATED IN N. FAYETTE TWP. ALLEY CO. PENN.
SCALE 1/2" = 100' JAN - 1913
ENGR DEPT. C.C. CO.

DATES OF SURVEYS			
LETTER	DATE	LETTER	DATE
