


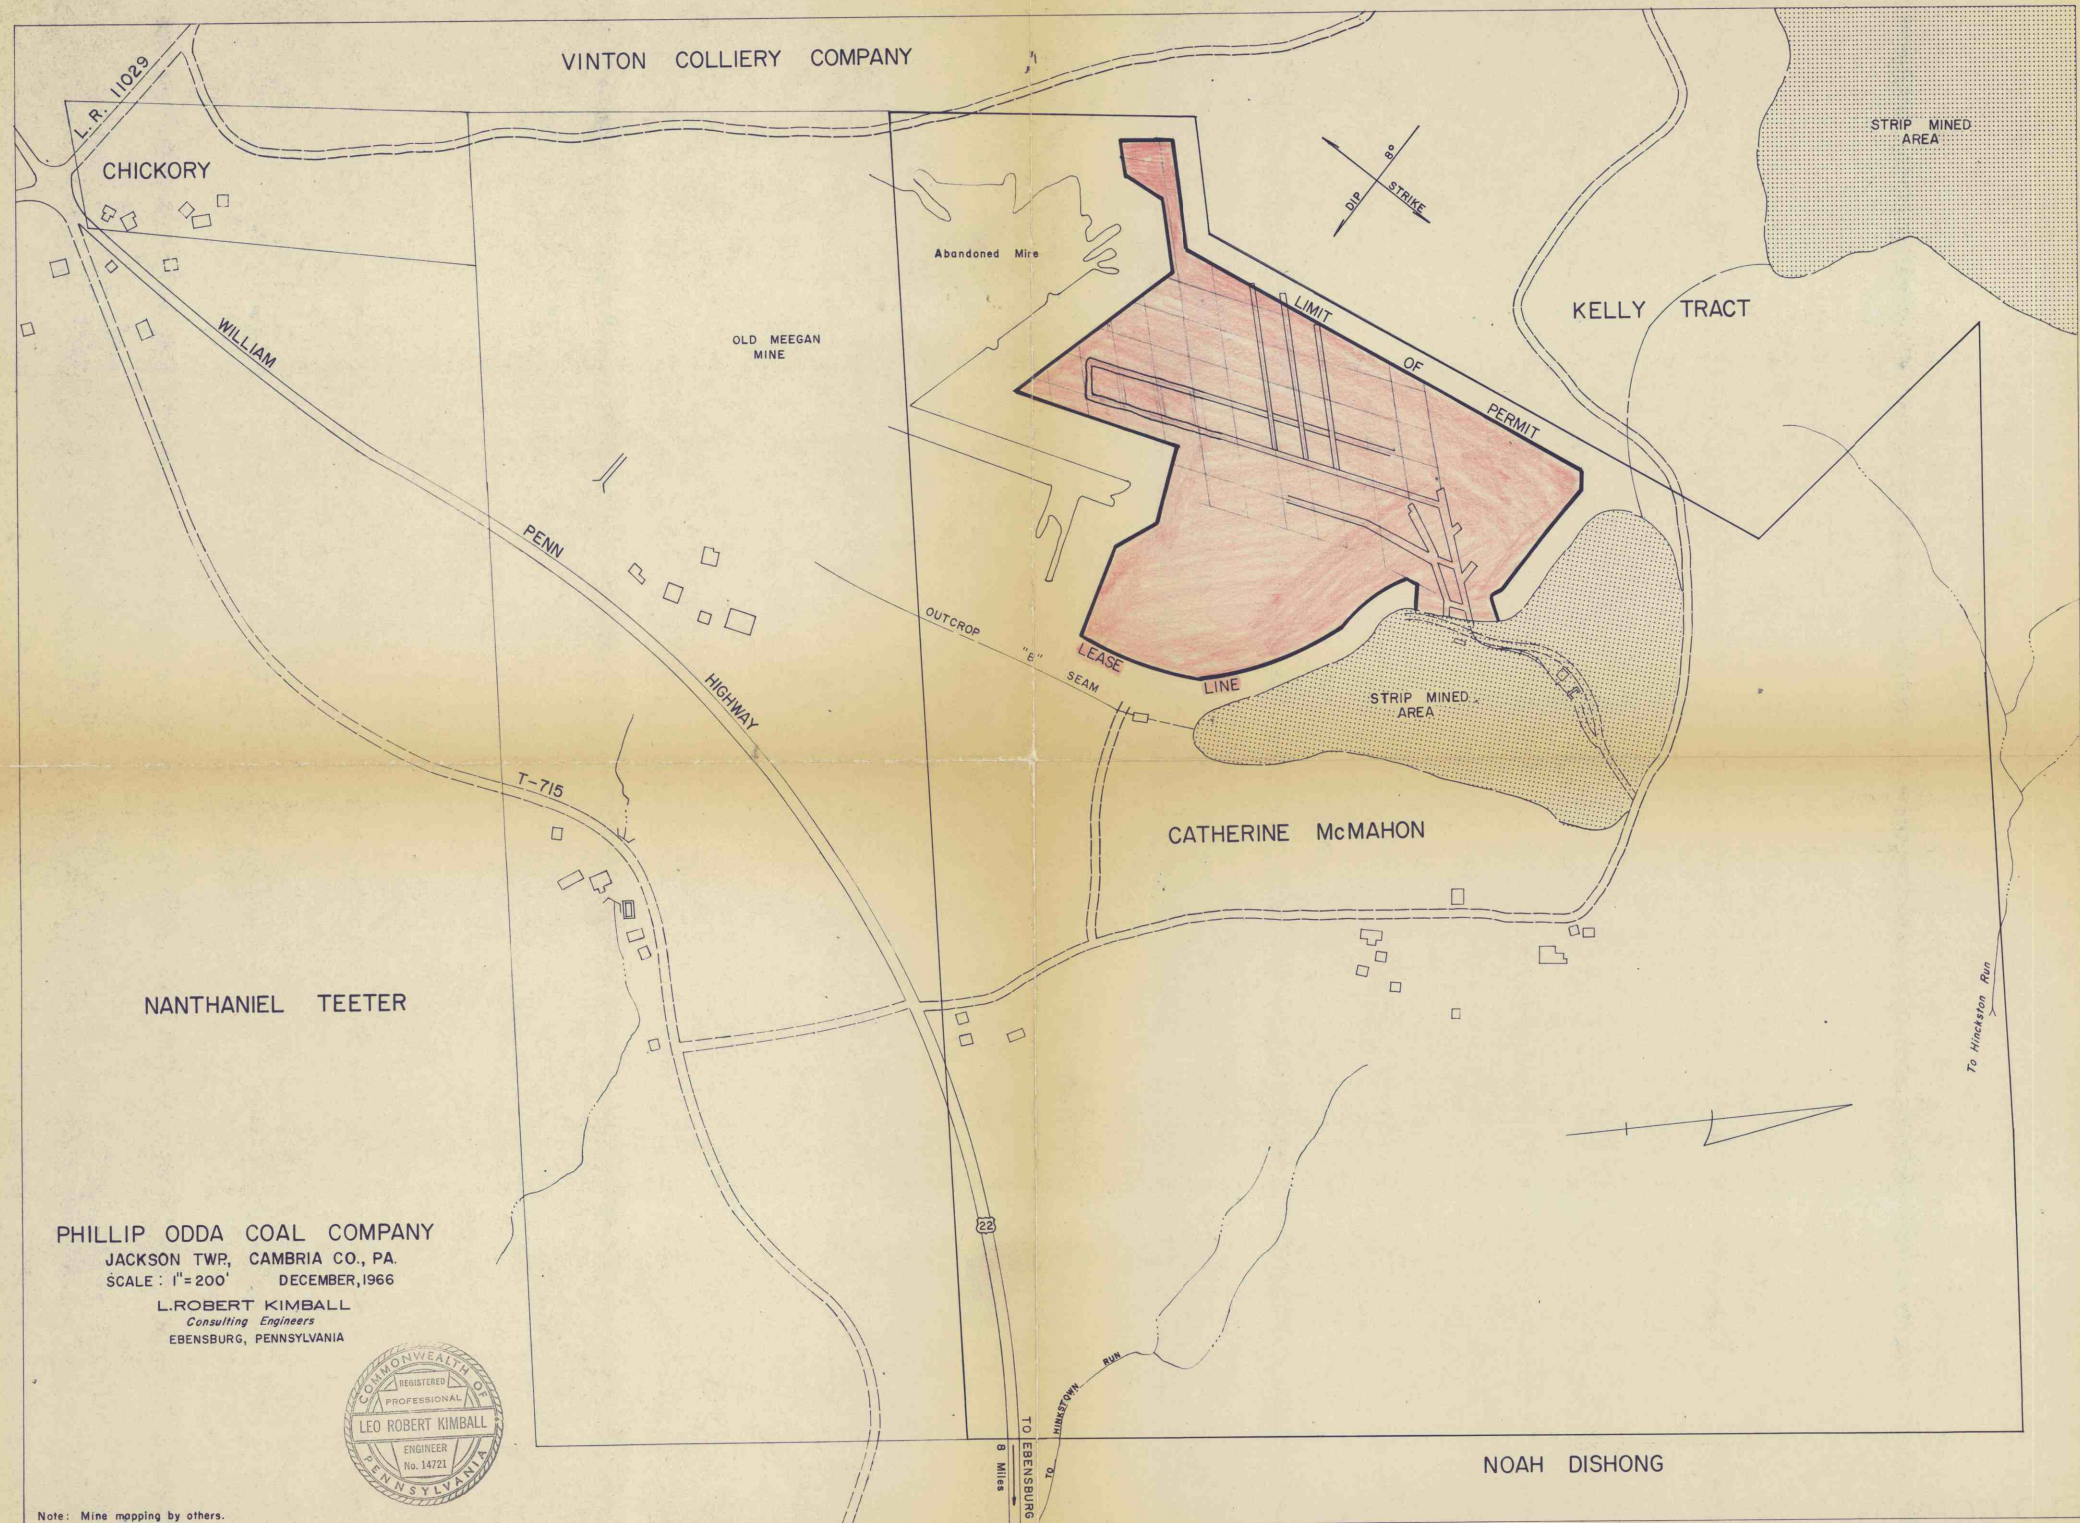

VINTON COLLIERY COMPANY

CHICKORY

WILLIAM

OLD MEEGAN MINE

Abandoned Mine

DIP STRIKE
8°

KELLY TRACT

STRIP MINED AREA

PENN

HIGHWAY

T-715

OUTCROP

"E" SEAM

LEASE LINE

STRIP MINED AREA

CATHERINE McMAHON

NANTHANIEL TEETER

PHILLIP ODDA COAL COMPANY

JACKSON TWP, CAMBRIA CO., PA.

SCALE: 1"=200' DECEMBER, 1966

L. ROBERT KIMBALL
Consulting Engineers
EBensburg, PENNSYLVANIA



Note: Mine mapping by others.

NOAH DISHONG

To Hinckston Run

22

8 Miles

TO EBERSBURG

TO

HINCKSTON RUN

#1956
12-27-99
C.C.