


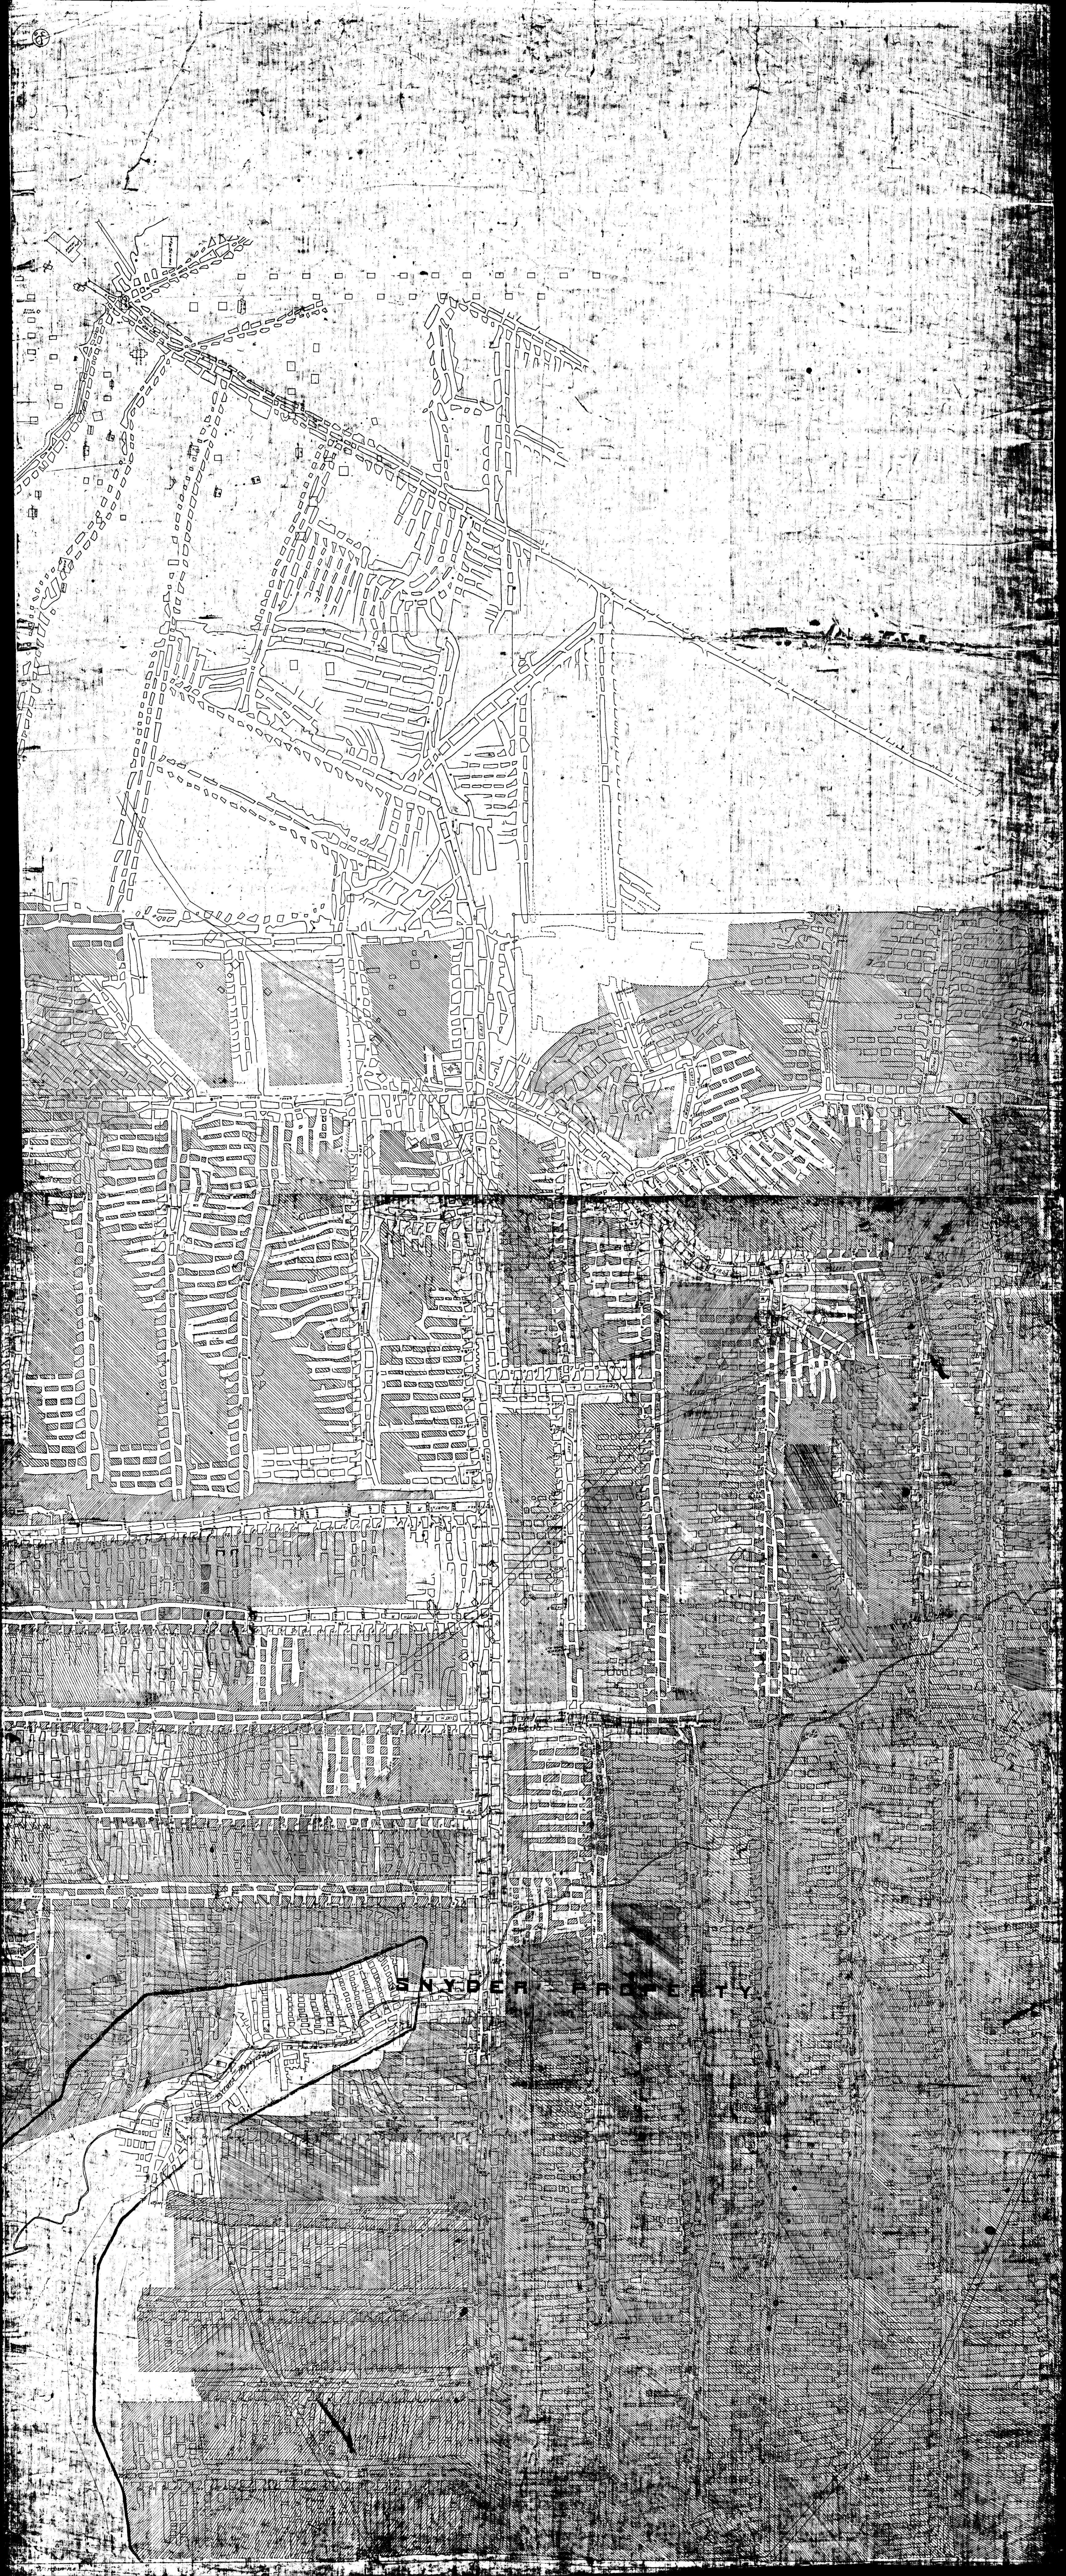

SNYDER PROPERTY