Part of
Ogle No. 1
P.P.&K.-B Seam
3/4 Mile North of
Winburne Sta.
Philipsburg 2 Quad.

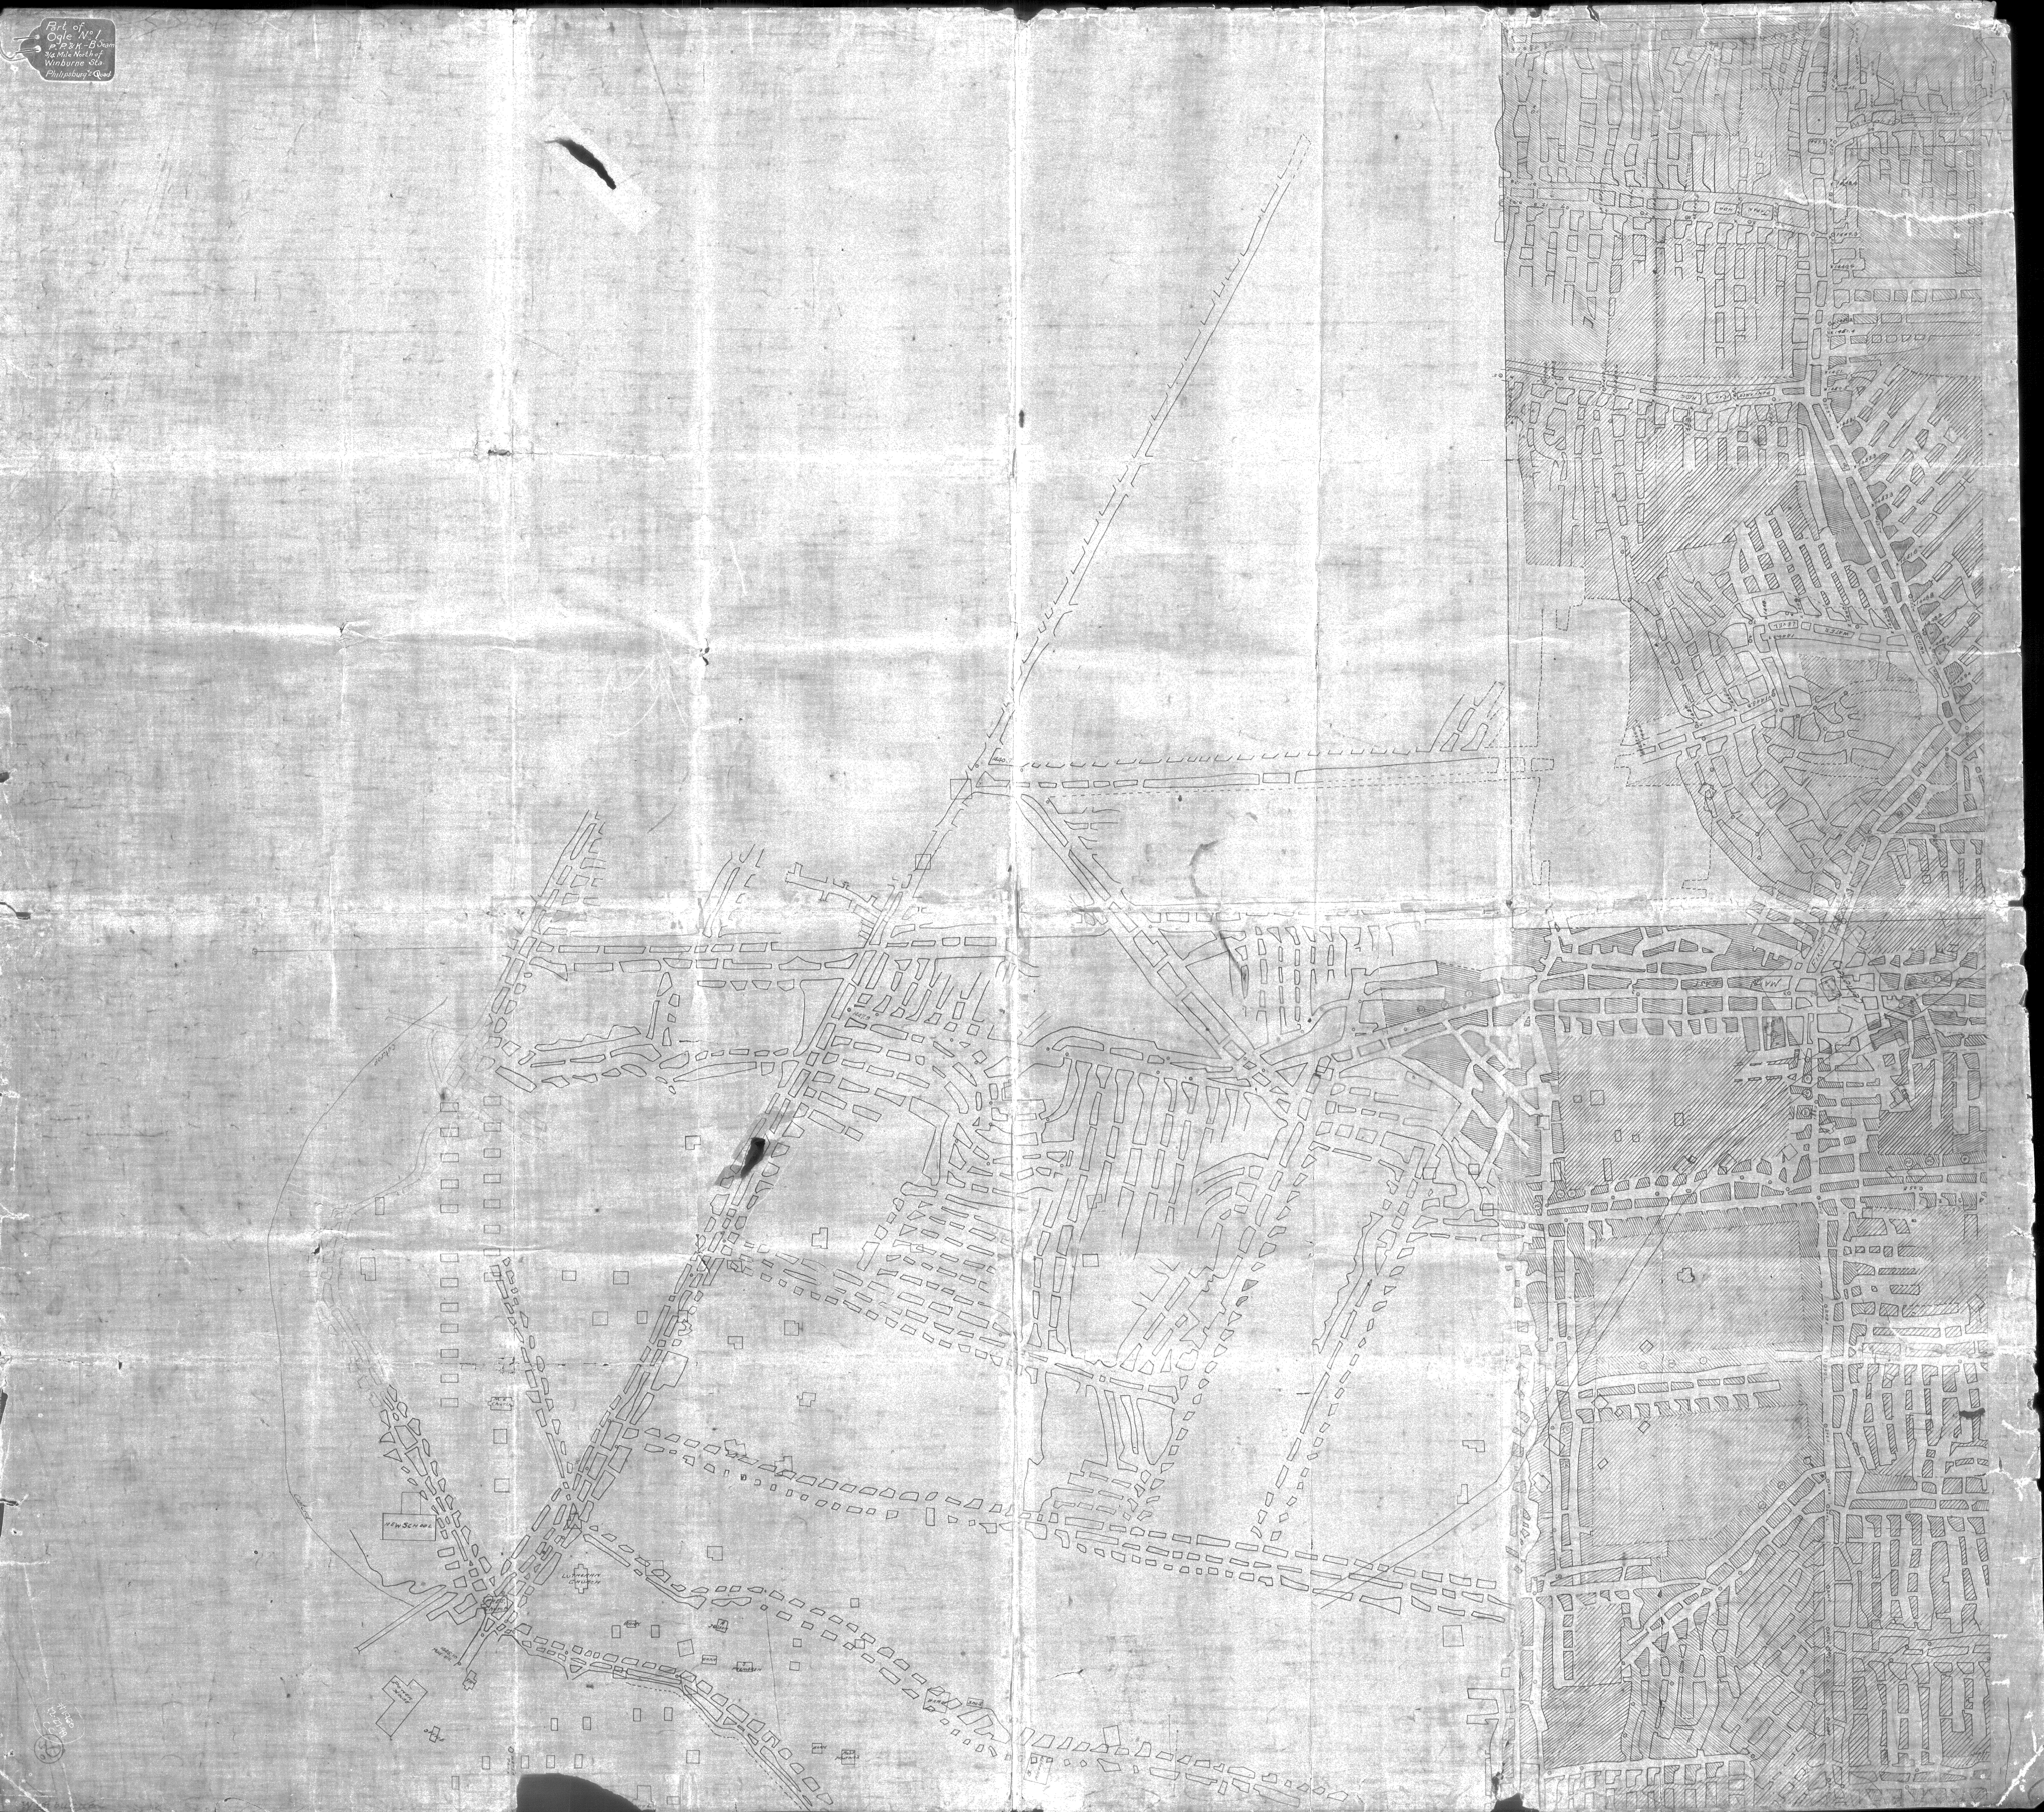
NEW SCHOOL
LUTHERAN CHURCH
M.E. CHURCH
PRES. CHURCH
POWER HOUSE
OFFICE
BARN
BARN
BARN
Outcrop
#1460
12-27-99
C.C.