



JACKSON HOOVER

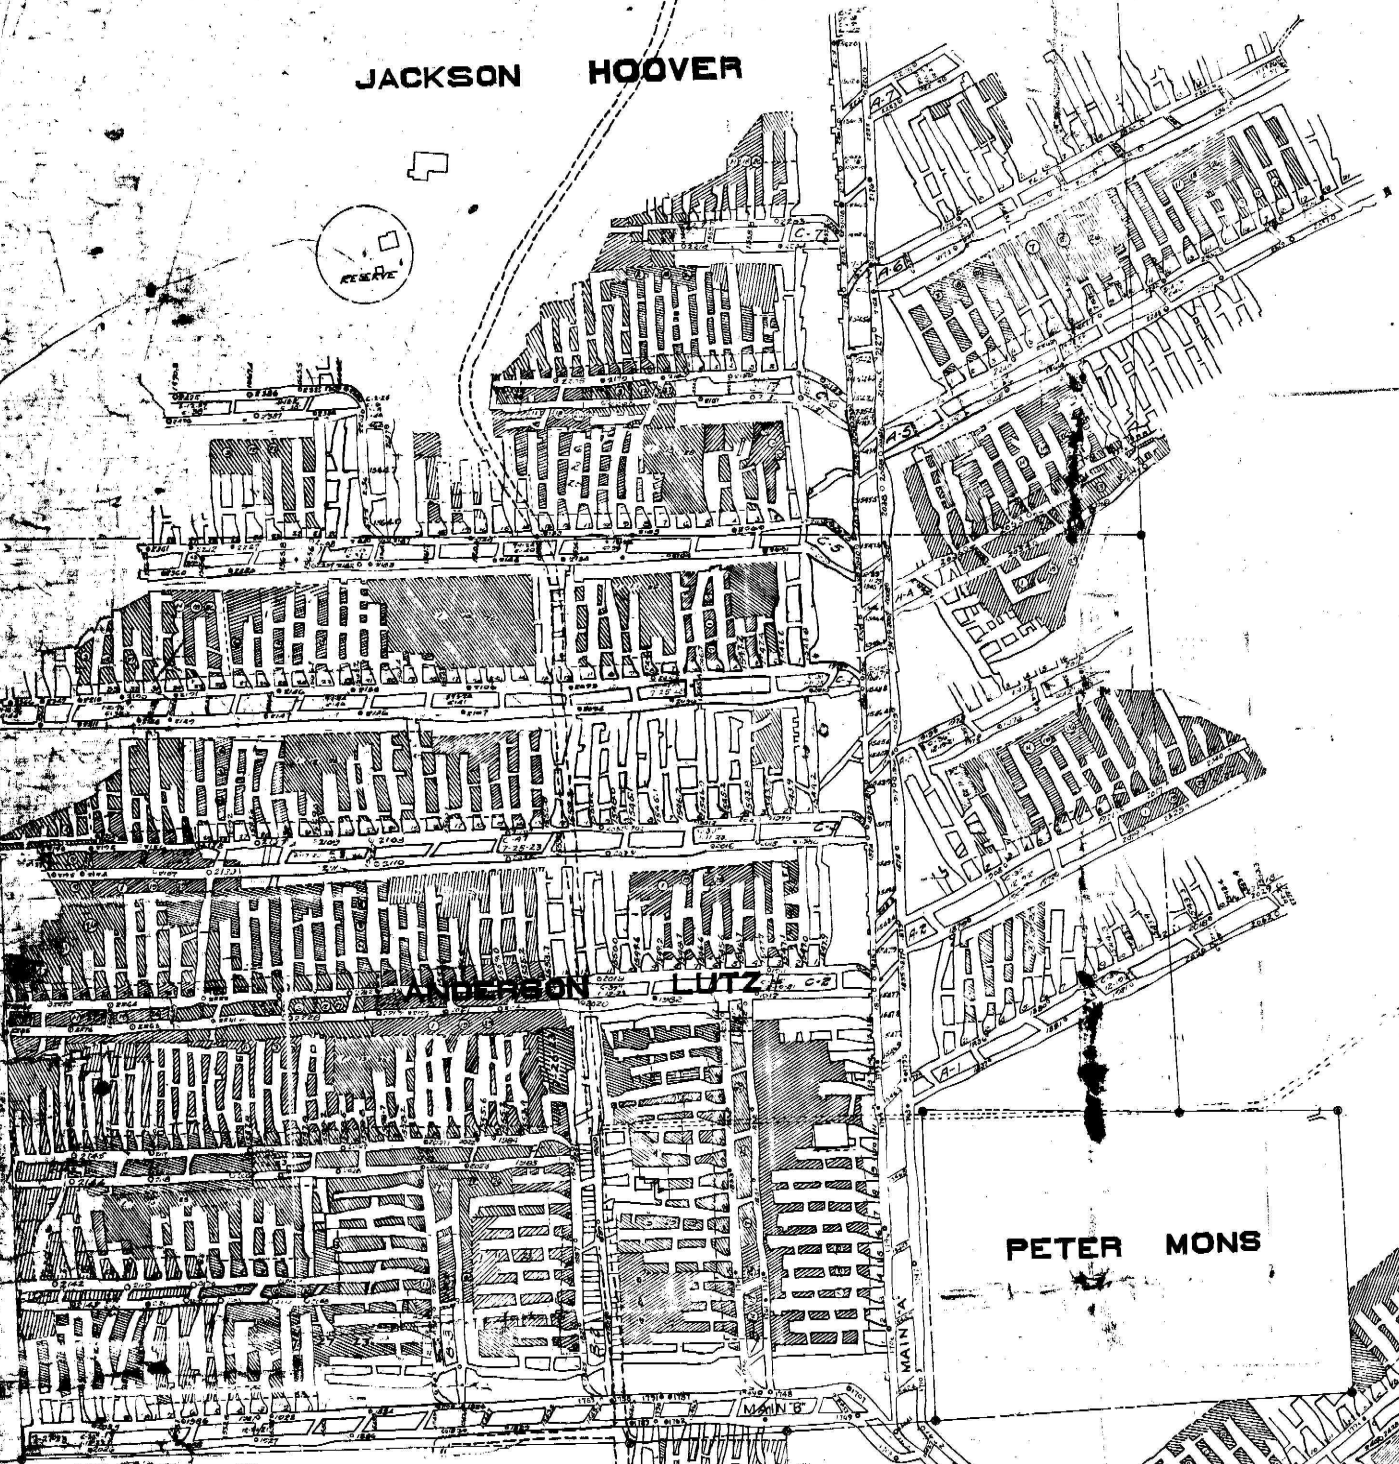

PETER MONS


JOS. POTTER

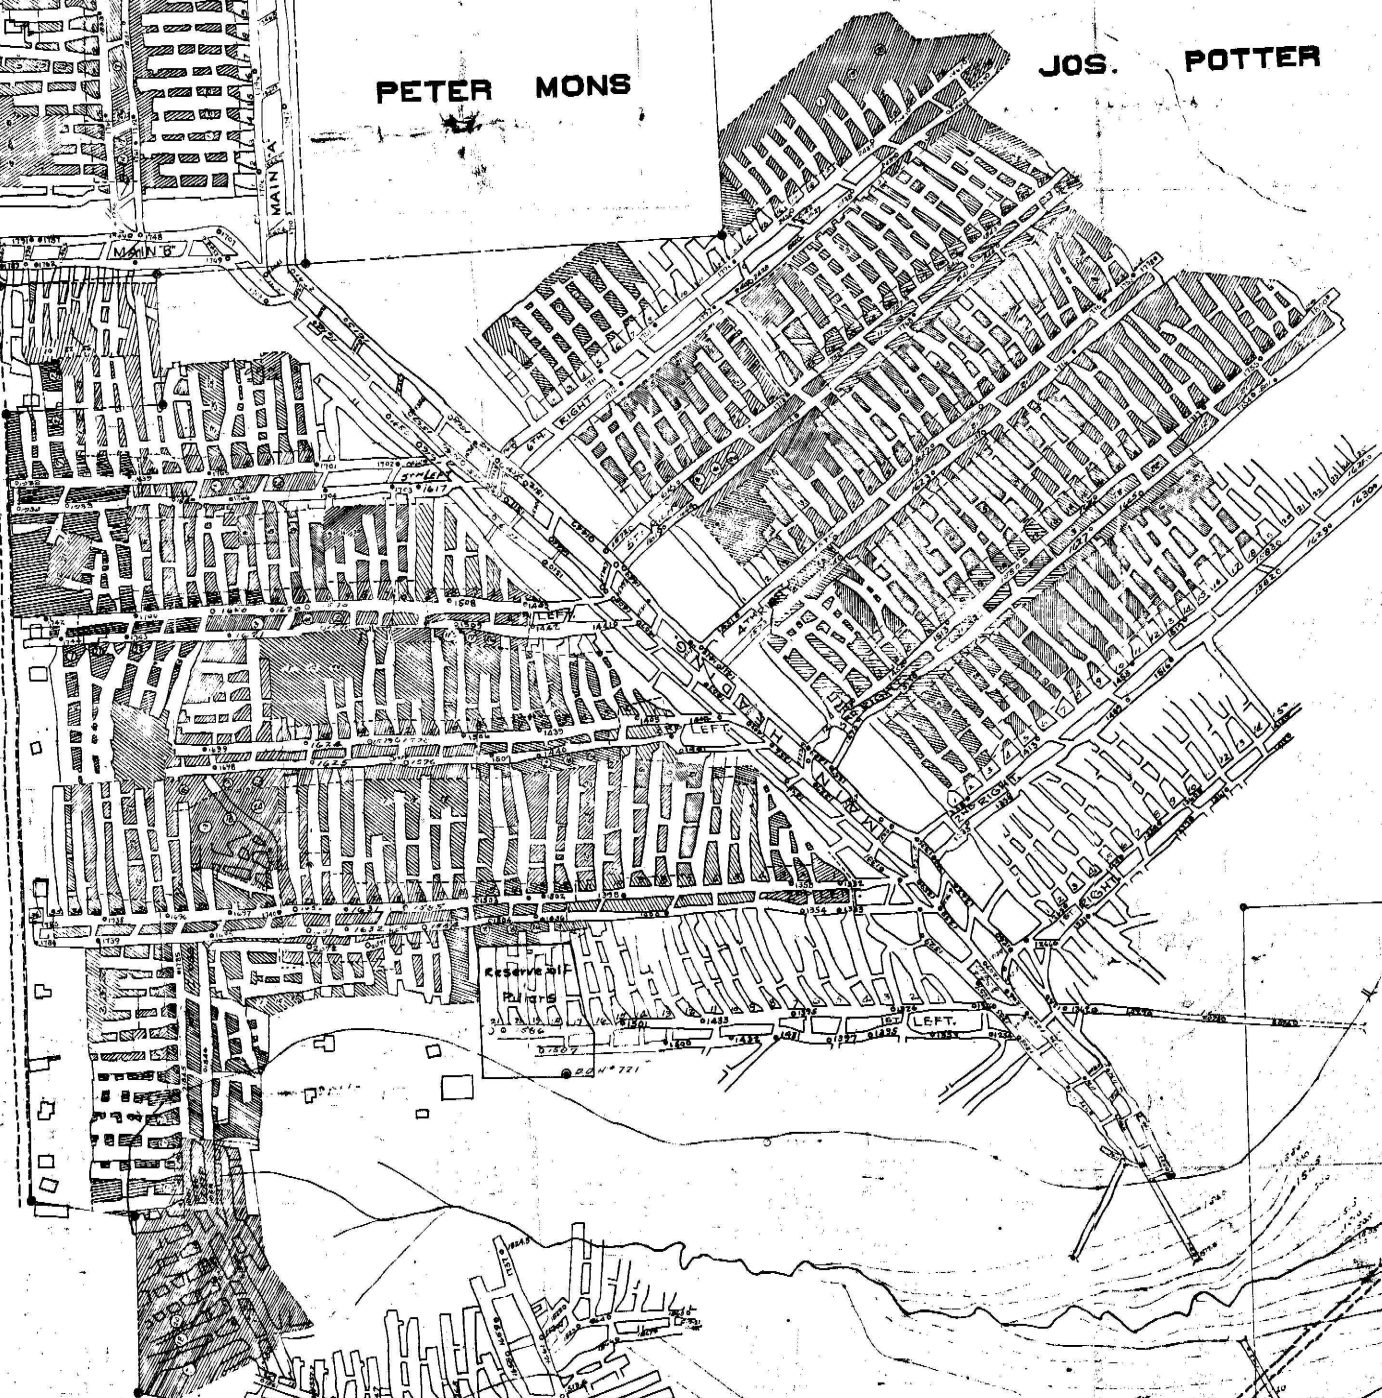

HUGHES HEBS



HIRAM GRANTZ

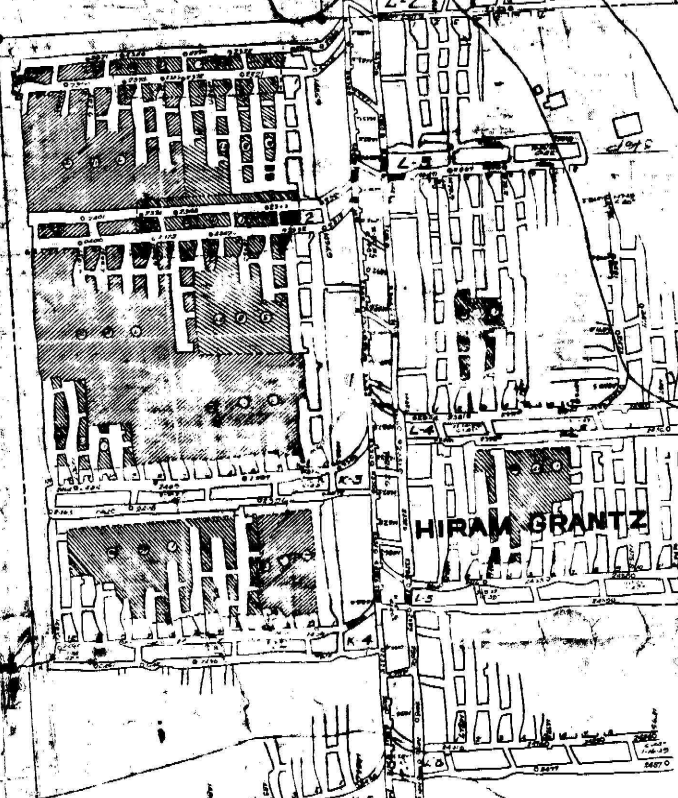

C. B. CO.

THOMAS KYLER

RESERVATION

Q

SURFACE PURCHASES
DOLE