


C B C COMPANY

C B C COMPANY

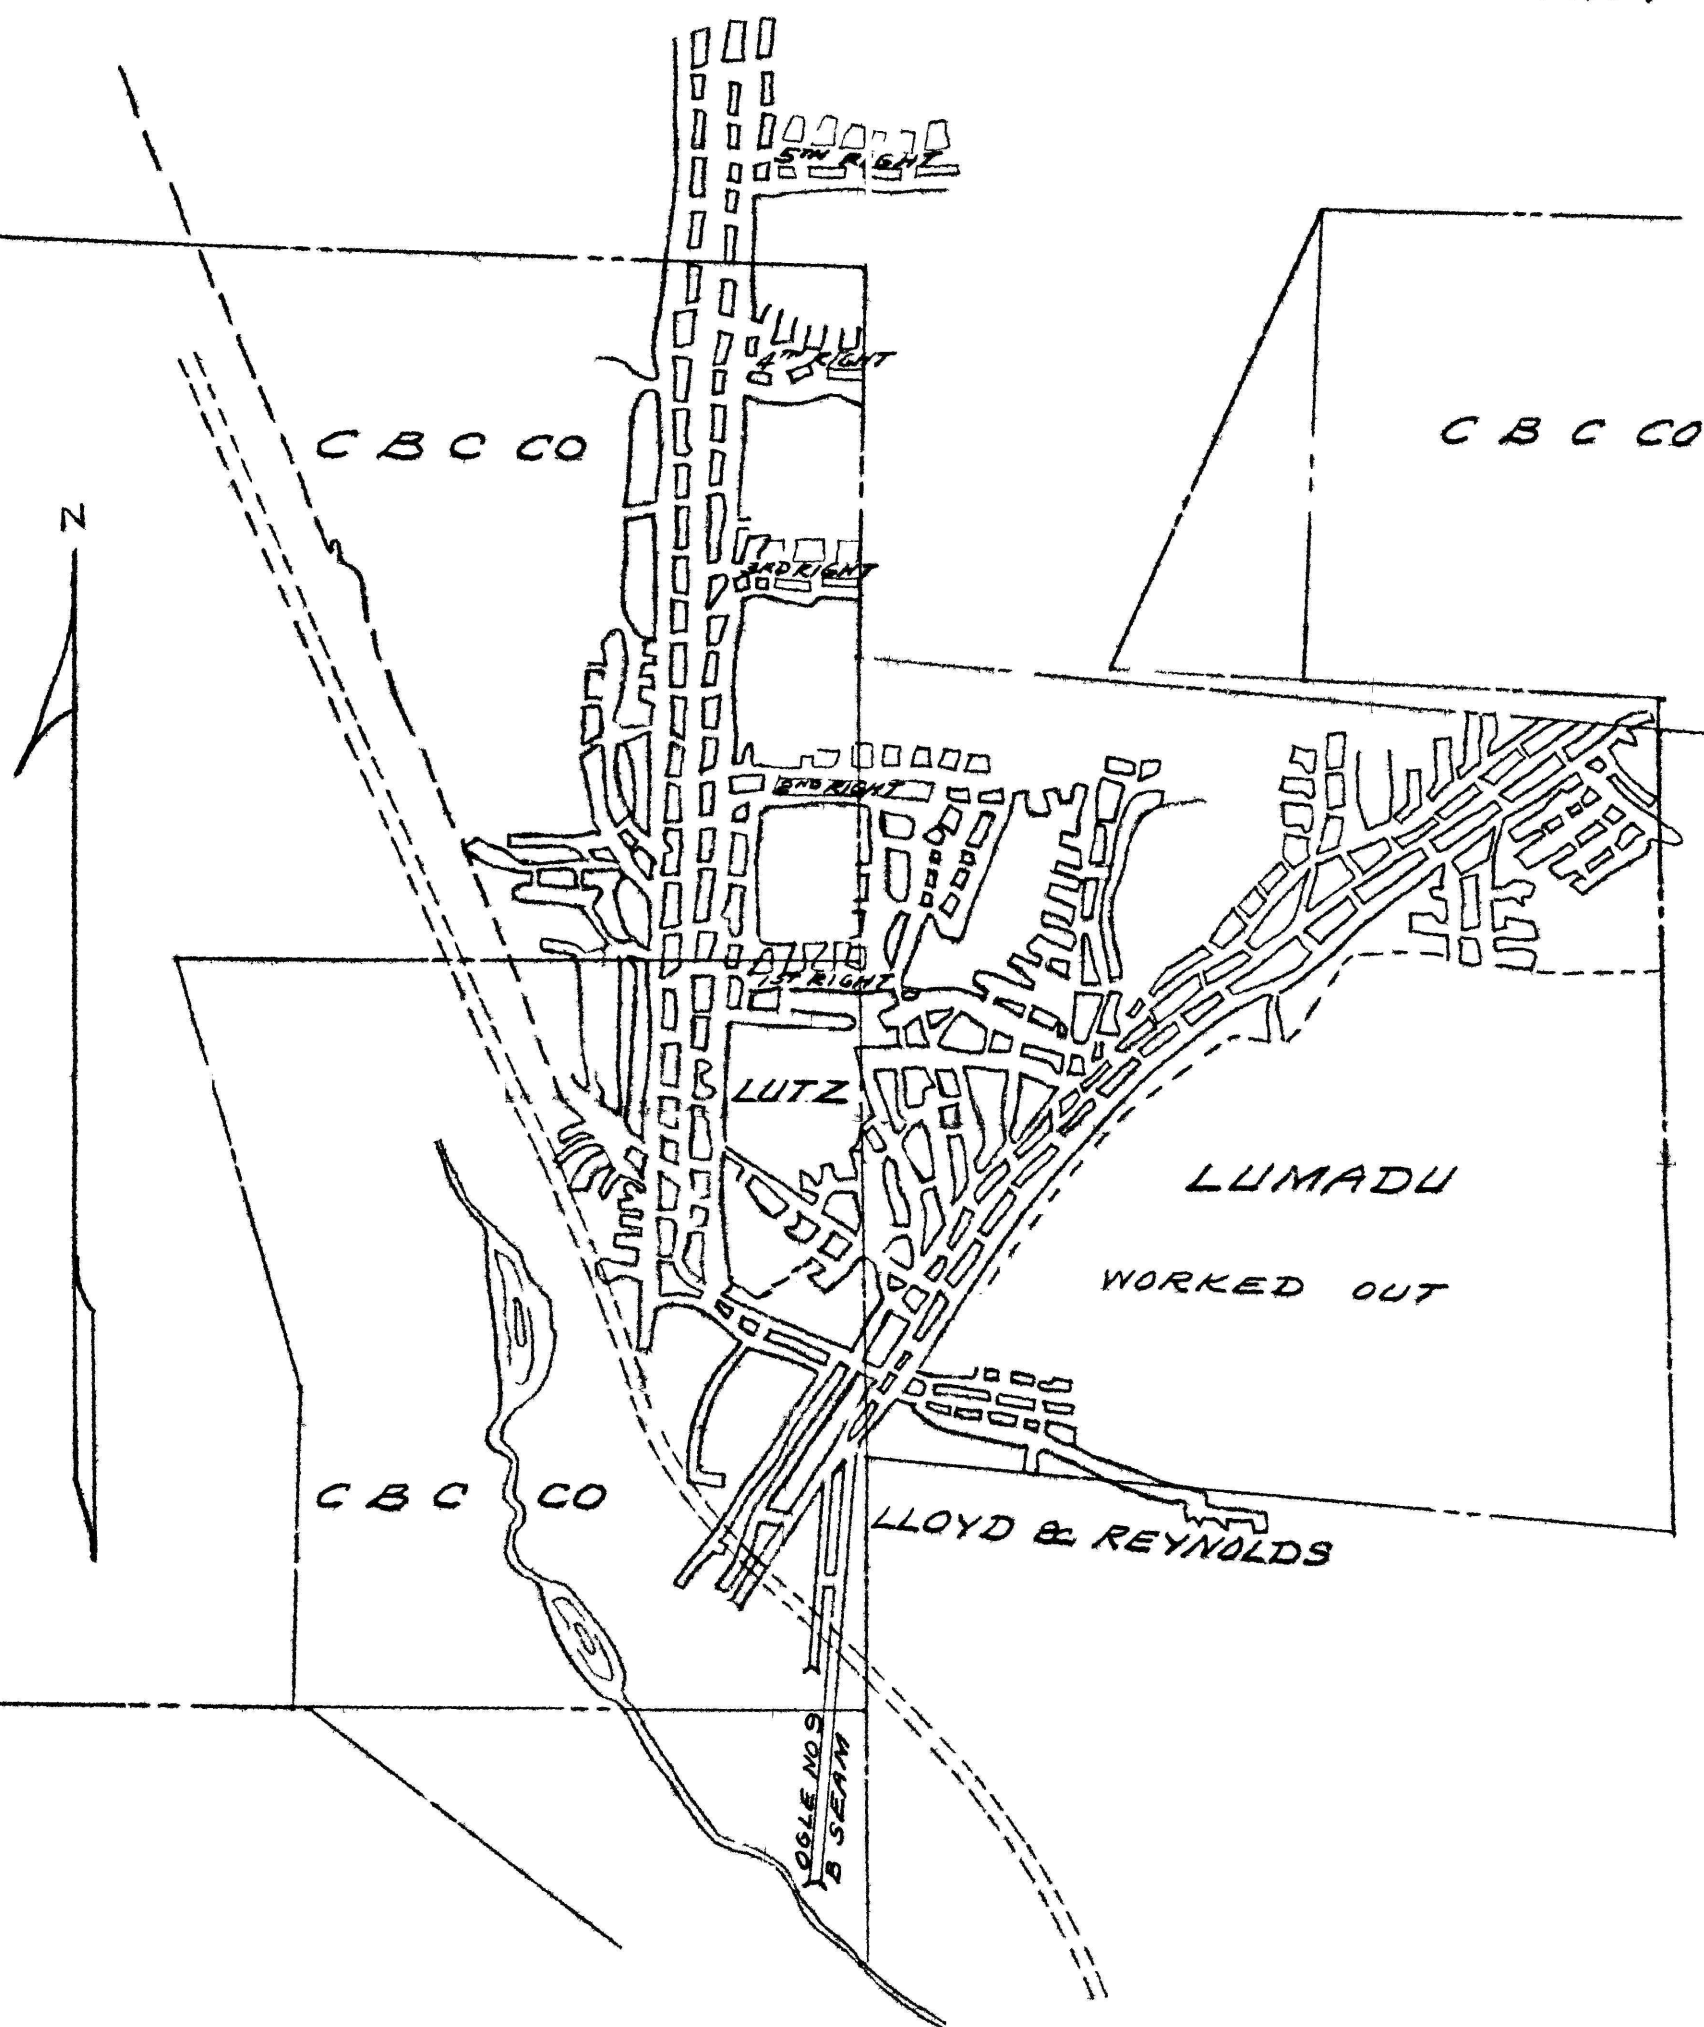

— MAP SHOWING PORTION OF OGLE NO 9 MINE —
— OPERATED BY K & R COAL COMPANY —
— COOPER TWP CLEARFIELD COUNTY PENNA —
— SCALE 1" = 200' — — OCT 3, 1957 —
— BERNARD LUCAS ASSOC —