


12/23/99
C.C.

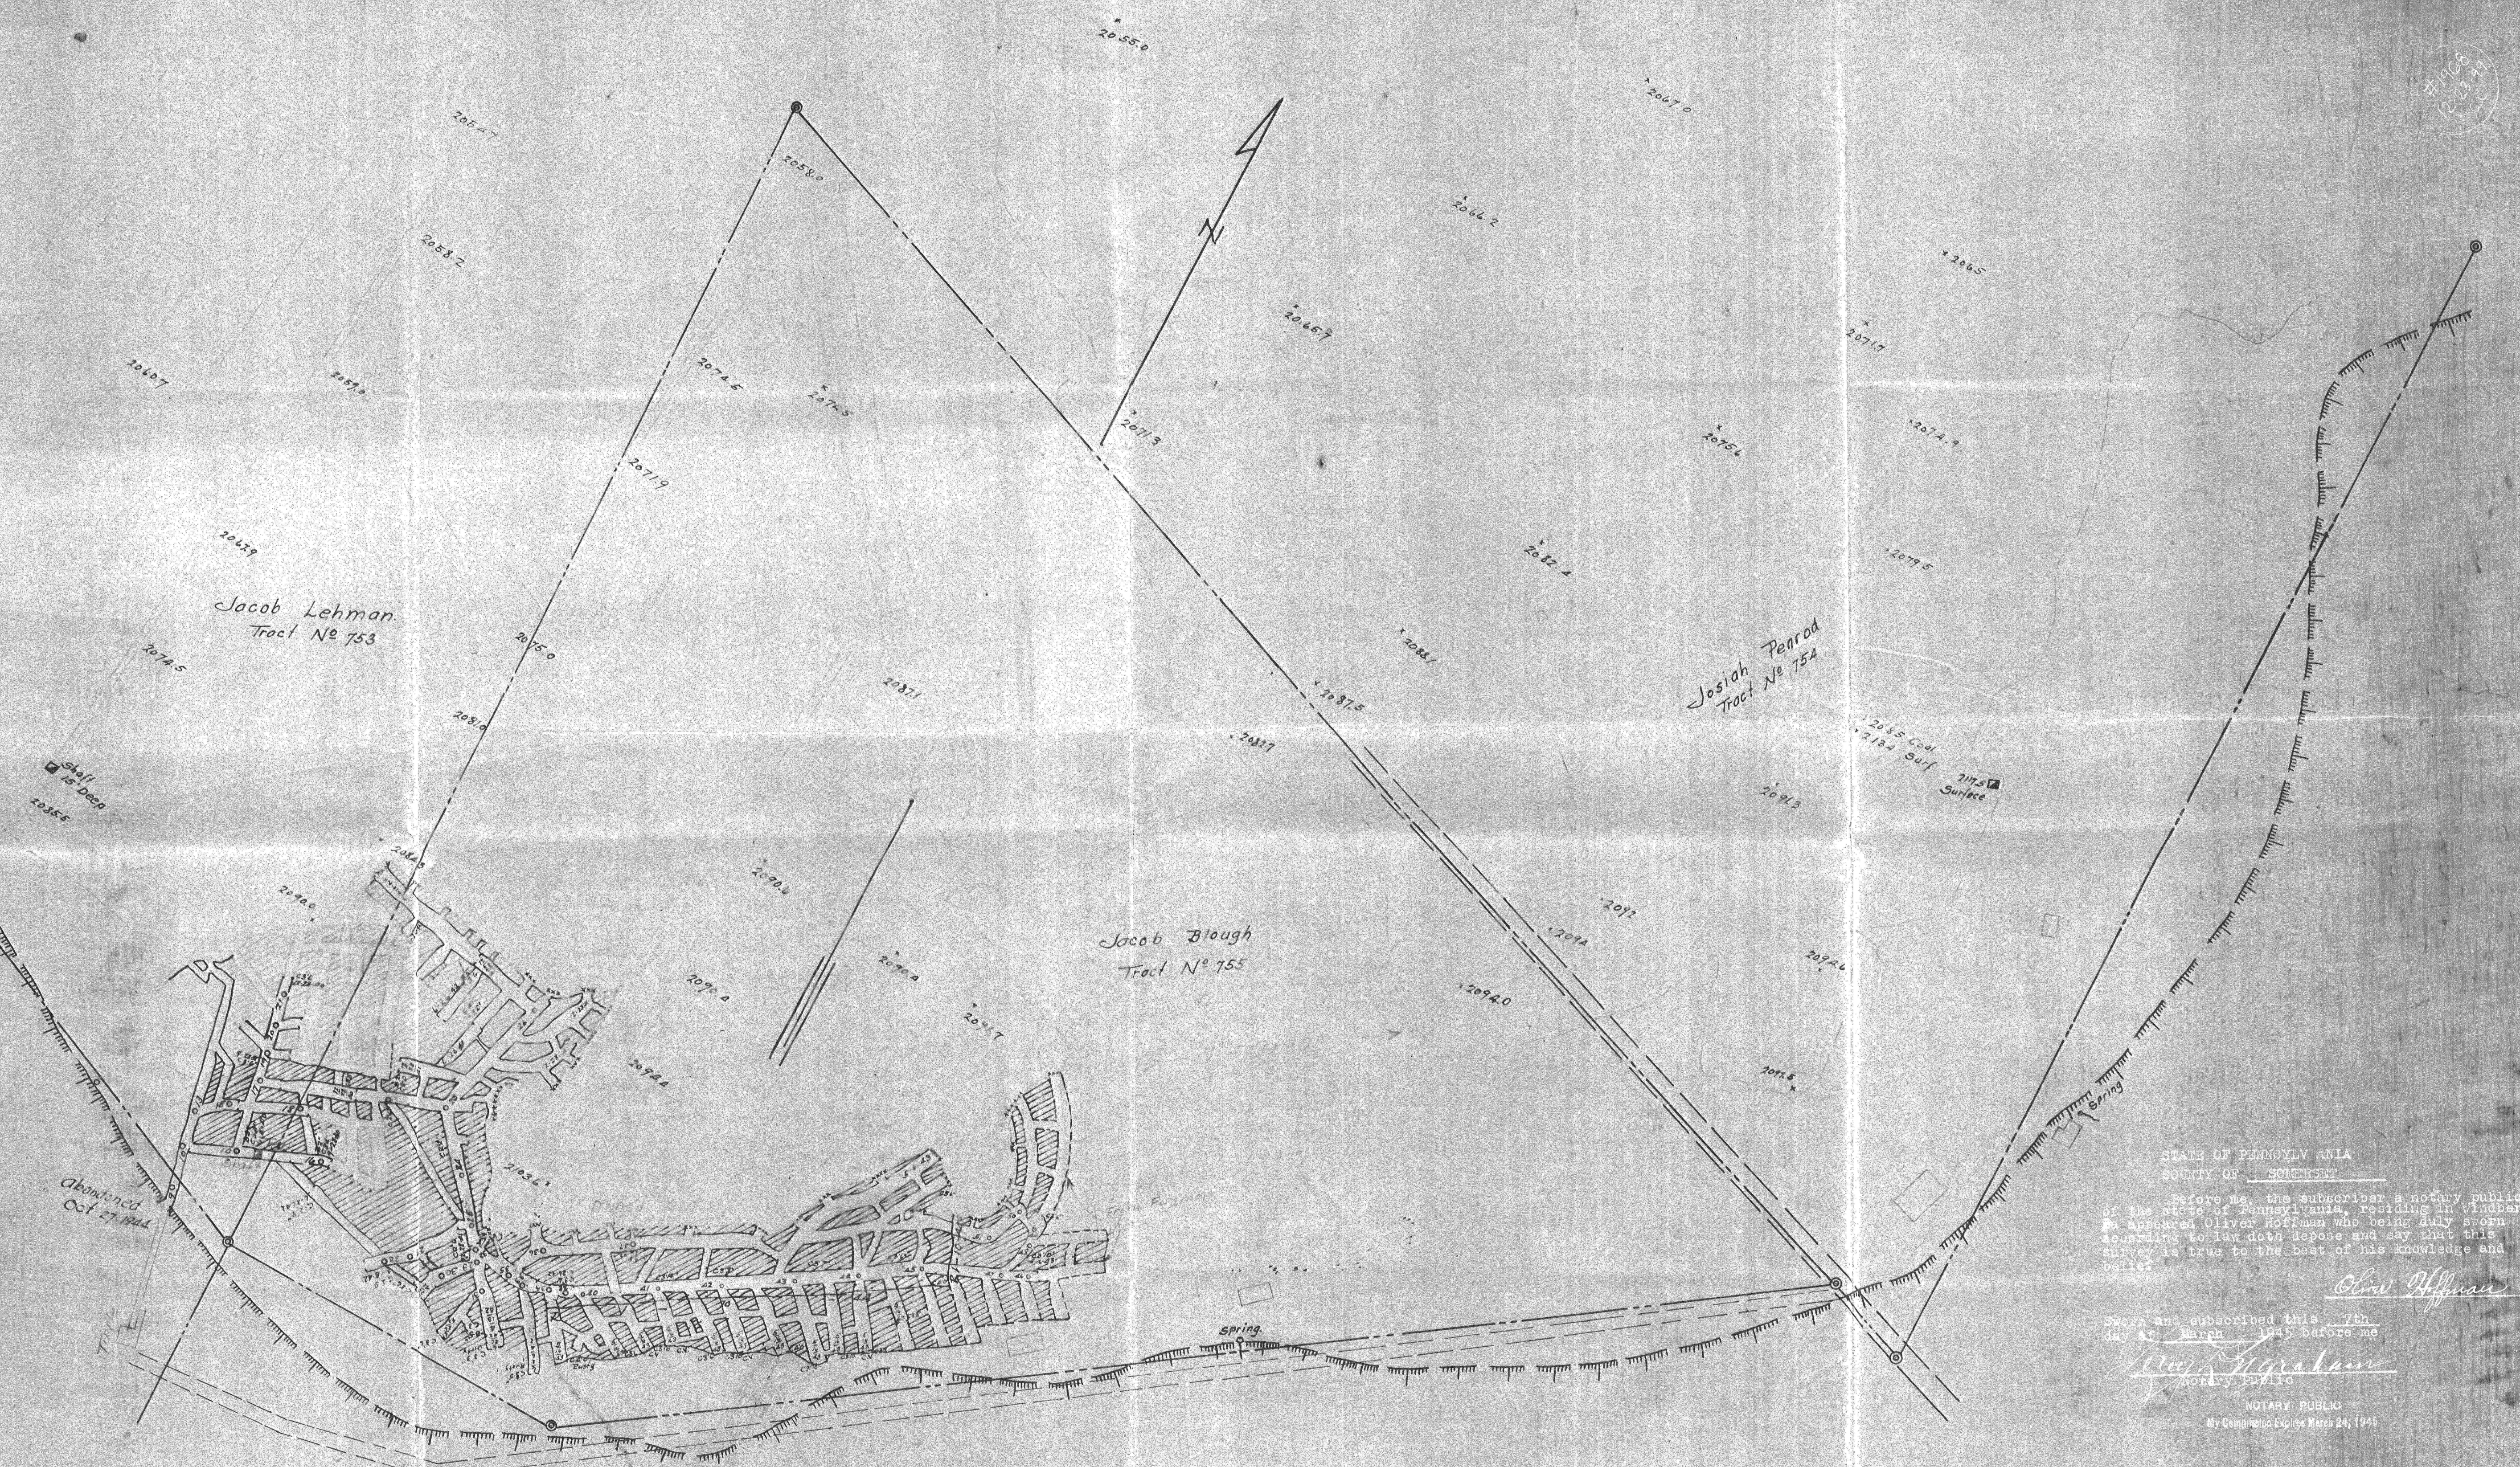

STATE OF PENNSYLVANIA
COUNTY OF SOMERSET

Before me, the subscriber a notary public
of the state of Pennsylvania, residing in Windber
Pa. appeared Oliver Hoffman who being duly sworn
according to law doth depose and say that this
survey is true to the best of his knowledge and
belief.

Oliver Hoffman

Sworn and subscribed this 7th
day of March 1945 before me

NOTARY PUBLIC

NOTARY PUBLIC
My Commission Expires March 24, 1945

OGLETOWN COAL CO
"B" SEAM
PAINT TOWNSHIP, SOMERSET, CO, PA.
SCALE 1"=100'
OCT 21 1939

