OHIO RIVER COAL CO.

PROPERTIES IN RACCOON AND GREENE TOWNSHIPS, BEAVER COUNTY, PENNSYLVANIA.

SCALE 1" = 300' — RATON & ELLIOTT, CIVIL AND MINING ENGINEERS, PITTSBURGH PA. — DECEMBER 1, 1917.

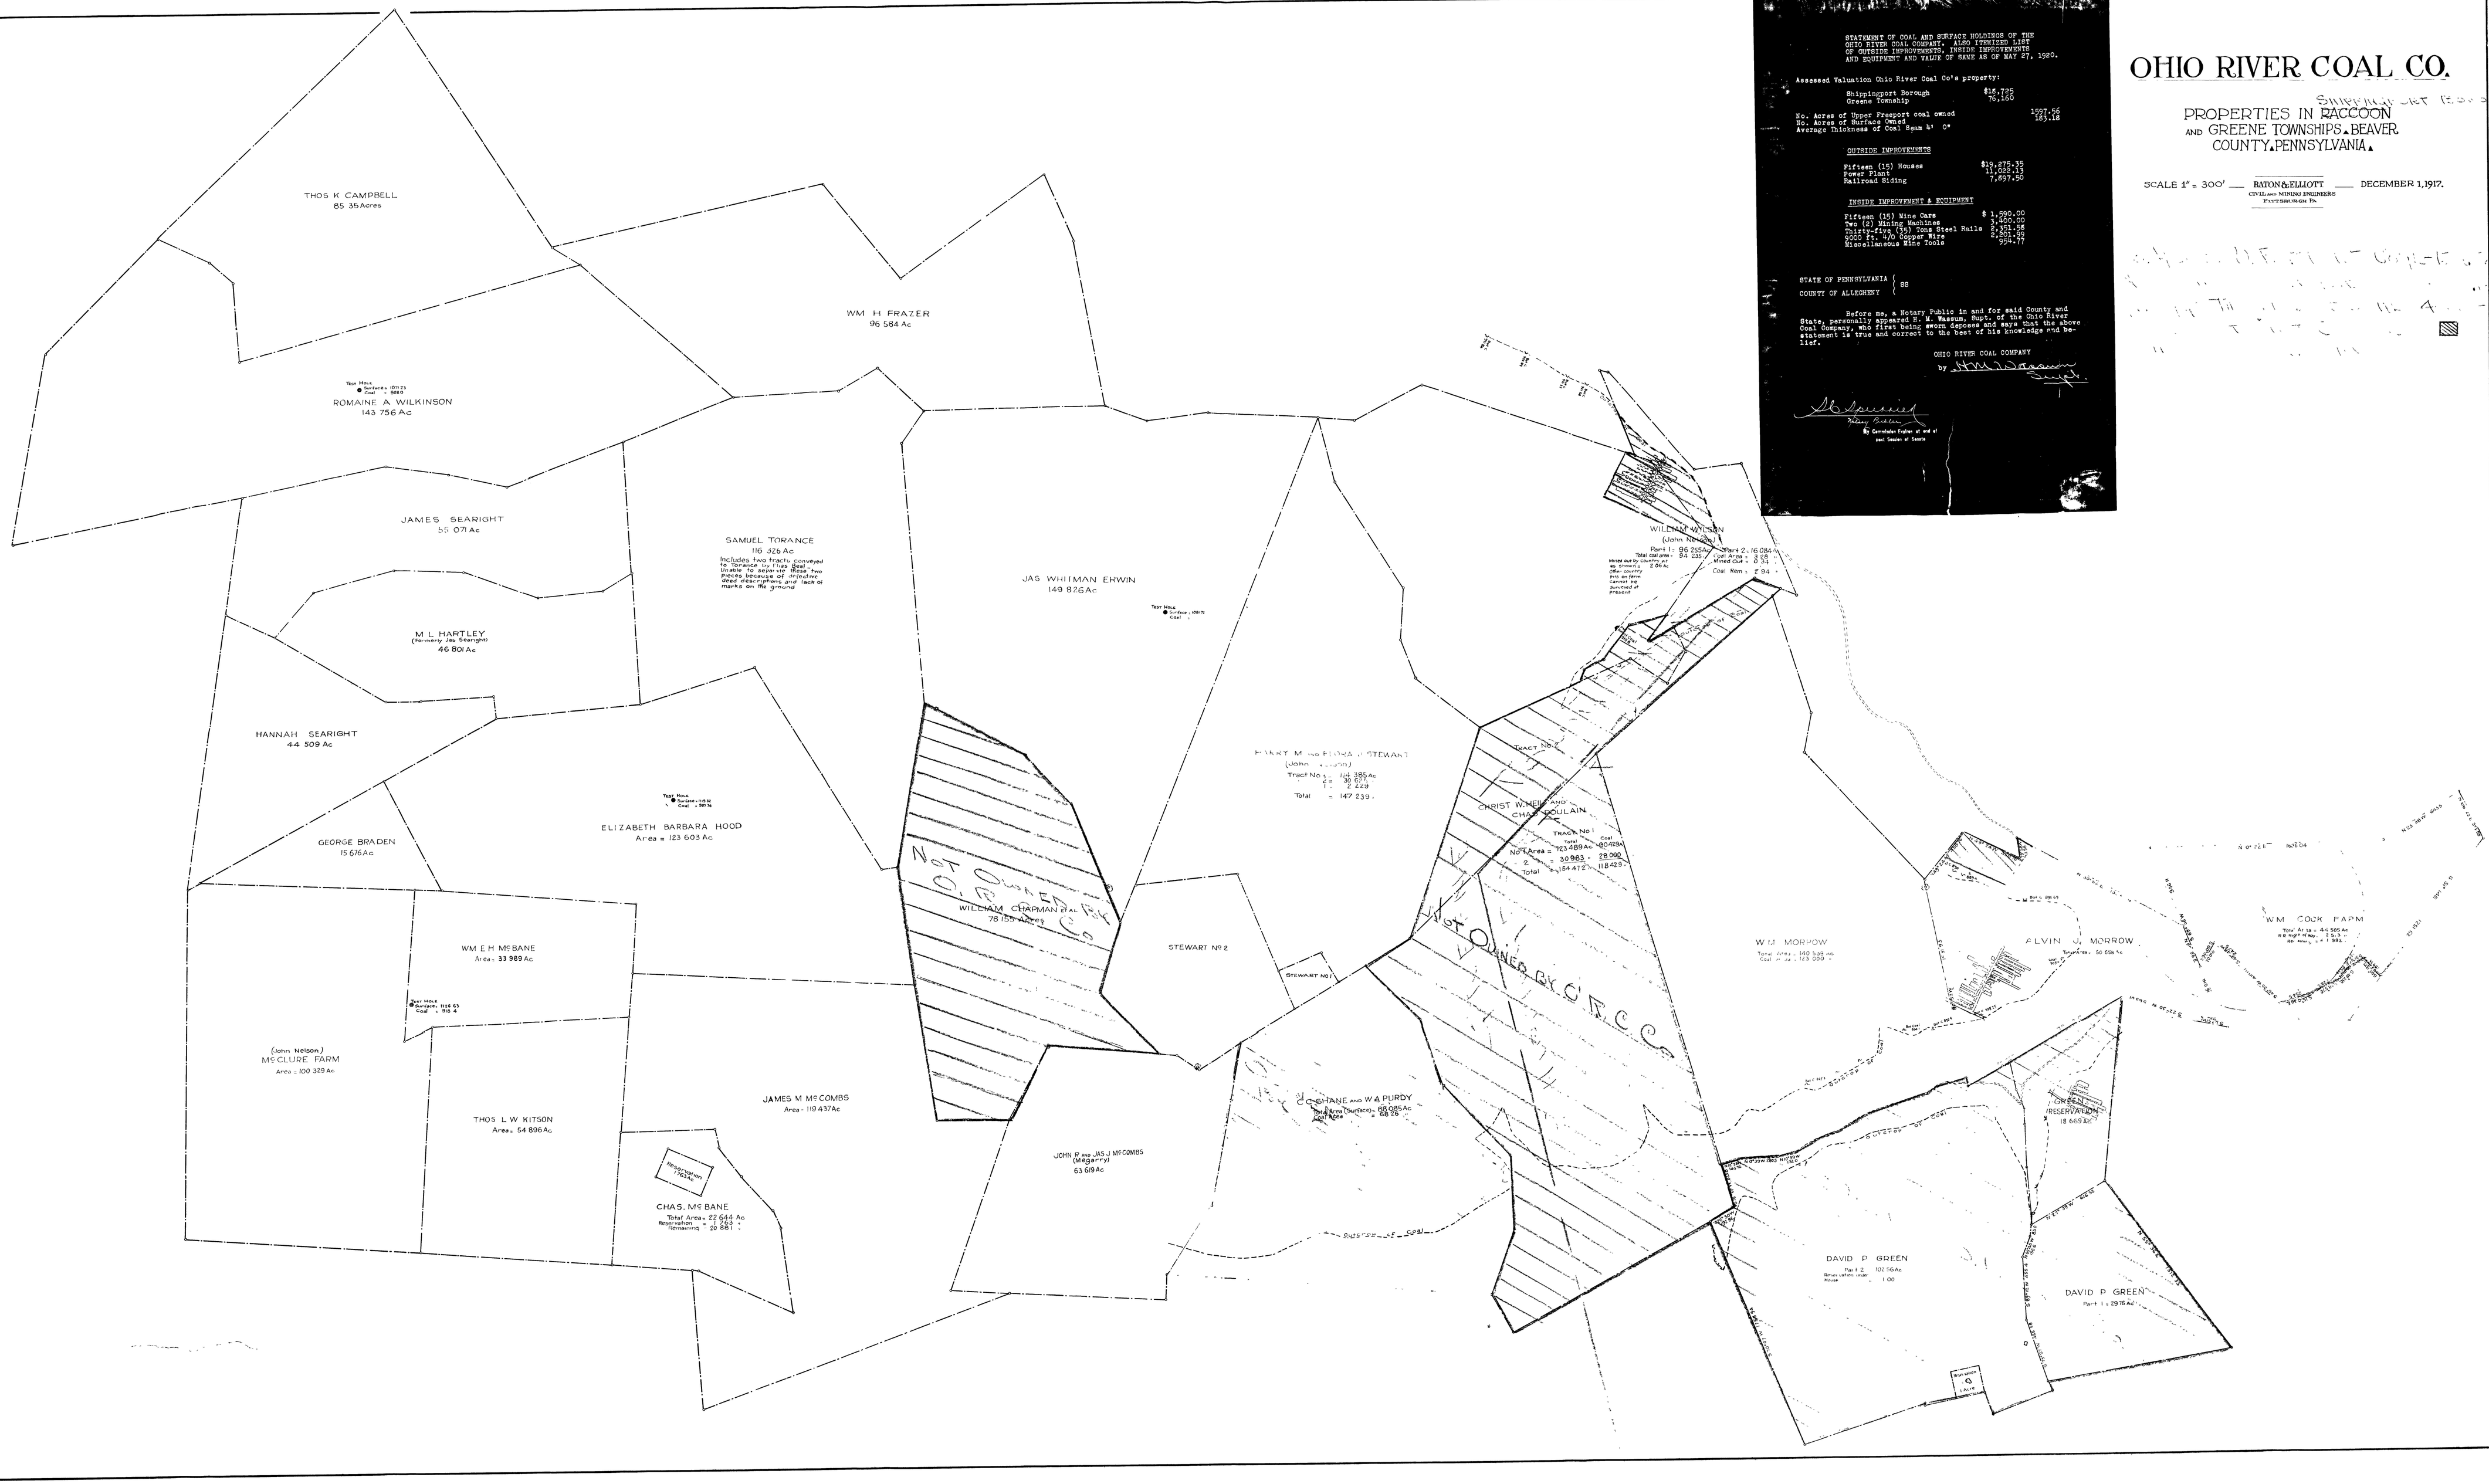

STATEMENT OF COAL AND SURFACE HOLDINGS OF THE OHIO RIVER COAL COMPANY, ALSO INVENTORY LIST OF OUTSIDE IMPROVEMENTS, INSIDE IMPROVEMENTS AND EQUIPMENT AND VALUE OF SAME AS OF MAY 27, 1920.

Assessed Valuation Ohio River Coal Co's property:

Shippingport Borough	$16,725
Greene Township	35,360
No. Acres of Upper Freeport coal owned	1097.56
No. Acres of Surface Owned	163.18
Average thickness of Coal 5ft 4"	

OUTSIDE IMPROVEMENTS

Fifteen (15) Houses	$19,275.15
Power Plant	11,062.53
Railroad Siding	7,897.50

INSIDE IMPROVEMENT & EQUIPMENT

Fifteen (15) Mine Cars	$ 1,990.00
Two (2) Mining Machines	3,400.00
Thirty-five (35) Tons Steel Rails	2,301.56
9000 Ft. #/0 Copper Wire	2,201.92
Miscellaneous Mine Tools	954.77

STATE OF PENNSYLVANIA } ss
COUNTY OF ALLEGHENY }

Before me, a Notary Public in and for said County and State, personally appeared H. W. Wasson, Supt. of the Ohio River Coal Company, who first being sworn deposes and says that the above statement is true and correct to the best of his knowledge and belief.

OHIO RIVER COAL COMPANY
by H. W. Wasson
Supt.

Sworn and subscribed before me this 27 day of May 1920.

Notary Public

My Commission Expires at end of next Session of Senate