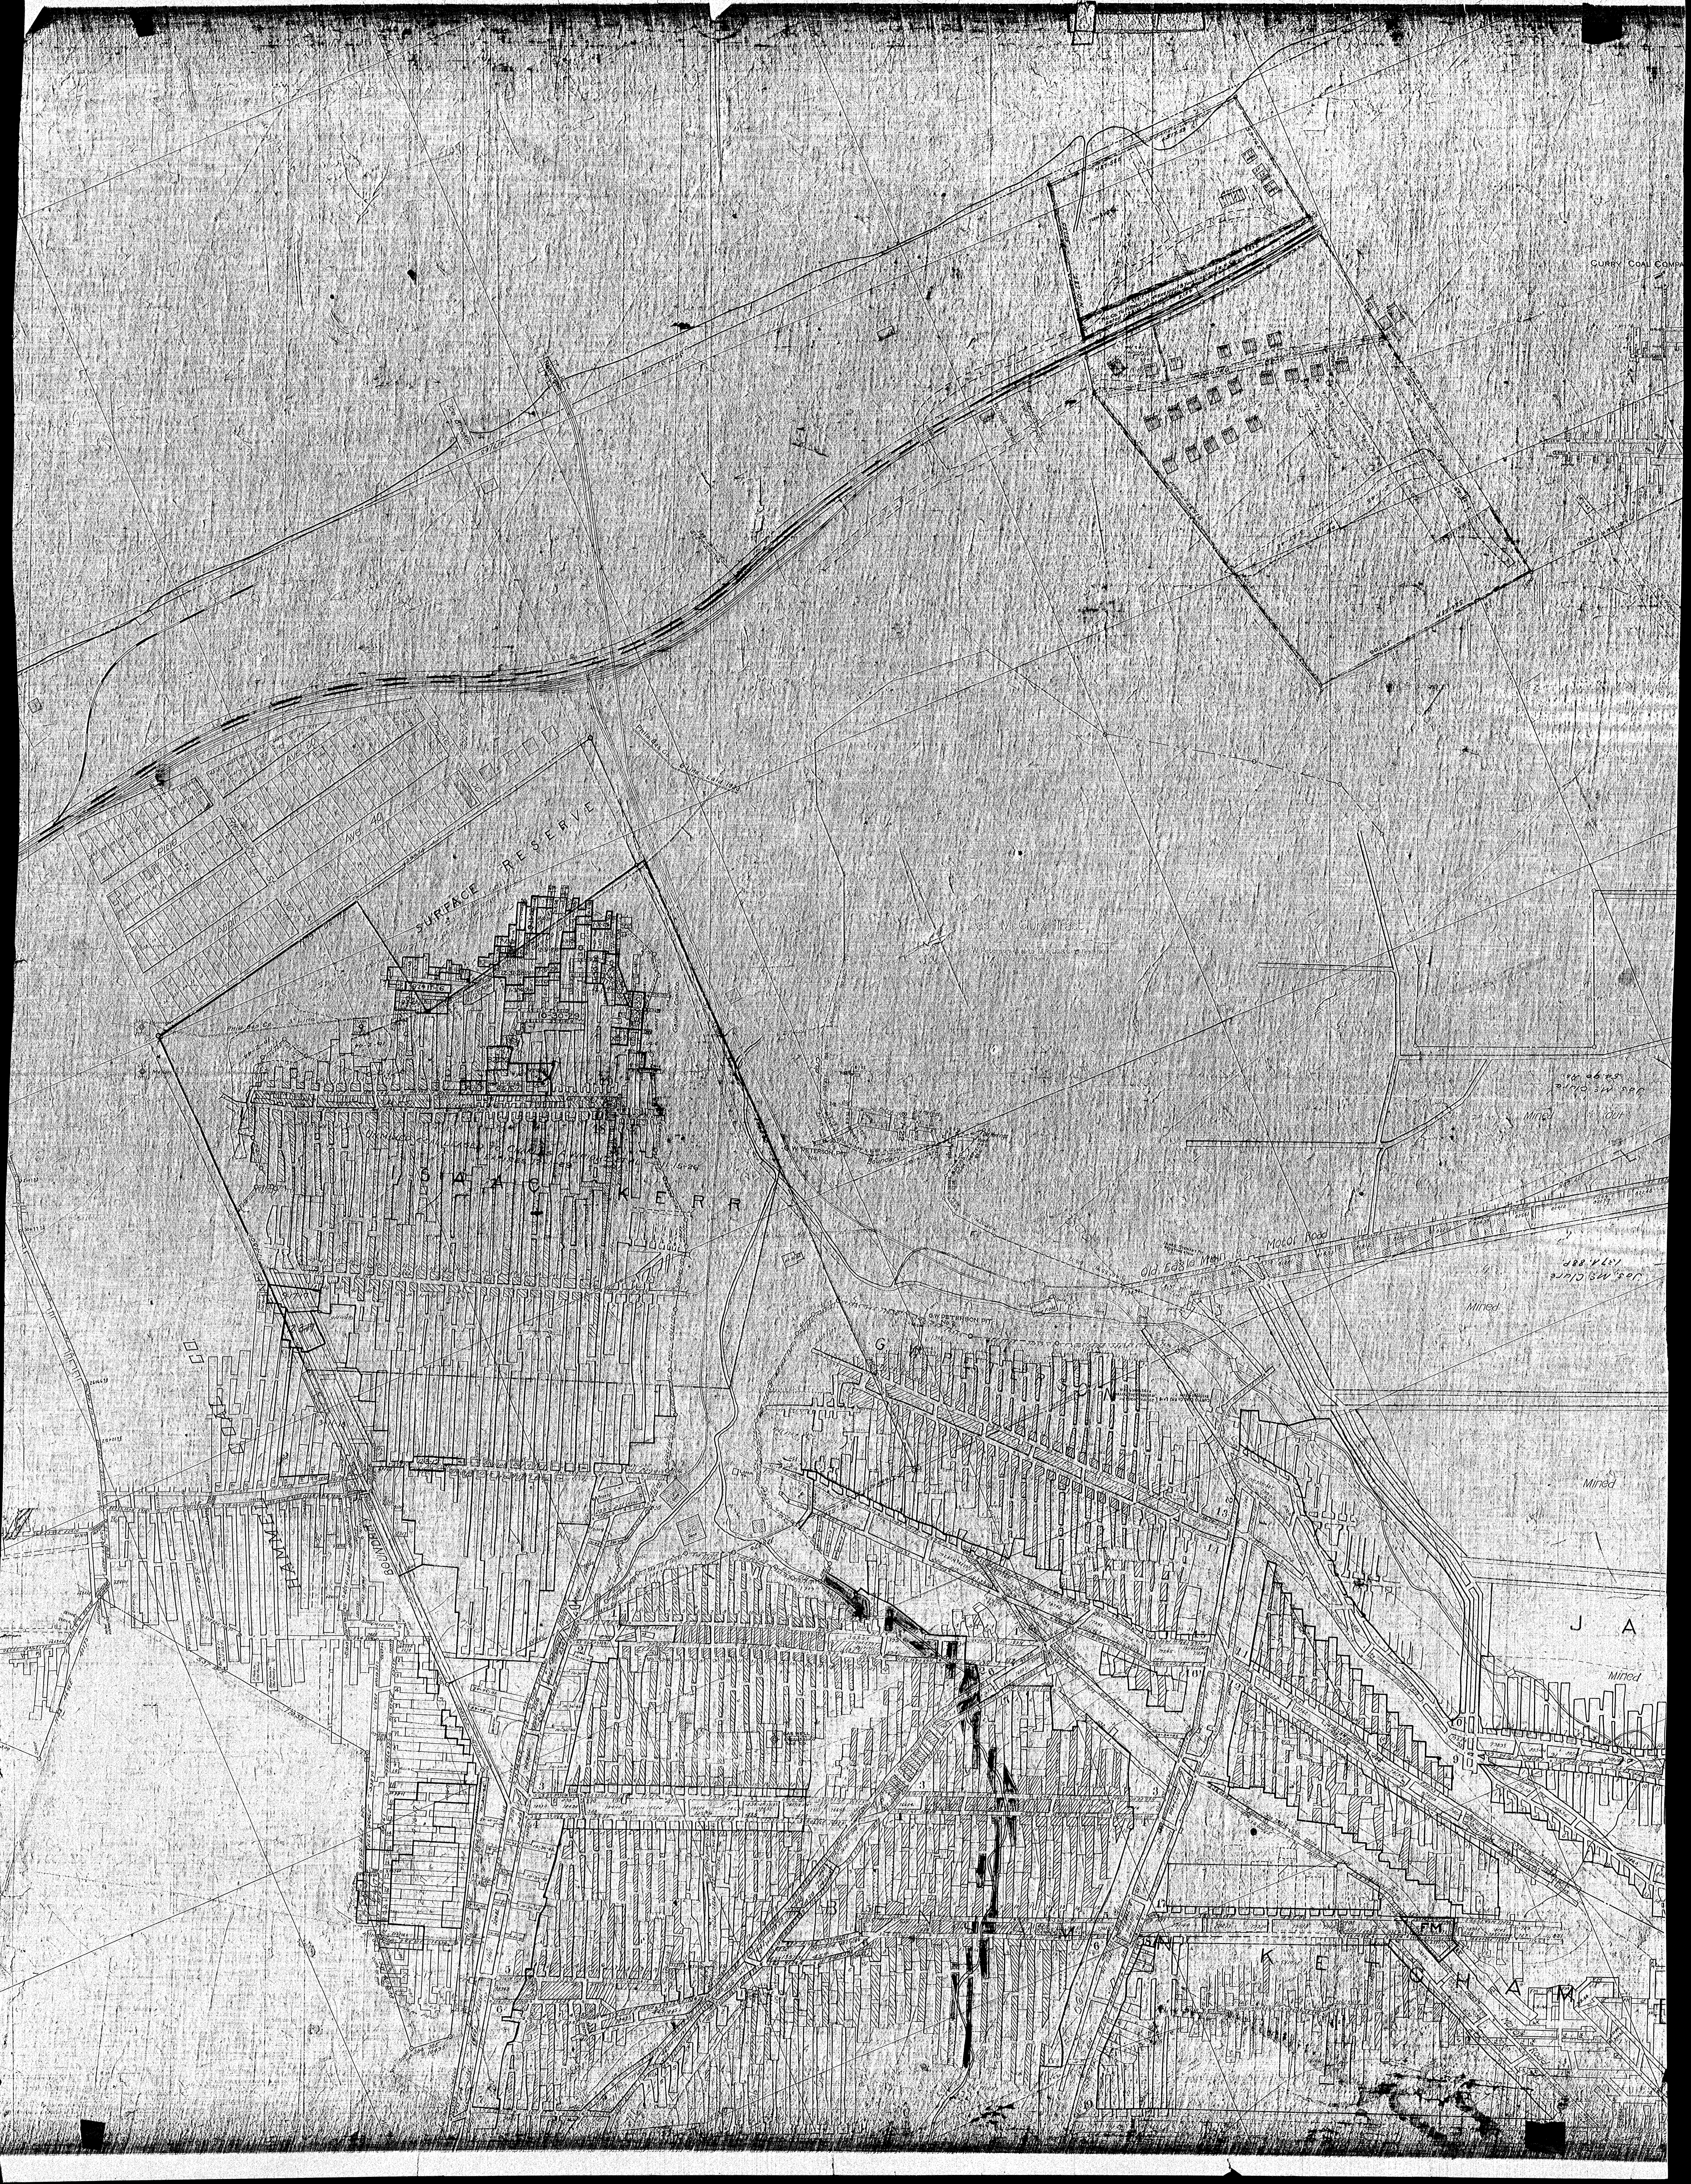
Curry Coal Comp
SURFACE RESERVE
ISAAC KERR
Old Eagle Main
Motor Road
James Stewart Pit
Redstone Vein
Jas. McClure
137A. 88P.
Jas. McClure
54.90 Rs.
Mined
Mined Out
G.W. PETERSON PIT
No. 2
Boiler Ho.
Mine F. Off.
Gone
Curtis Coal Co. R.J. Lehn Joseph Locke Pit
Redstone Vein
GARRISON
FLAMMER
BOUNDARY
Locust Post
3' Hole to Old Works.
Bore Hole to Old Workg.
S37 16 E
770.39
JA
KETCHAM
FM