


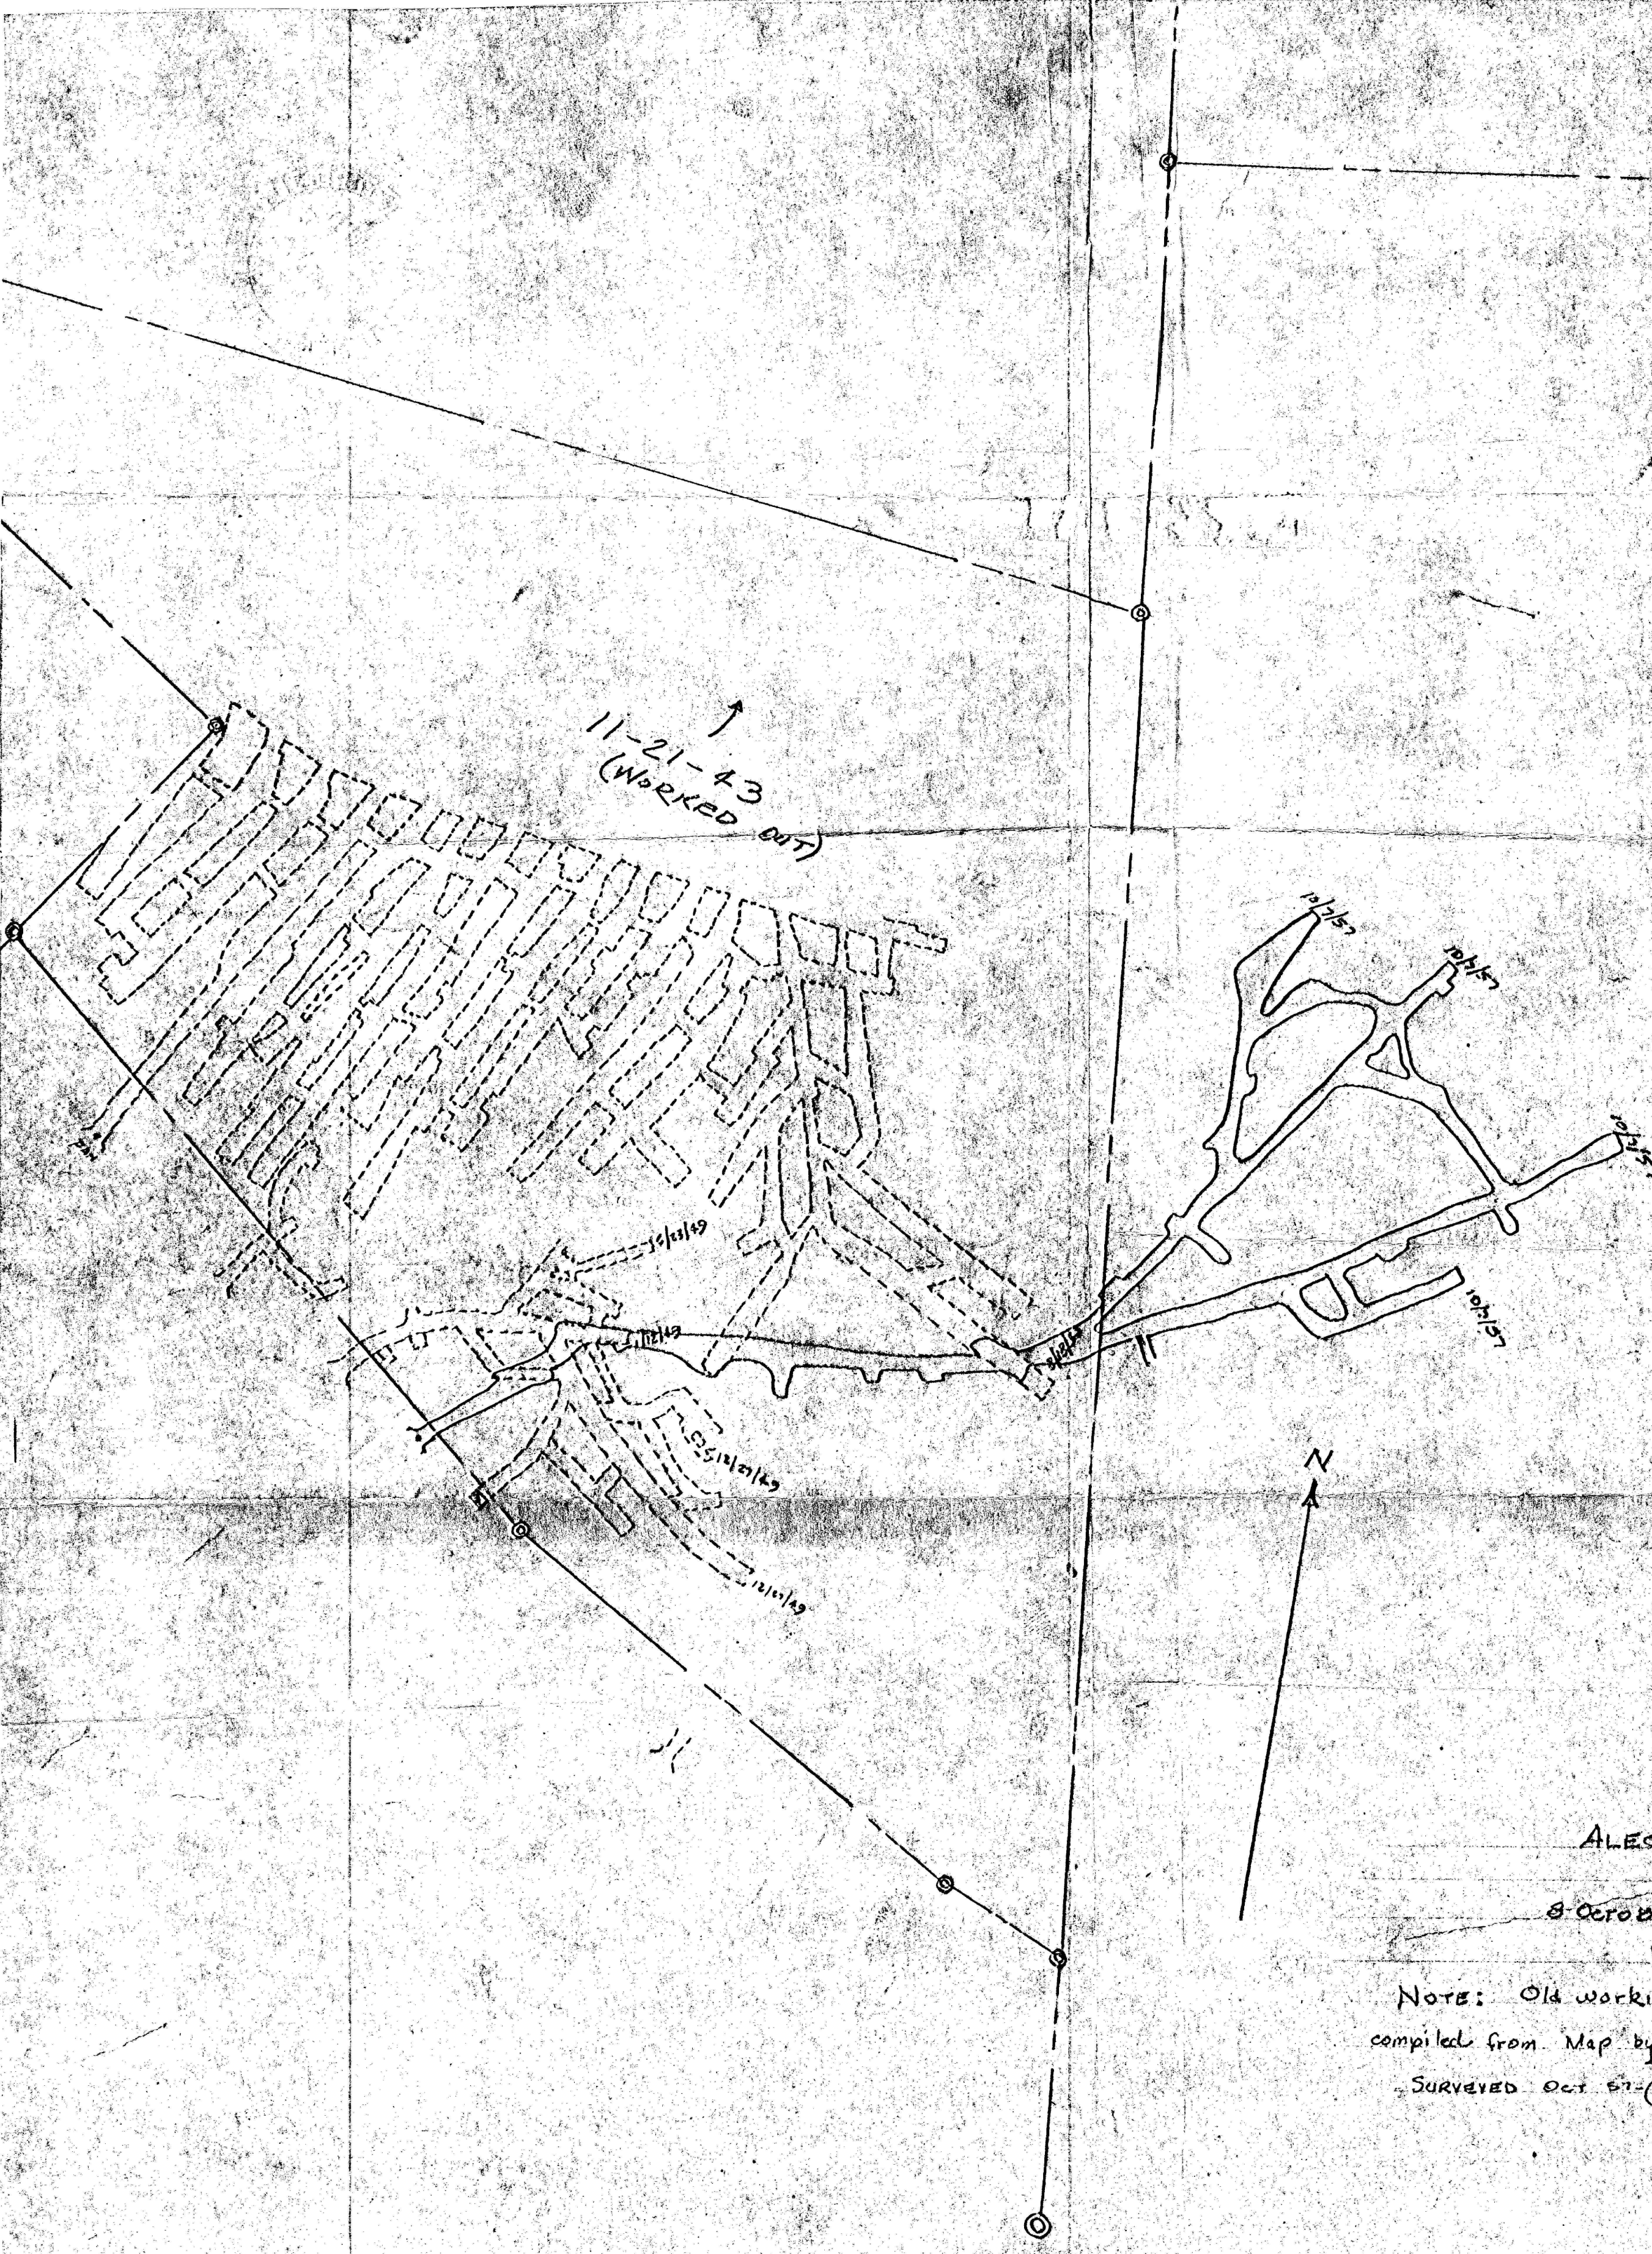

ALEC DASKIVICH, OPERATOR
OLD HUNTER No. 3
8 OCTOBER, 1967 1" = 100'
WHITE TWP., INDIANA CO., PA. 25
NOTE: Old workings of Two Lick Valley Coal Co. (Shown dotted) as
compiled from Map by Walter E. Bloch, Reg. SURV.
SURVEYED Oct 67 J. E. Carey DRAWN BY R. G. SHANEY

#1980
12-23-99
C.C.