OLIPHANT MINE

OF THE

UNITED STATES STEEL CORPORATION

GEORGES TWP. — FAYETTE CO. — PA.

DATUM OF LEVELS 16.1 FT. BELOW MEAN TIDE AT SANDY HOOK

SCALE 1"=100

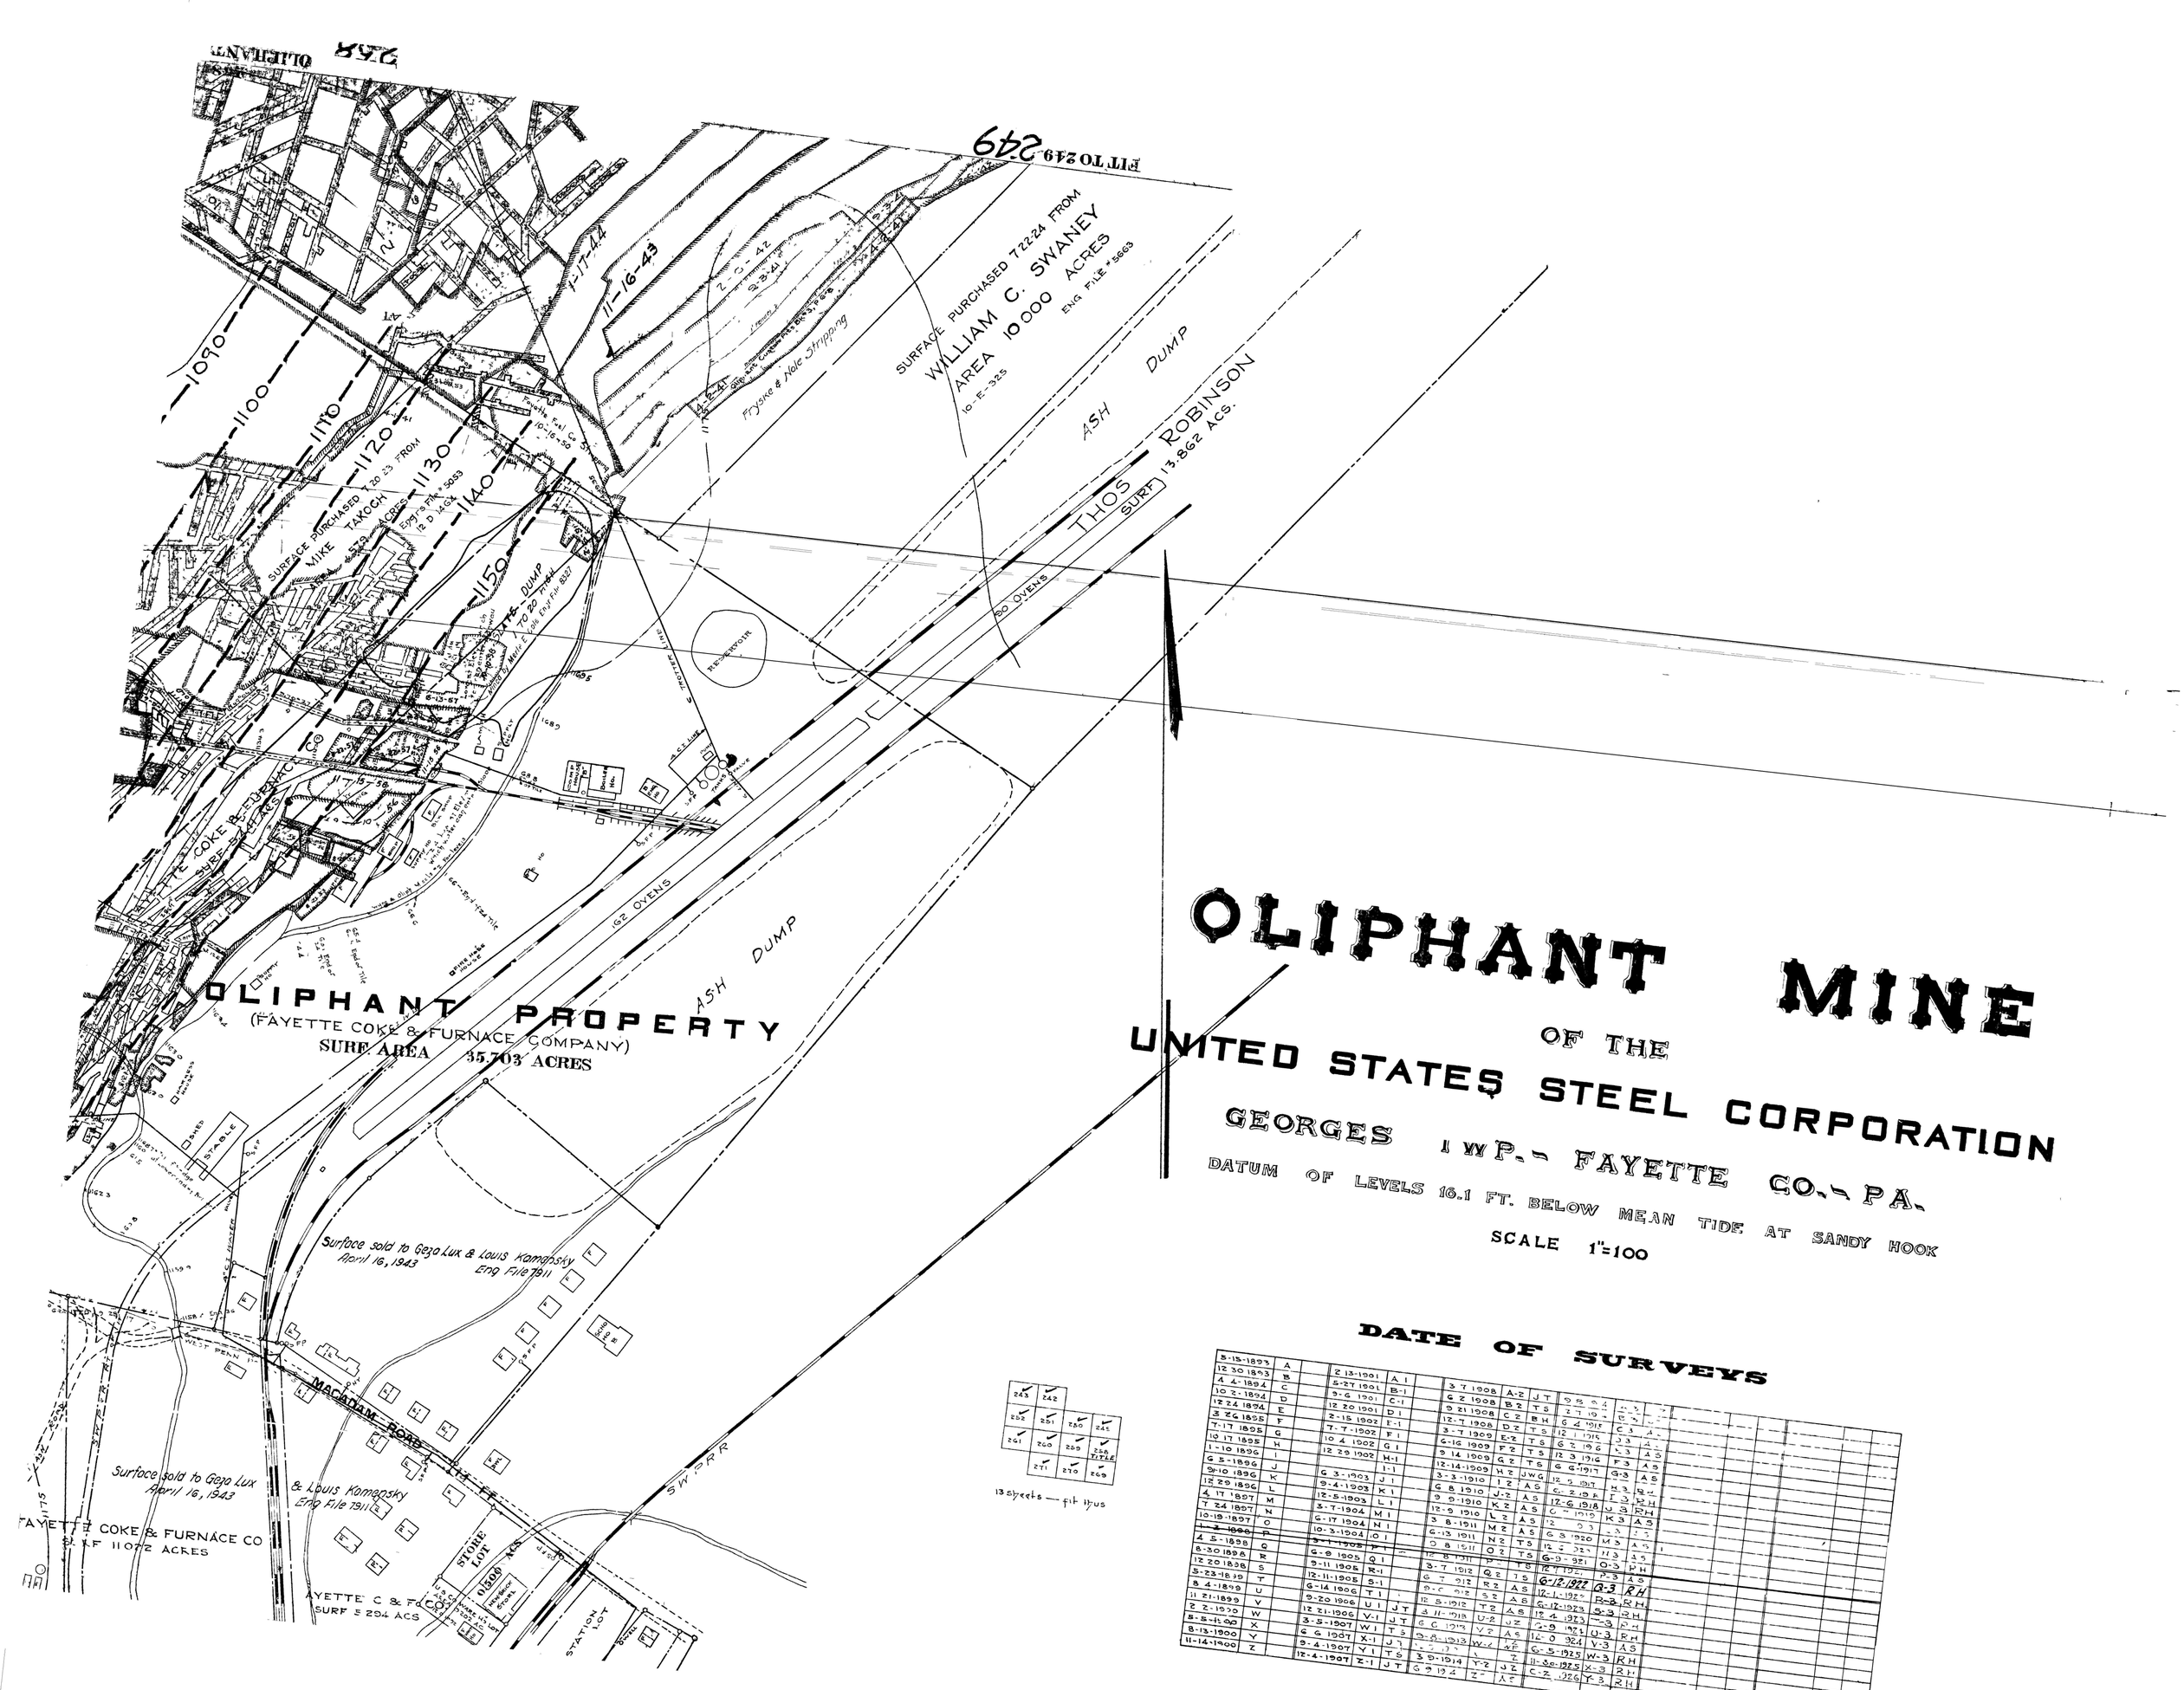

DATE OF SURVEYS

8-15-1893	A		2-13-1901	A-1		3-7-1908	A-2	JT			
12-30-1893	B		5-27-1901	B-1		6-2-1908	B-2	TS			
4-4-1894	C		9-6-1901	C-1		9-21-1908	C-2	BH			
10-2-1894	D		12-20-1901	D-1		12-7-1908	D-2	TS			
12-24-1894	E		2-15-1902	E-1		3-7-1909	E-2	TS			
3-26-1895	F		7-7-1902	F-1		6-16-1909	F-2	TS			
7-17-1895	G		10-4-1902	G-1		9-14-1909	G-2	TS			
10-17-1895	H		12-29-1902	H-1		12-14-1909	H-2	JWG			
1-10-1896	I			I-1		3-3-1910	I-2	AS			
6-5-1896	J		6-3-1903	J-1		6-8-1910	J-2	AS			
9-10-1896	K		9-4-1903	K-1		9-9-1910	K-2	AS			
12-29-1896	L		12-5-1903	L-1		12-9-1910	L-2	AS			
4-17-1897	M		3-7-1904	M-1		3-8-1911	M-2	AS			
7-24-1897	N		6-17-1904	N-1		6-13-1911	N-2	AS			
10-19-1897	O		10-3-1904	O-1		9-8-1911	O-2	TS			
~~1-1-1898~~	P		3-1-1905	P-1		12-8-1911	P-2	TS			
4-5-1898	Q		6-9-1905	Q-1		3-7-1912	Q-2	TS			
8-30-1898	R		9-11-1905	R-1		6-7-1912	R-2	AS			
12-20-1898	S		12-11-1905	S-1		9-6-1912	S-2	AS			
3-23-1899	T		6-14-1906	T-1		12-5-1912	T-2	AS			
8-4-1899	U		9-20-1906	U-1	JT	3-11-1913	U-2	UZ			
11-21-1899	V		12-31-1906	V-1	JT	6-6-1913	V-2	AS			
2-2-1900	W		3-5-1907	W-1	TS	9-5-1913	W-2	AS			
5-5-1900	X		6-6-1907	X-1	JT	12-3-1913	X-2	AS			
8-13-1900	Y		9-4-1907	Y-1	TS	3-10-1914	Y-2	JZ			
11-14-1900	Z		12-4-1907	Z-1	JT	6-9-1914	Z-2	AS			

9-15-1914	A-3	JT									
12-14-1914	B-3	TS									
3-7-1915	C-3	AS									
6-7-1915	D-3	AS									
9-13-1915	E-3	AS									
12-13-1915	F-3	AS									
6-6-1916	G-3	AS									
12-5-1917	H-3	AS									
6-2-1918	I-3	RH									
12-6-1918	J-3	RH									
6-7-1919	K-3	AS									
12-5-1919	L-3	AS									
6-3-1920	M-3	AS									
12-3-1920	N-3	AS									
6-9-1921	O-3	RH									
12-7-1921	P-3	AS									
6-12-1922	Q-3	RH									
12-1-1922	R-3	RH									
6-12-1923	S-3	RH									
12-4-1923	T-3	RH									
6-9-1924	U-3	RH									
12-8-1924	V-3	AS									
6-5-1925	W-3	RH									
11-30-1925	X-3	RH									
C-Z .026	Y-3	RH									