


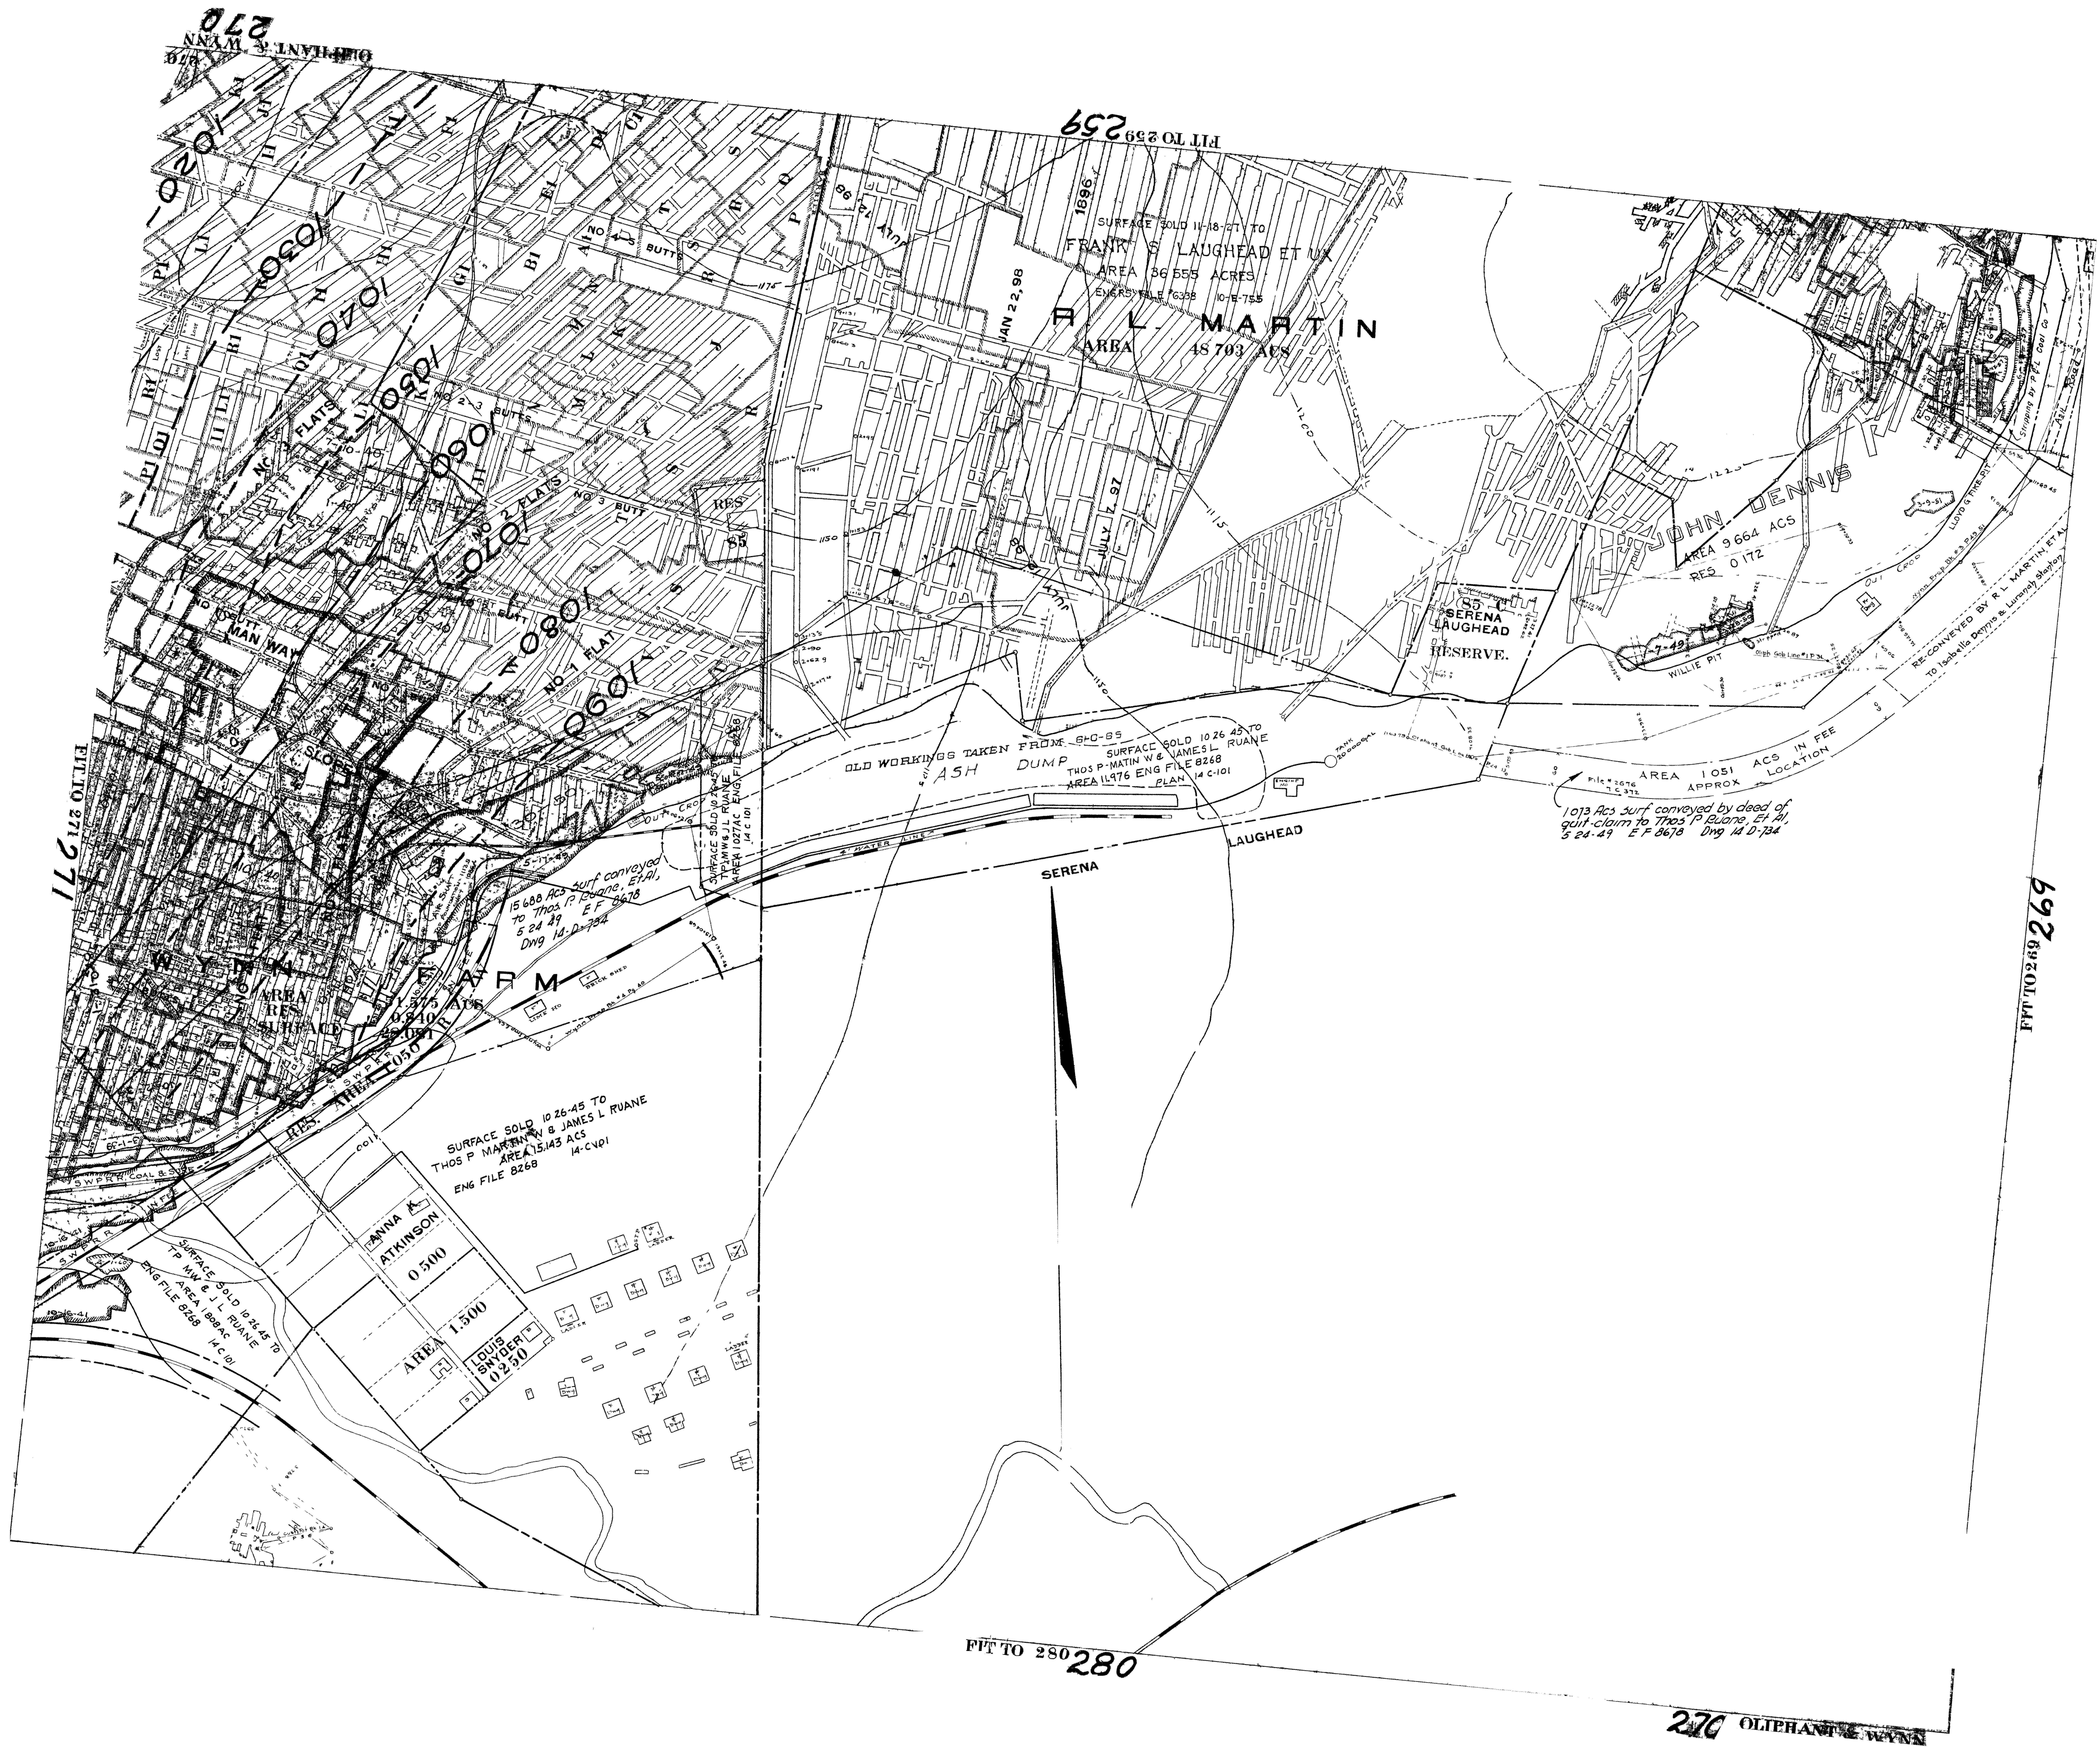

1896
JAN 22 98
JULY 7 97
FIT TO 259

FRANK S. LAUGHEAD ET UX
AREA 86 555 ACRES
EMERSON FILE 6358 10-E-755
J. L. MARTIN
AREA 48 703 ACRES

JOHN DENNIS
AREA 9 664 ACRES
RES 0 172

SERENA LAUGHEAD
RESERVE.

1013 Acs Surf conveyed by deed of
quit-claim to Thos P. Ruane, Et Al,
5-24-49 E F 8678 Dng 14-D-734

OLD WORKINGS TAKEN FROM 6-C-85
ASH DUMP
SURFACE SOLD 10-26-45 TO
THOS P. MARTIN W & JAMES L. RUANE
AREA 14 976 ENG FILE 8268
PLAN 14 C-101

15 668 Acs Surf conveyed
to Thos P. Ruane, Et Al,
5-24-49 E F 8678
Dng 14-D-734

SURFACE SOLD 10-26-45 TO
THOS P. MARTIN W & JAMES L. RUANE
AREA 15 143 ACRES
ENG FILE 8268 14-C-101

ANNA ATKINSON
0 500

LOUIS SNYDER
0 250

FIT TO 280
280

270 OLIPHANT & WYNN

FIT TO 269
269