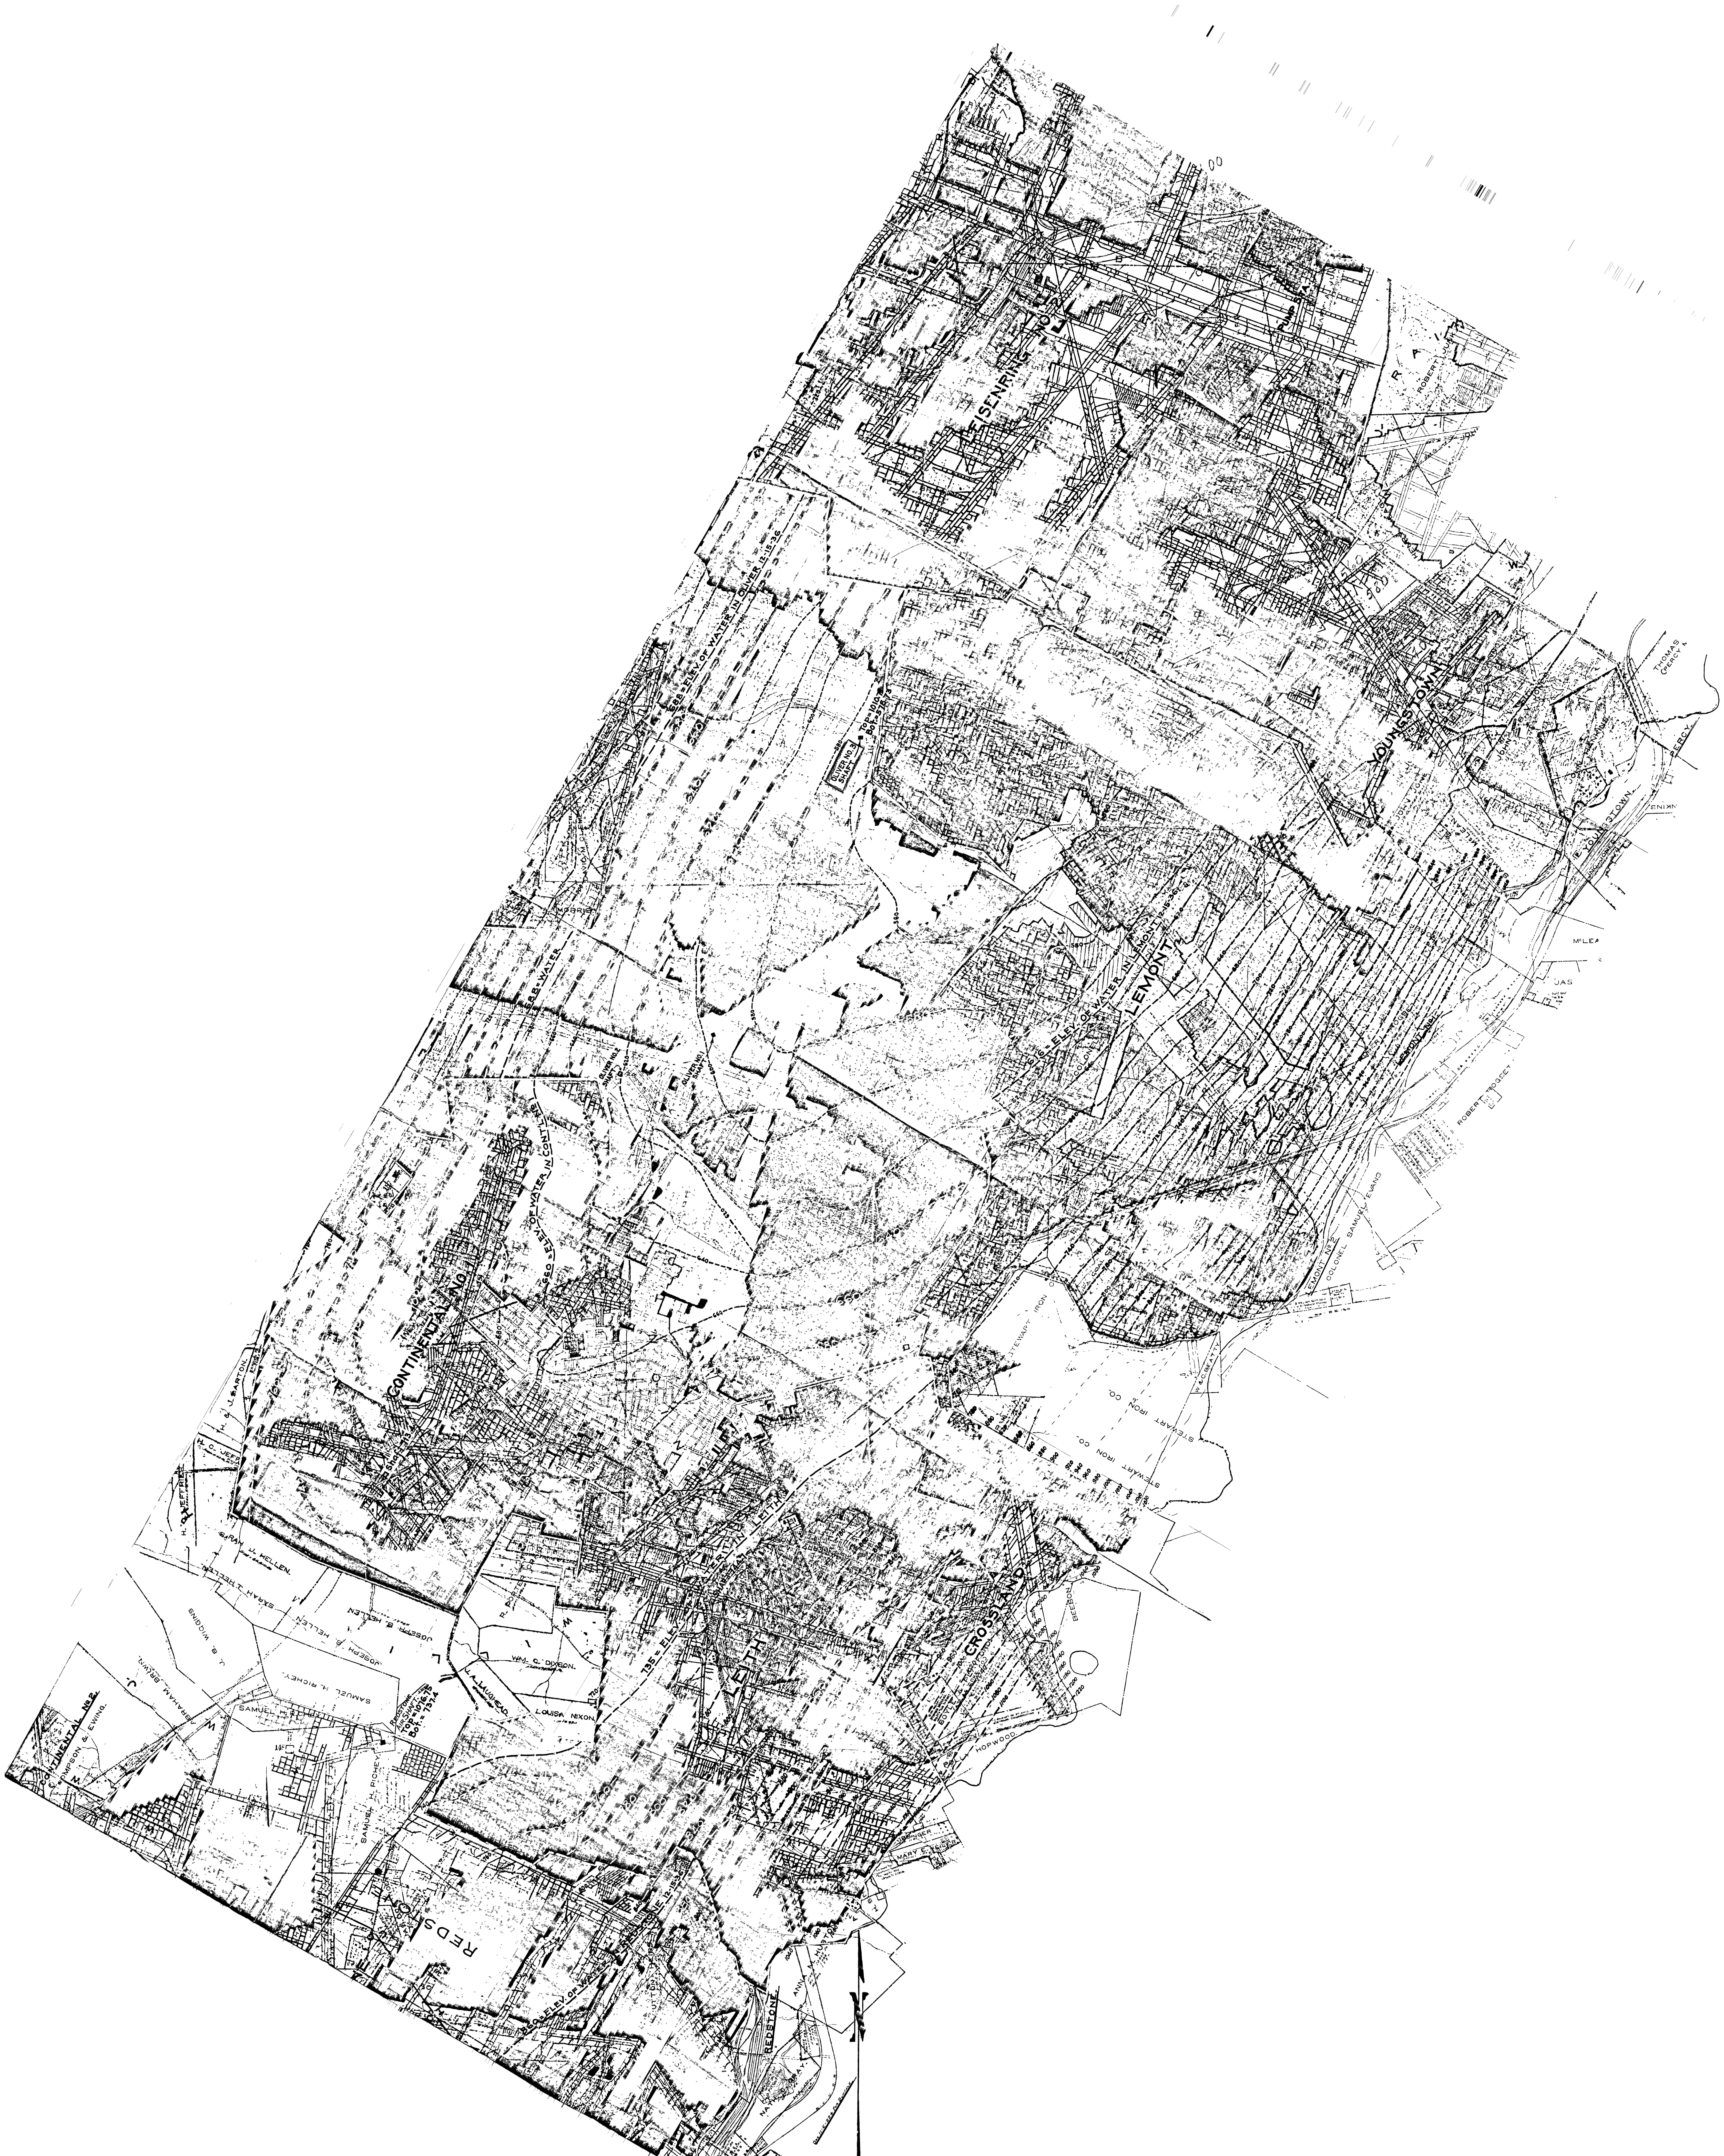
EISENRING No. 2
PUMP SH.
ROBERT JOHN
YOUNGSTOWN
OLIVER No. 3 SHAFT
Top = 1010.
Bot. = 576.75
LINCOLN
LEMONT
616 = ELEV. OF WATER IN LEMONT 12-15-36
COLONEL SAMUEL EVANS
ROBERT HOGSETT
LEMONT No. 1
LEMONT No. 2
SAMUEL
McLEAN
JOHN JONES
JOHN JENKINS
THOMAS
PERCY
JAS
STEWART IRON CO.
W. & C. BEATTY
CONTINENTAL No.
H. & J. BARTON.
H. C. JEFFRIES
SARAH J. HELLEN.
SARAH T. HELLEN
JOSEPH B. HELLEN
J. B. WIGGINS
ABRAHAM BROWN.
SAMUEL H. RICHEY.
SAMUEL H. RICHEY
REDSTONE AIRSHAFT
Top = 1076.75
Bot. = 737.4
R. PORTER
WM. C. DIXSON.
F. A. LAUGHEAD
LOUISA NIXON
CONTINENTAL No. 2.
THOMPSON & EWING.
735 = ELEV.
LEITH
REDS
860 = ELEV. OF WATER
REDSTONE 12-15-36
REDSTONE
CROSSLAND
HOPWOOD