


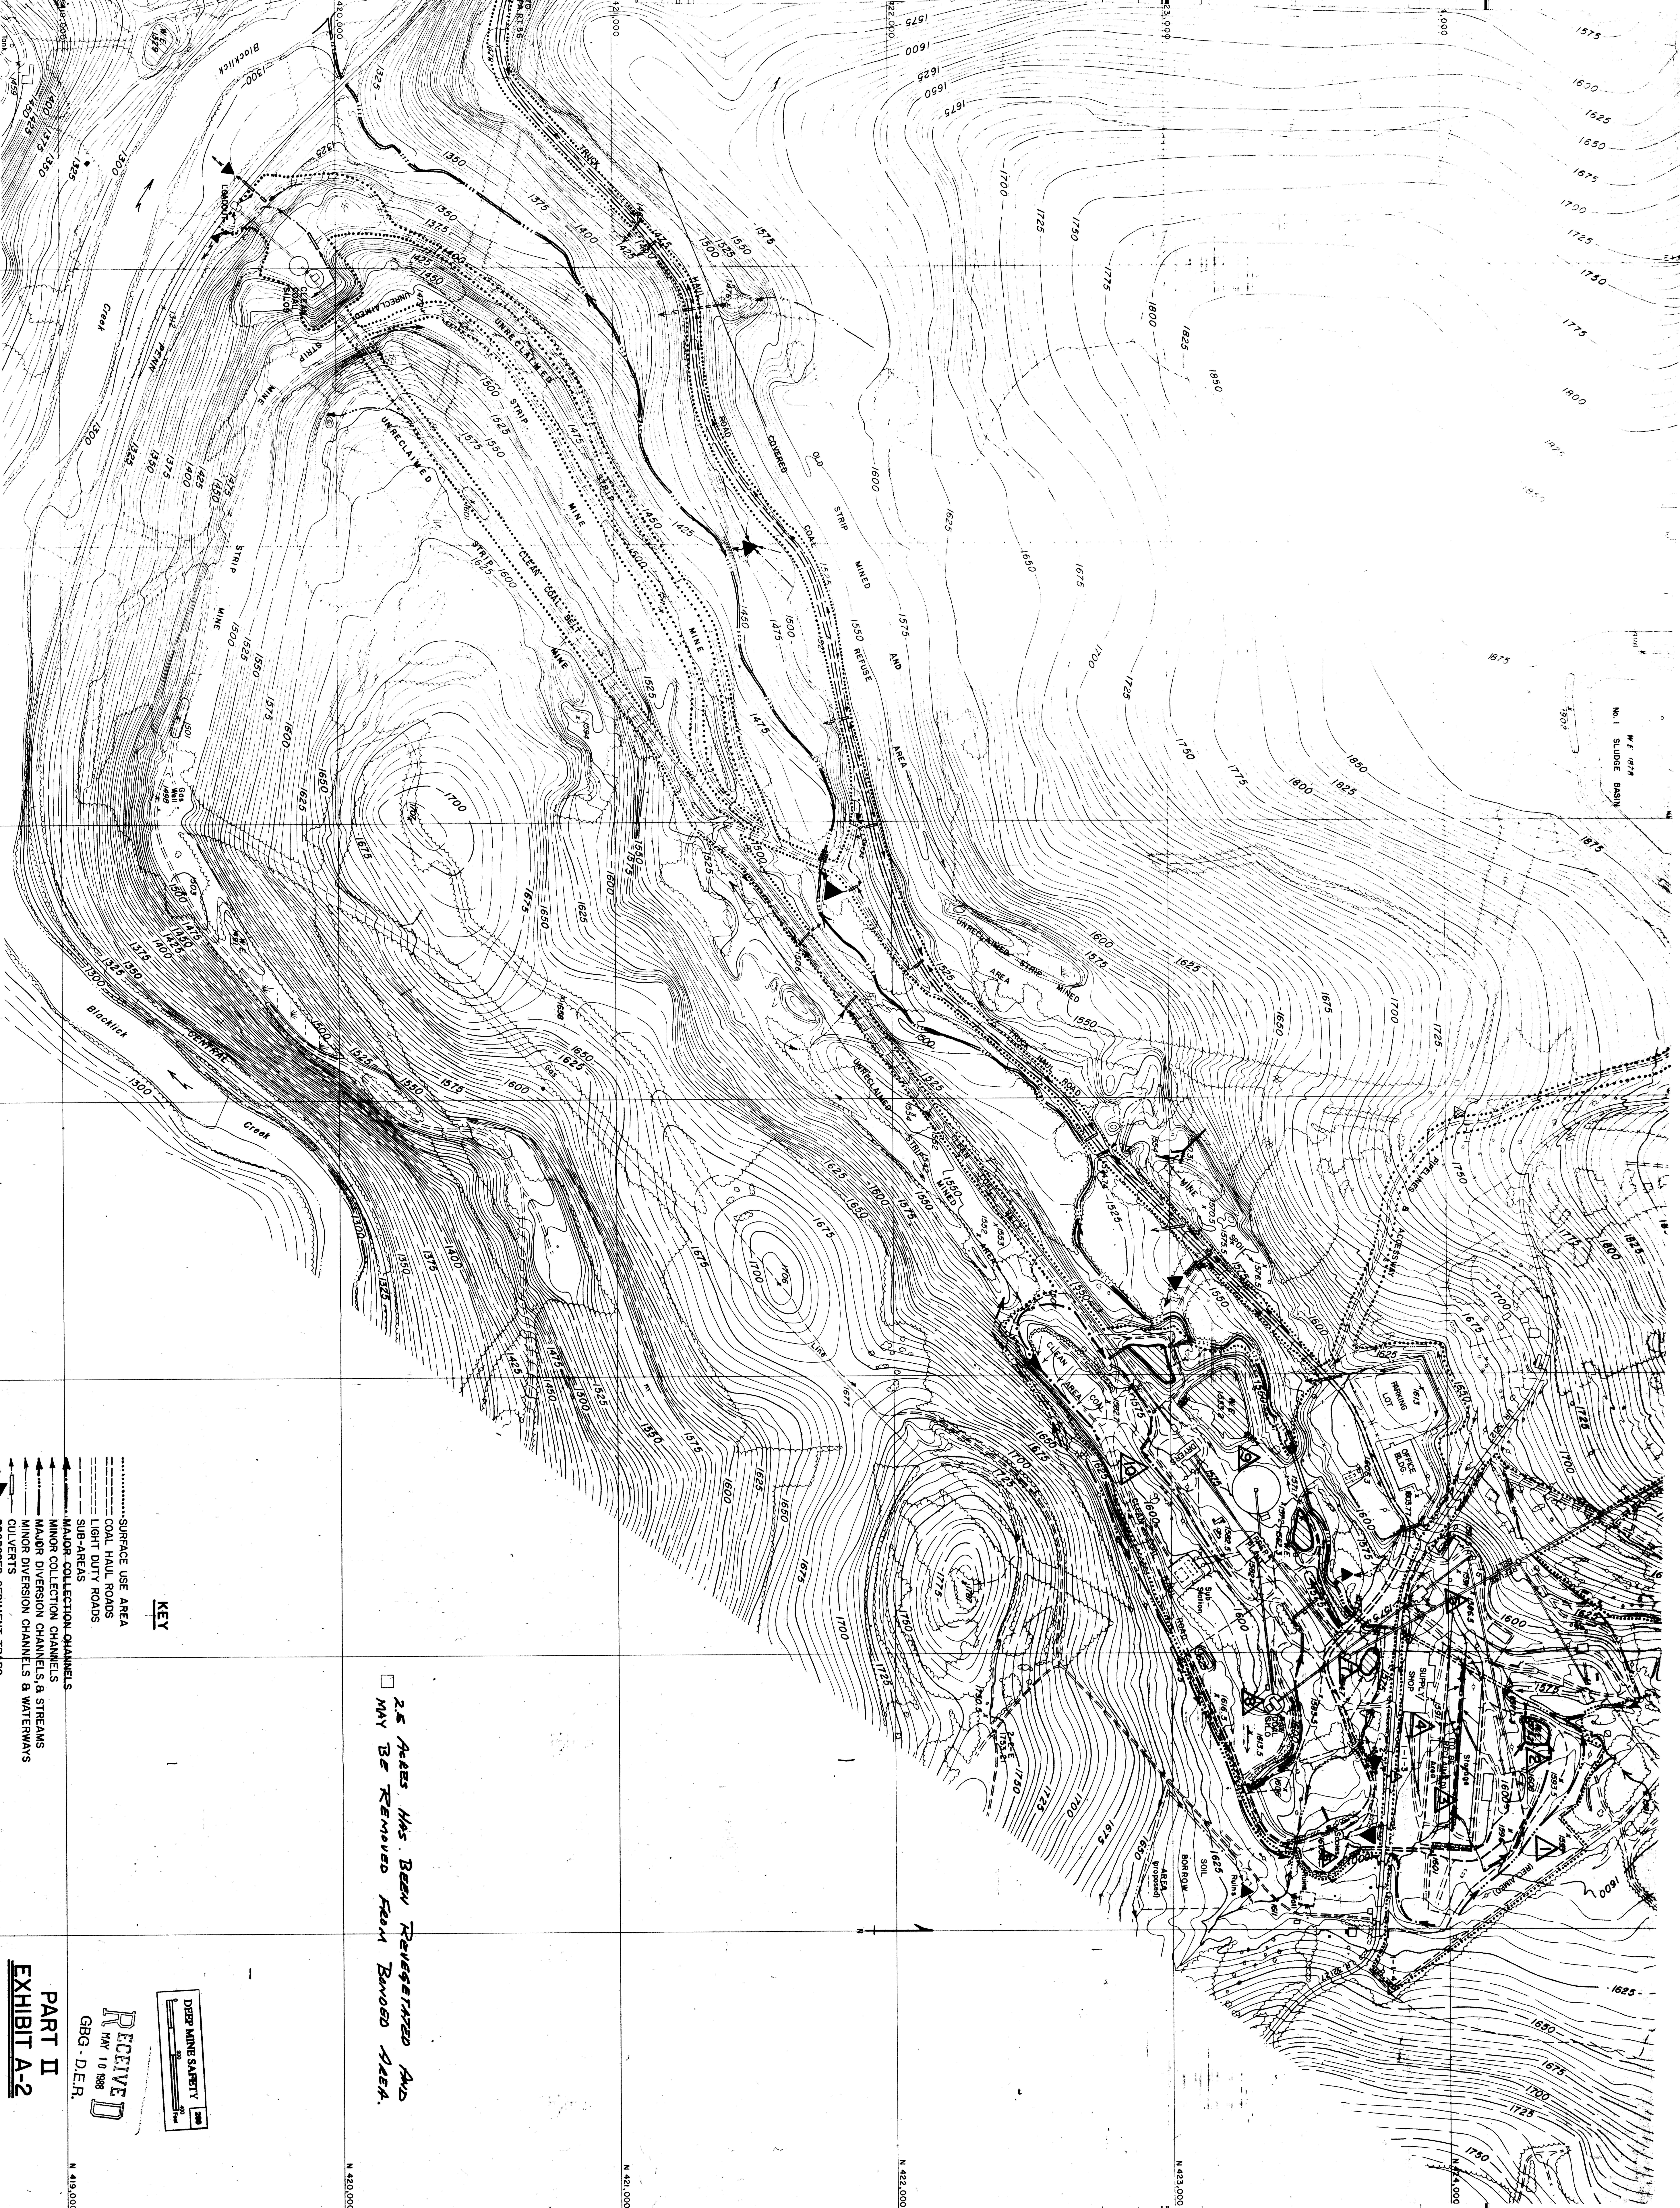

☐ 2.5 ACRES HAS BEEN REVEGETATED AND MAY BE REMOVED FROM BANNED AREA.

DEER MINE SAFETY DIVISION
RECEIVED
MAY 10 1988
GBG - D.E.R.

PART II
EXHIBIT A-2
EROSION/SEDIMENTATION
CONTROL PLAN

BRUSH VALLEY & BUFFINGTON TOWNSHIPS,
INDIANA COUNTY
DATE: JUNE, 1984
DATE REVISED: MAY, 1988

THIS MAP PREPARED BY: L. ROBERT KIMBALL
CONSULTING ENGINEER, EBERSBURG, PENNSYLVANIA
PHOTOGRAPHY DATED OCT. 18, 1982

TOPOGRAPHIC MAP
FOR
PENNYSYLVANIA MINES CORPORATION
DILLTOWN FACILITIES
SCALE: 1"=200'
CONTOUR INTERVAL: 5'