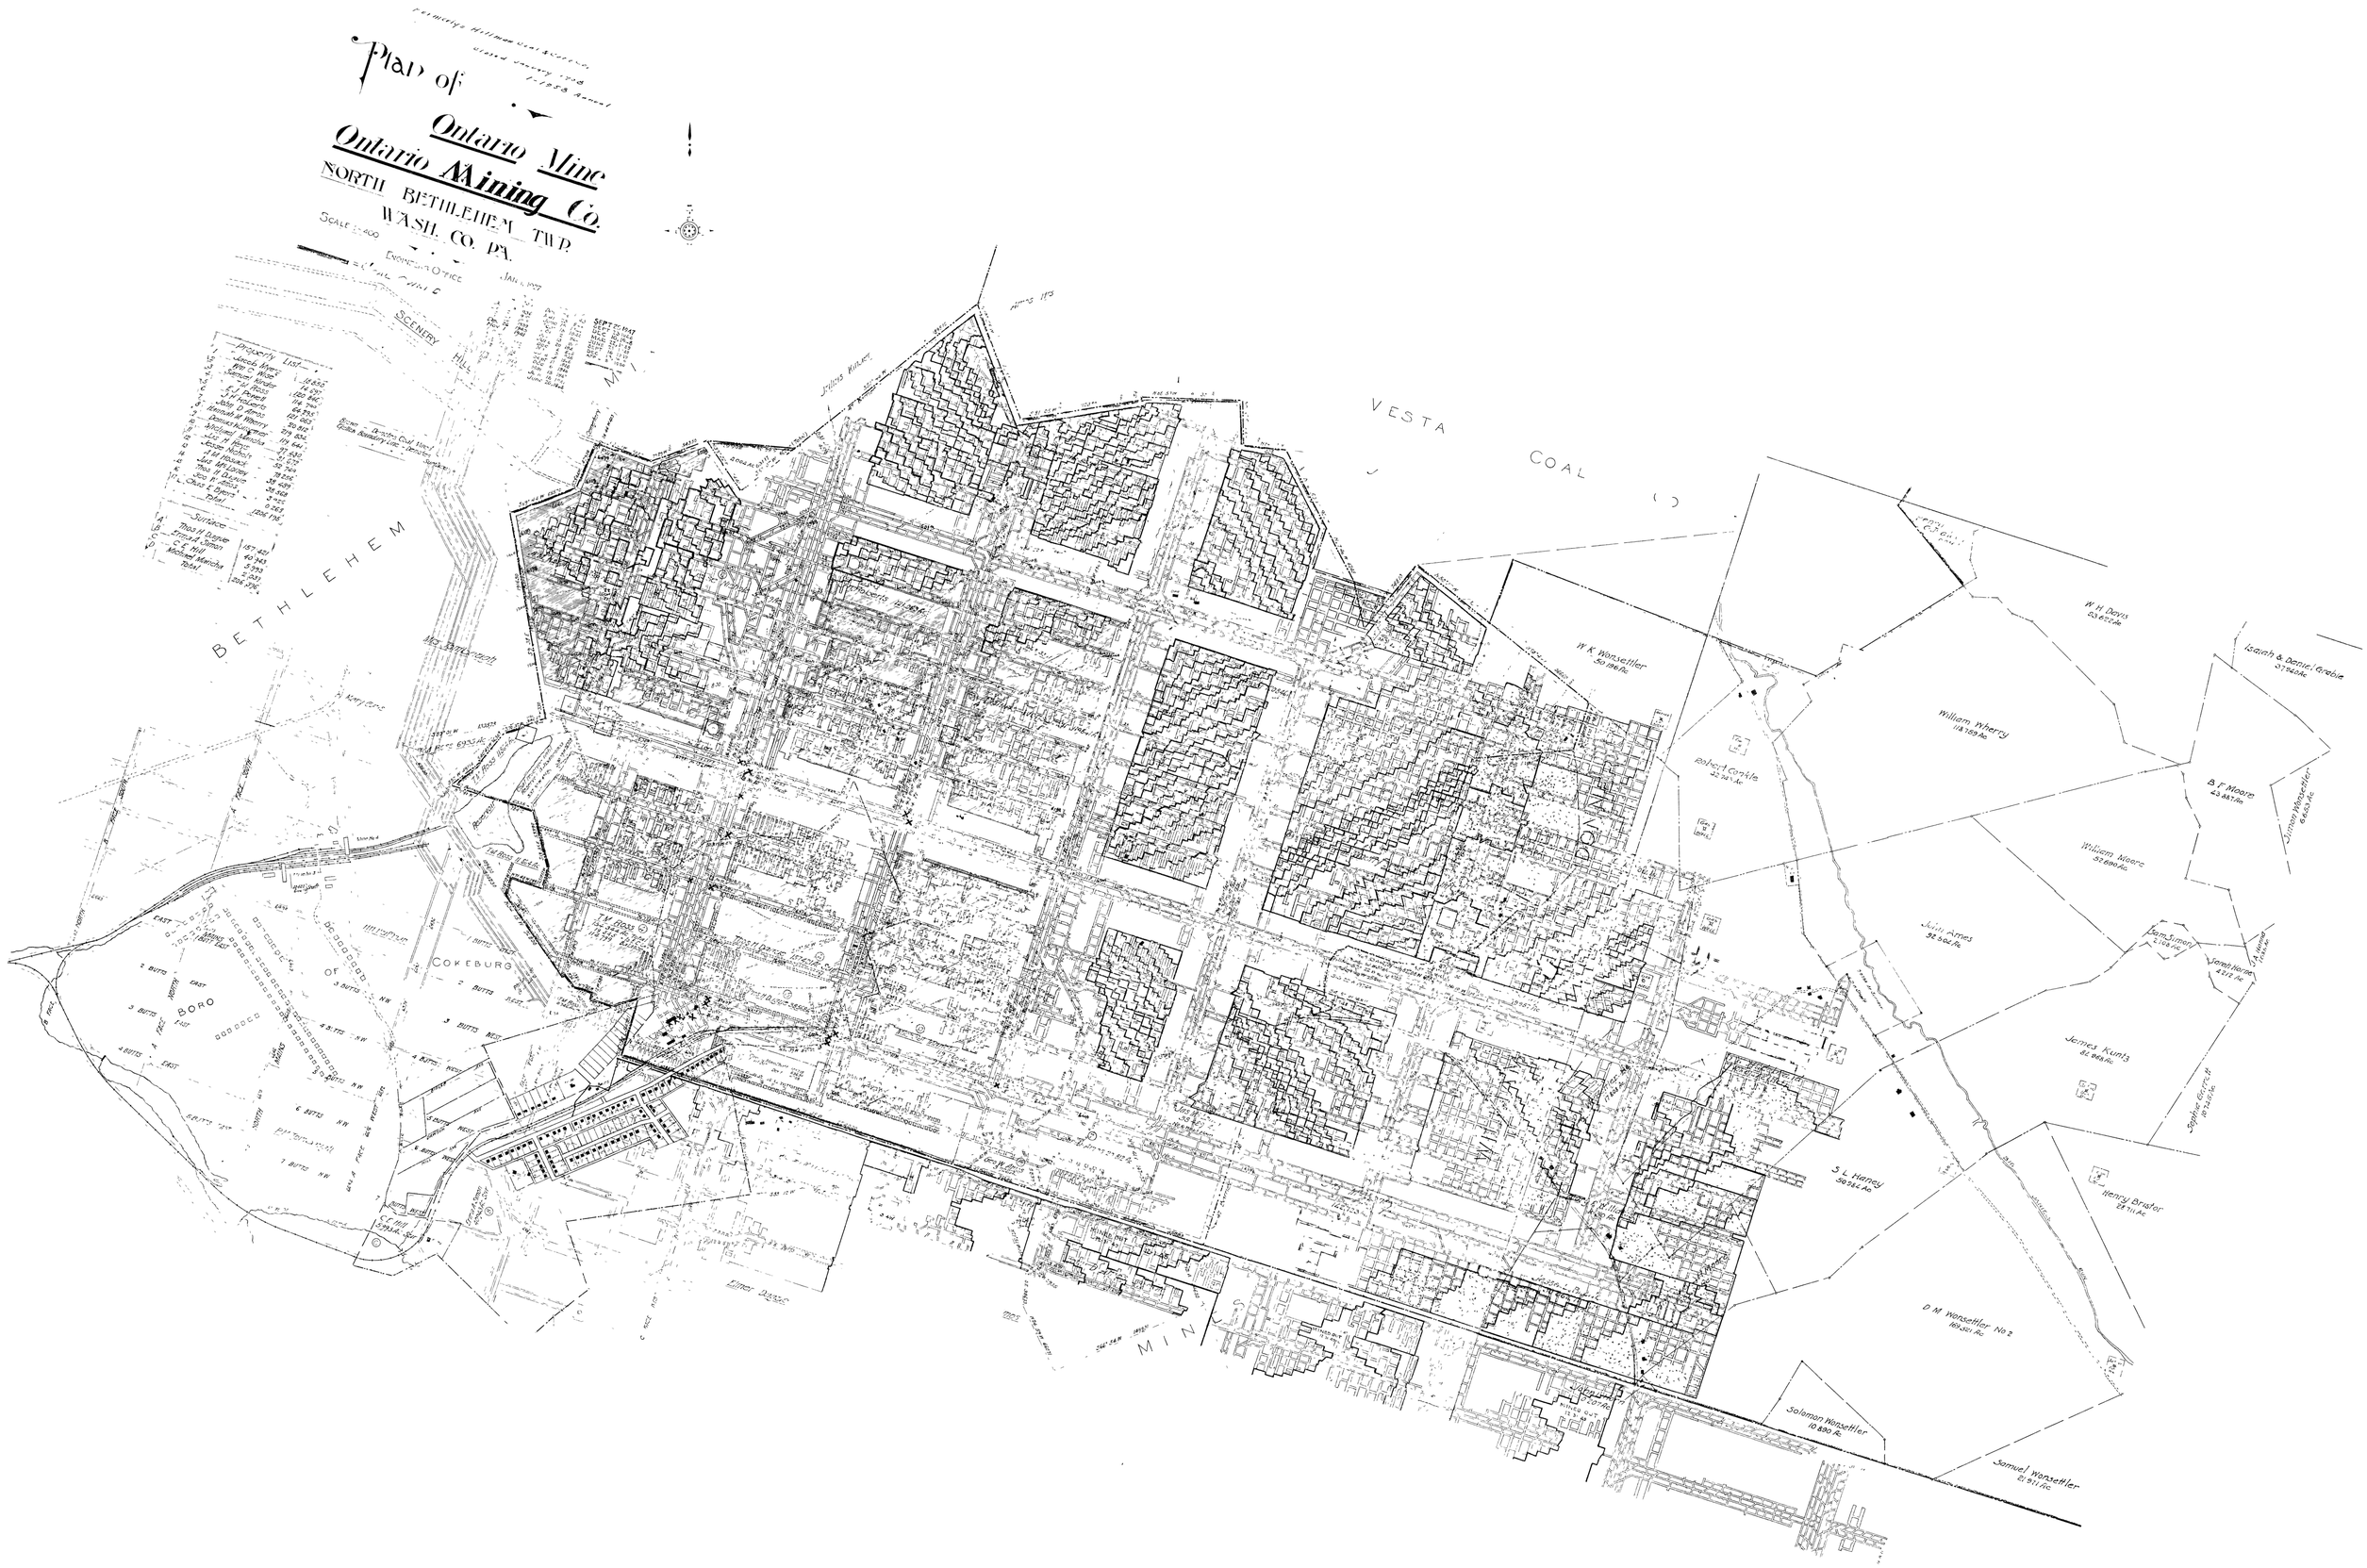
Plan of
Ontario Mine
Ontario Mining Co.
NORTH BETHLEHEM TWP.
WASH. CO. PA.
SCALE 1:600
ENGINEER'S OFFICE
JAN. 1907
Property List
Surface
BETHLEHEM
BORO
COKEBURG
VESTA
COAL
CO
W K Wonsettler
William Wherry
Robert Conkle
W H Davis
Isaiah & Daniel Grable
B F Moore
William Moore
James Wheeler
John Ames
James Kunts
S L Harney
Henry Brister
D M Wonsettler No 2
Solomon Wonsettler
Samuel Wonsettler