


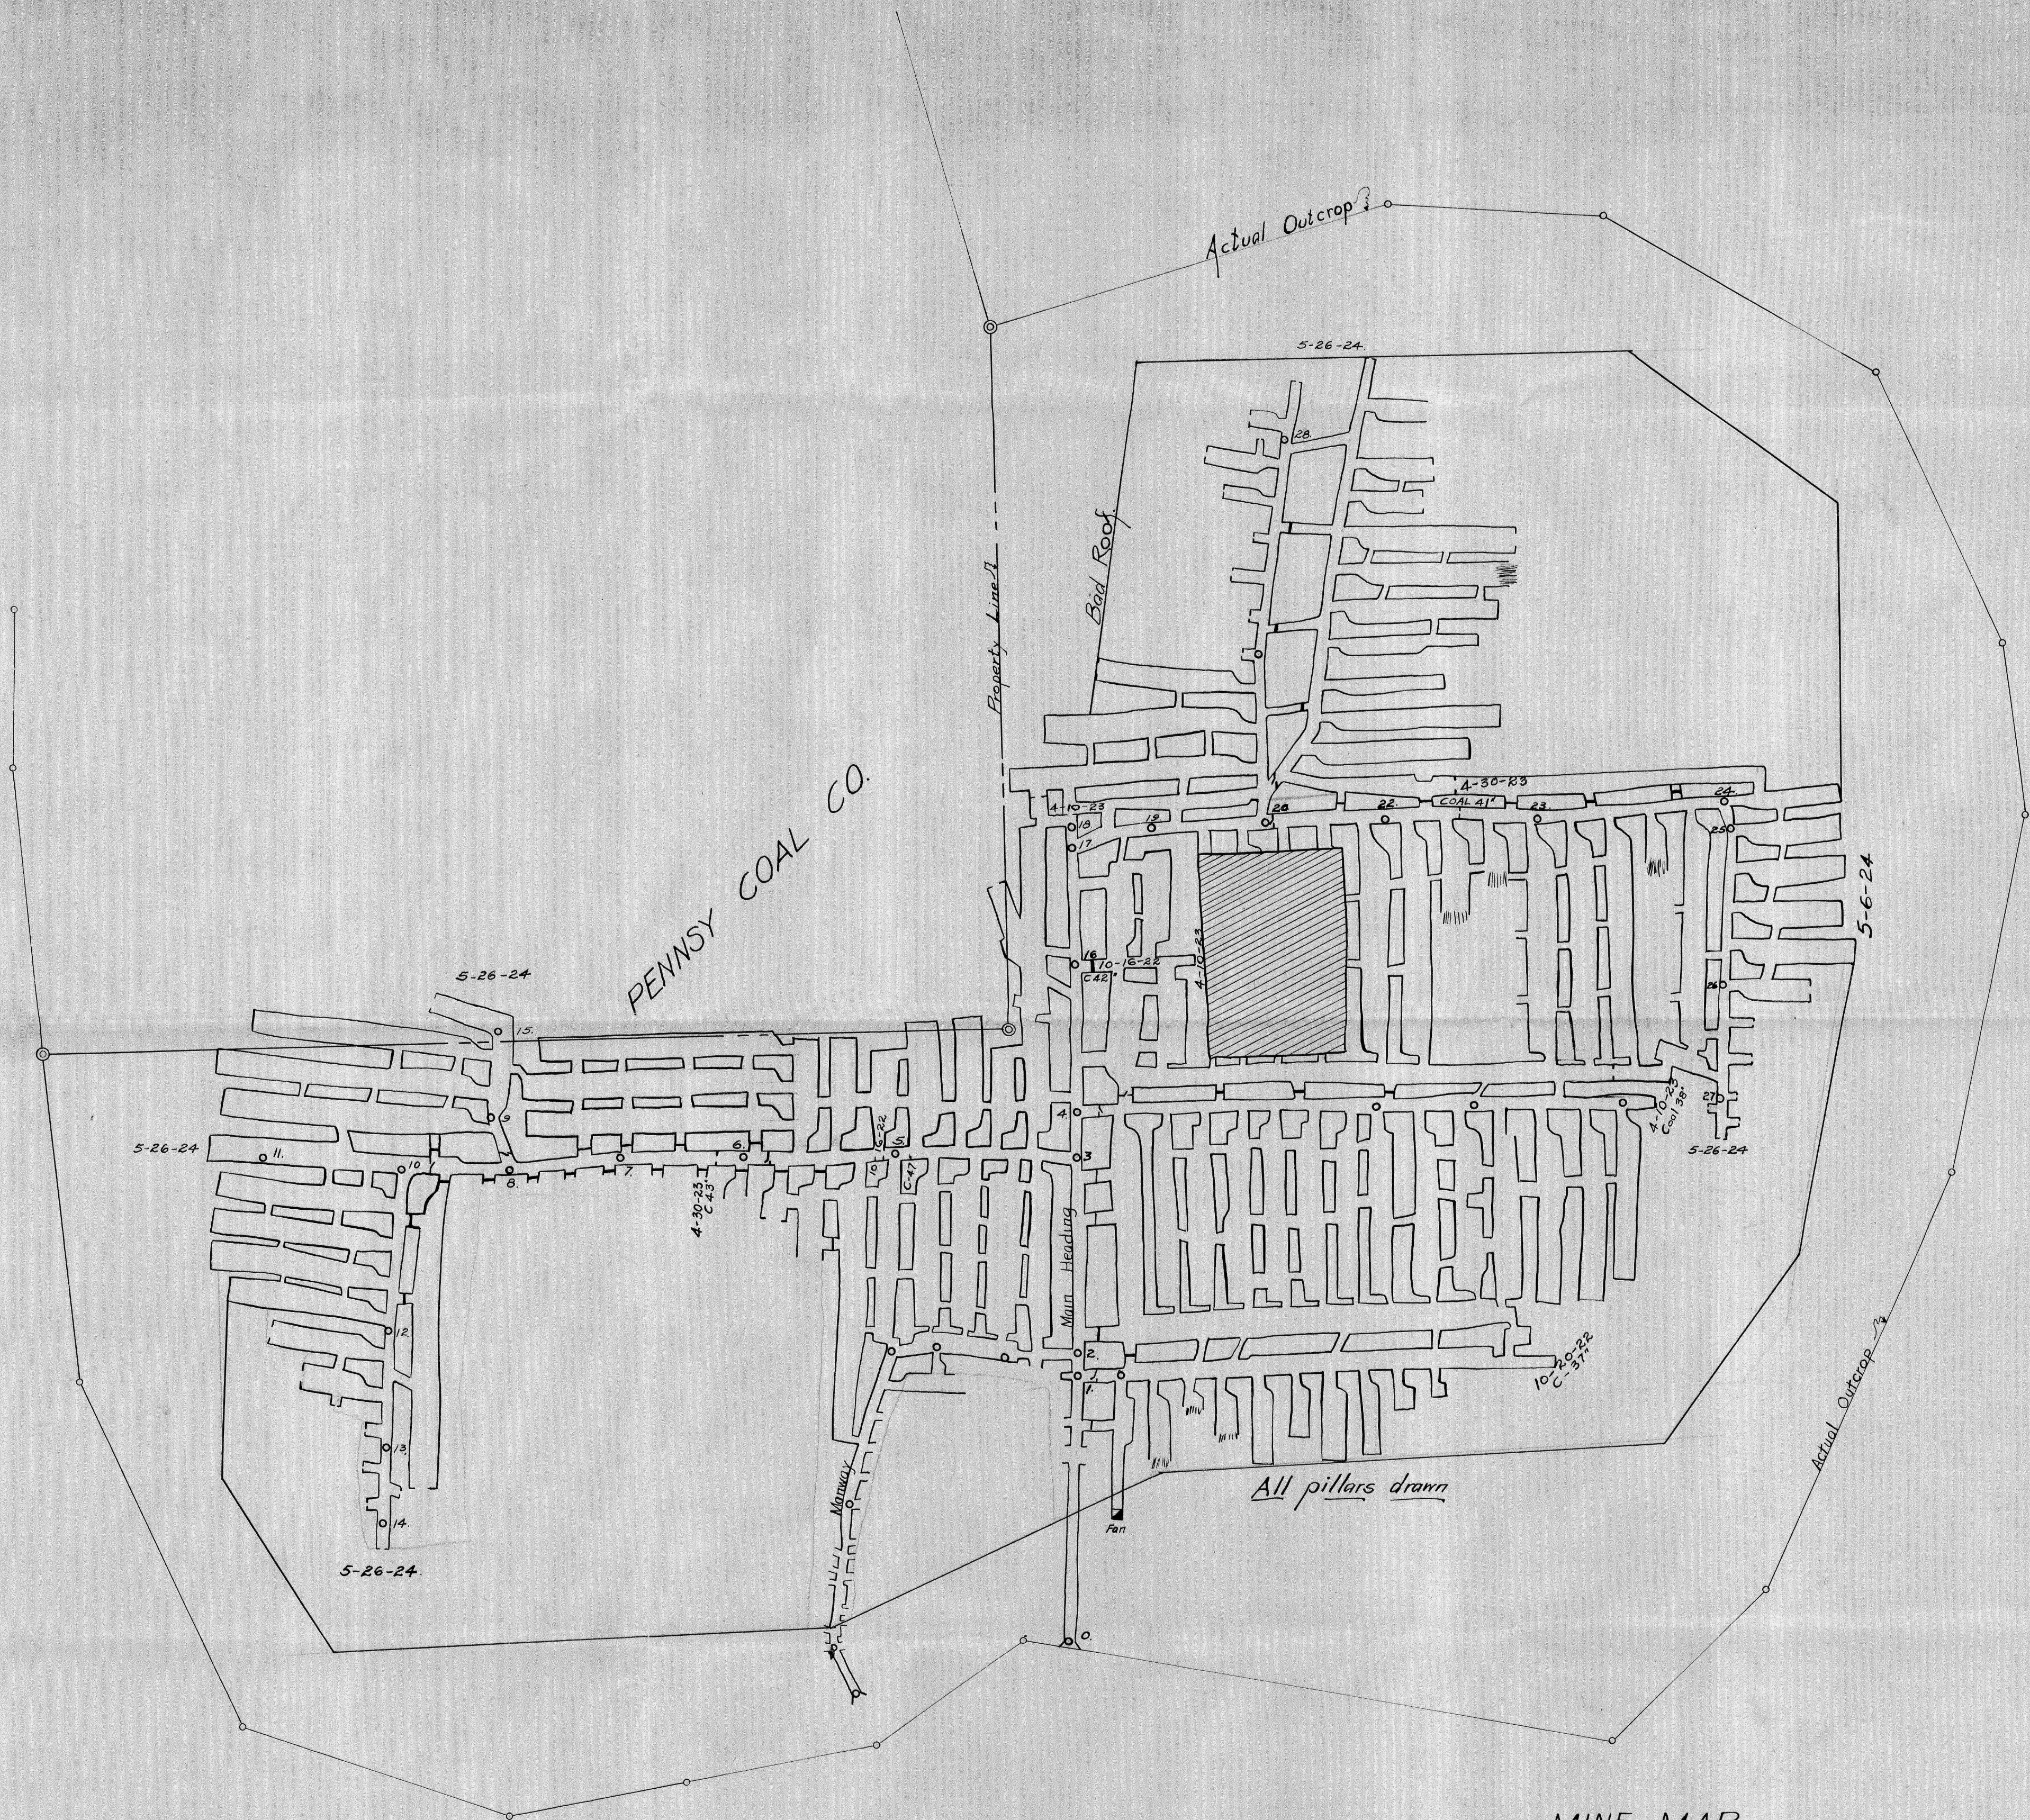

MINE MAP
 ORCHARD COAL CO.
 ALSACE, CLARION CO., PA.
 Scale 1" = 100' MAY 1924
 Charles A. Timel C.E.
 Clarion, Pa.

#1999
 12-23-99
 C.C.