


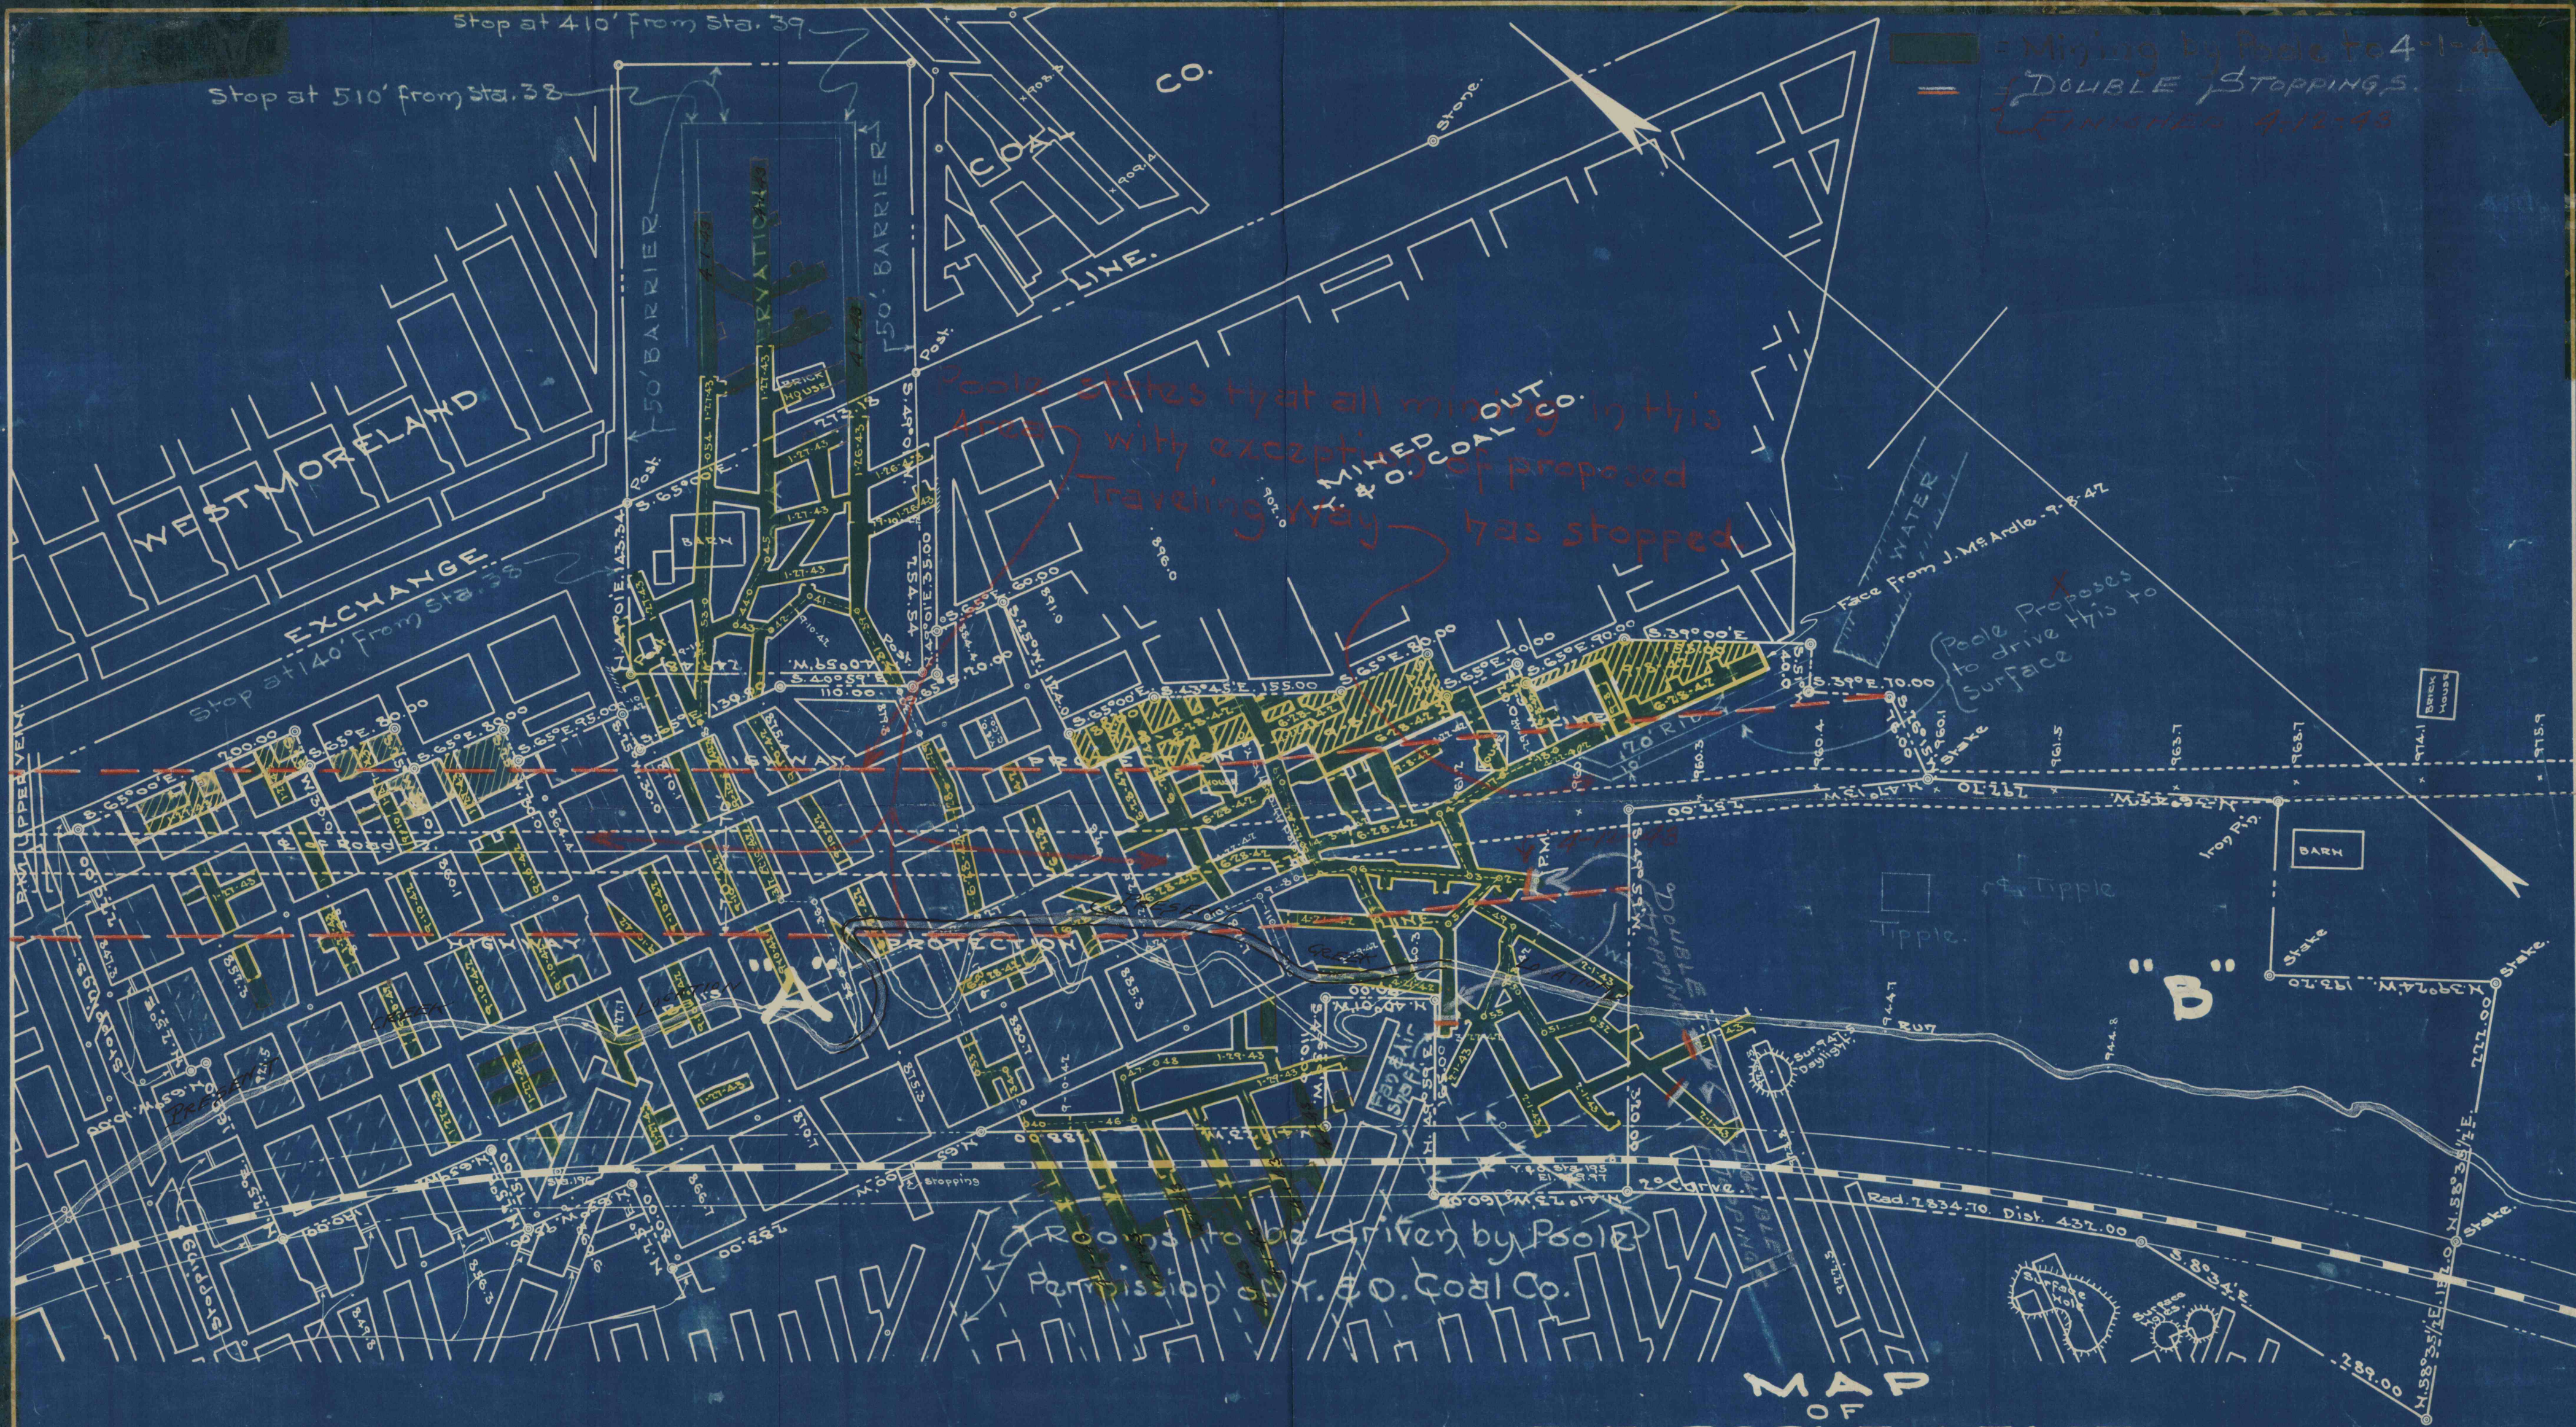

Note:-
Solid Line = Deep Mine Tract.
Dashed Line = Stripping Tract.
Solid Line indicates Y. & O. Mining.
Broken Line indicates Poole's proposed method of mining.

MAP
OF
E.Z. POOLE LEASE.
FROM
Y. & O. COAL CO.
SITUATE IN SOUTH HUNTINGDON TOWNSHIP,
WESTMORELAND COUNTY, PENNA..
Scale 1"=100'
R.R. Ossman, Irwin, Pa. State Reg. #4090.