


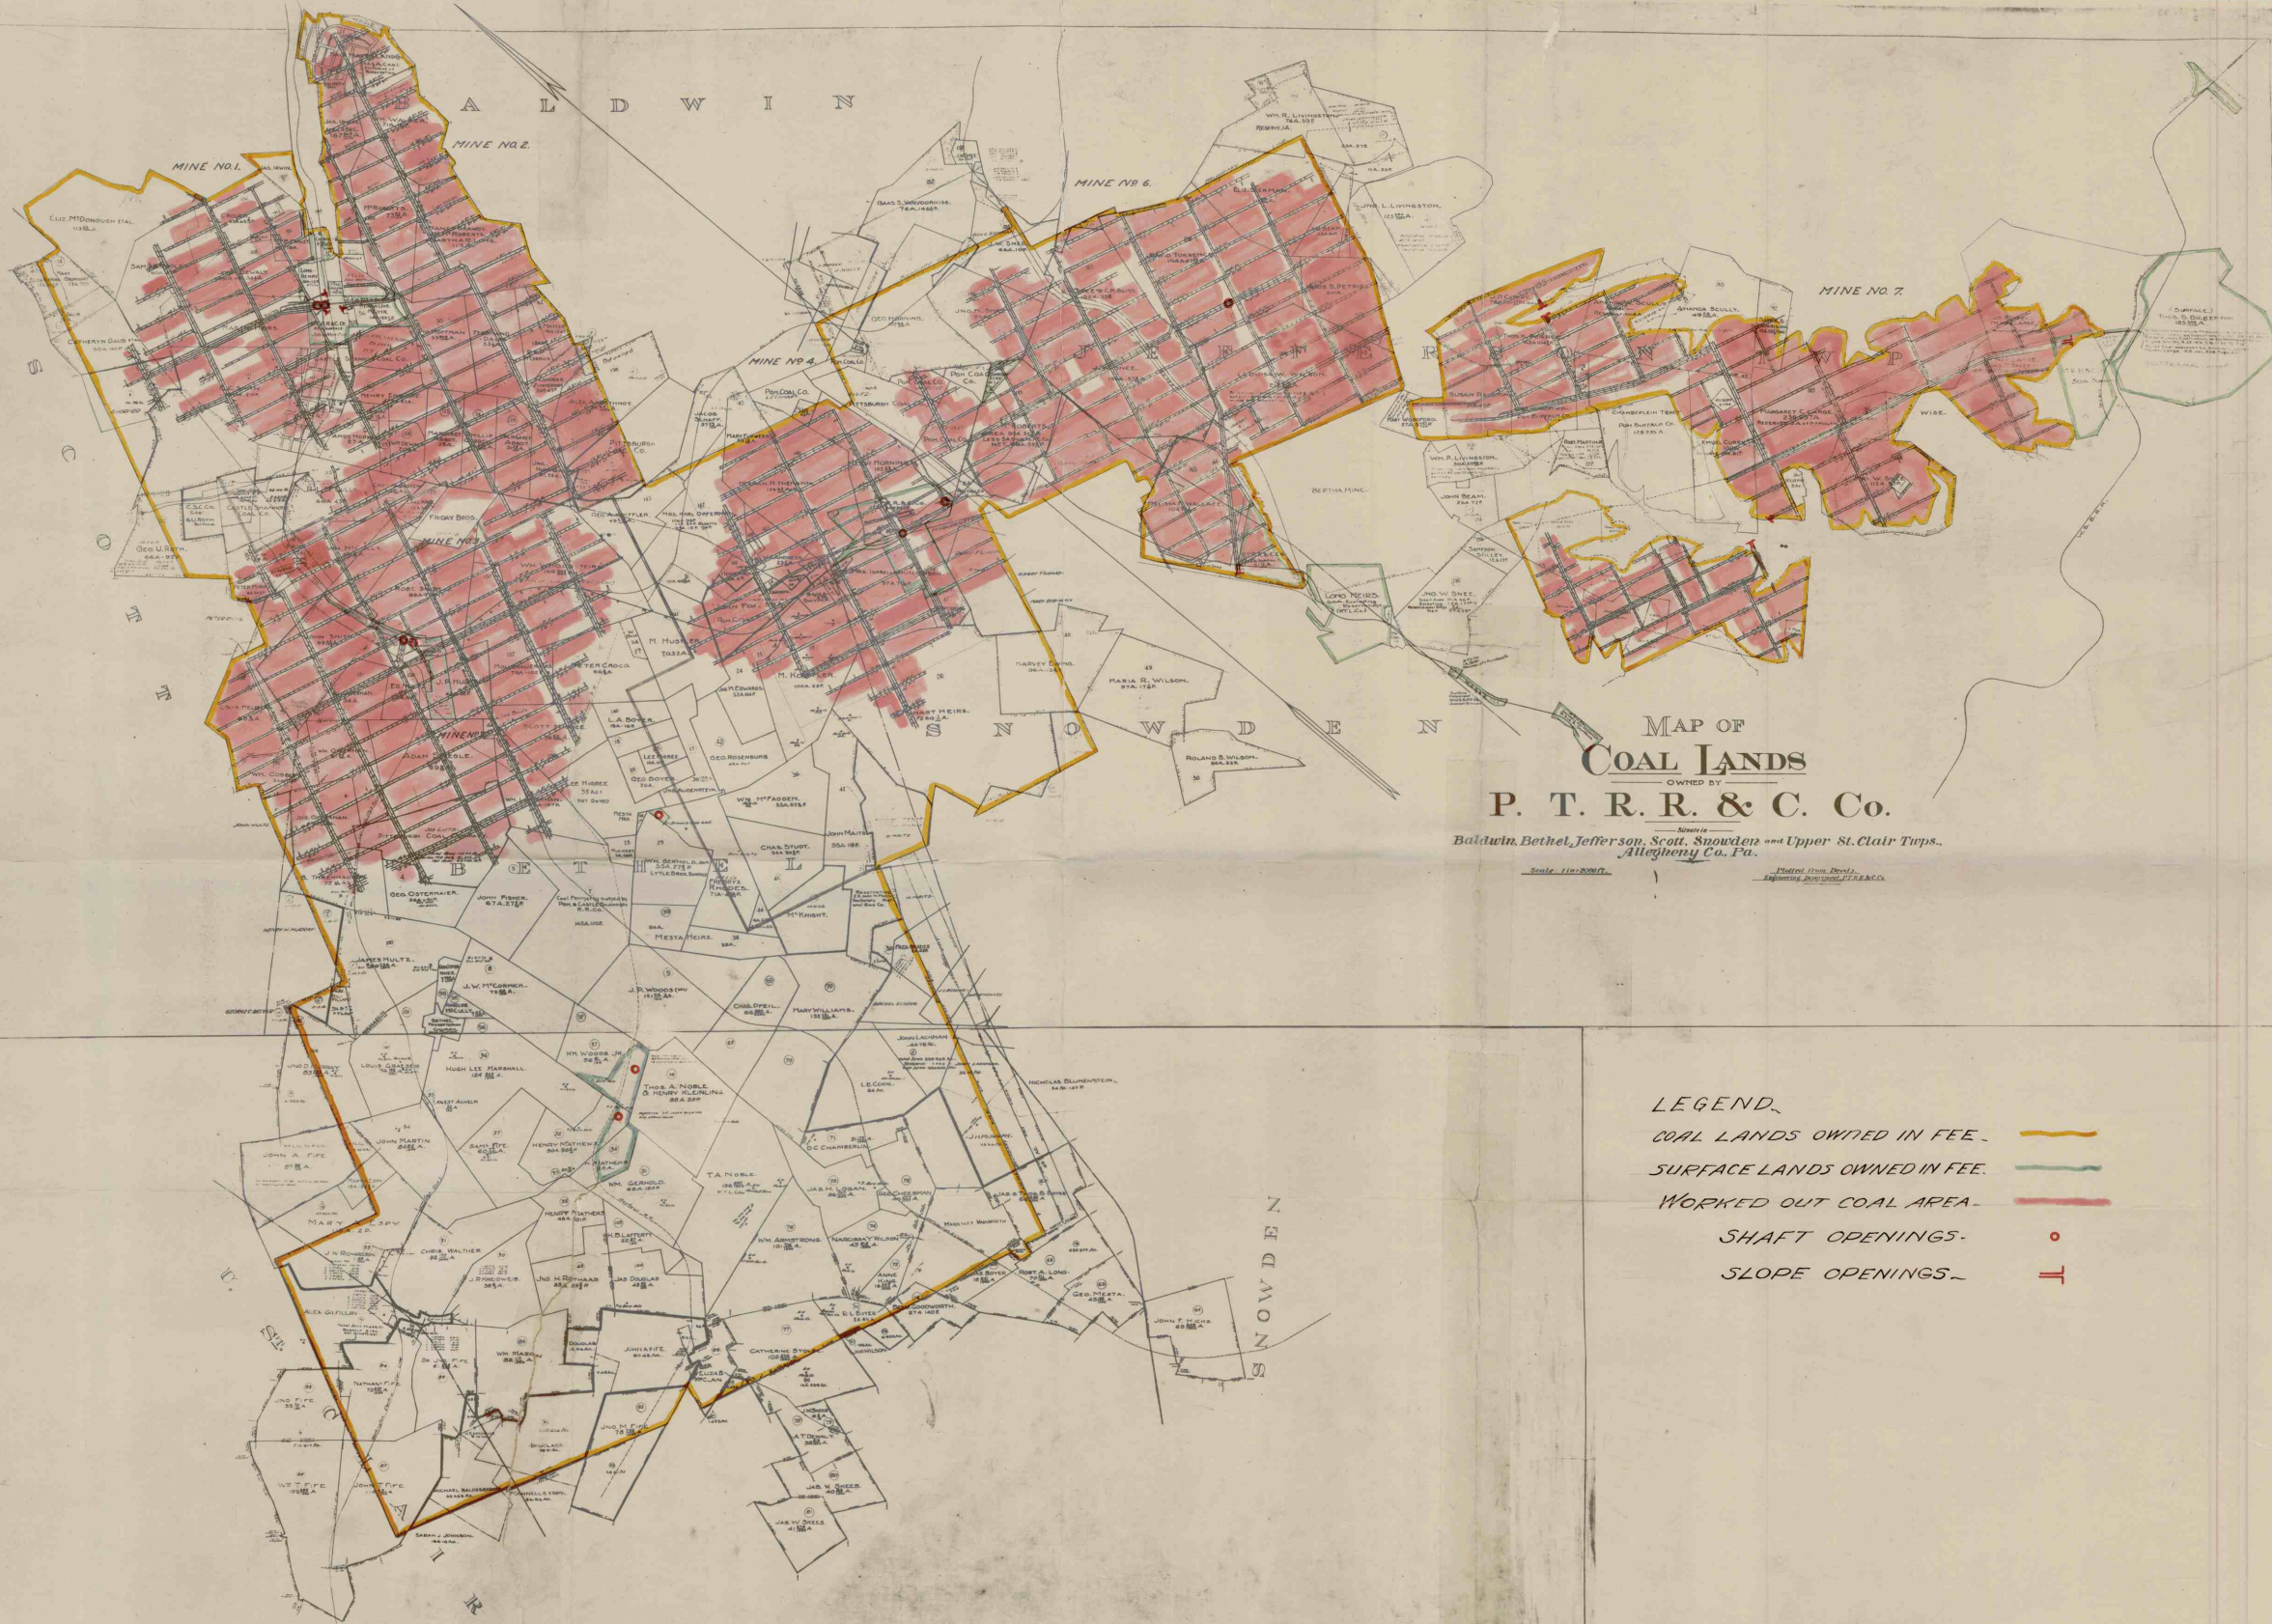

MAP OF
COAL LANDS
OWNED BY
P. T. R. R. & C. Co.
Situated in
Baldwin, Bethel, Jefferson, Scott, Snowden and Upper St. Clair Twp.,
Allegheny Co. Pa.
Scale 1 in = 2000 ft.
Plotted from Deeds,

- LEGEND.
- COAL LANDS OWNED IN FEE. ———
 - SURFACE LANDS OWNED IN FEE. ———
 - WORKED OUT COAL AREA ———
 - SHAFT OPENINGS. —●—
 - SLOPE OPENINGS. —|—