



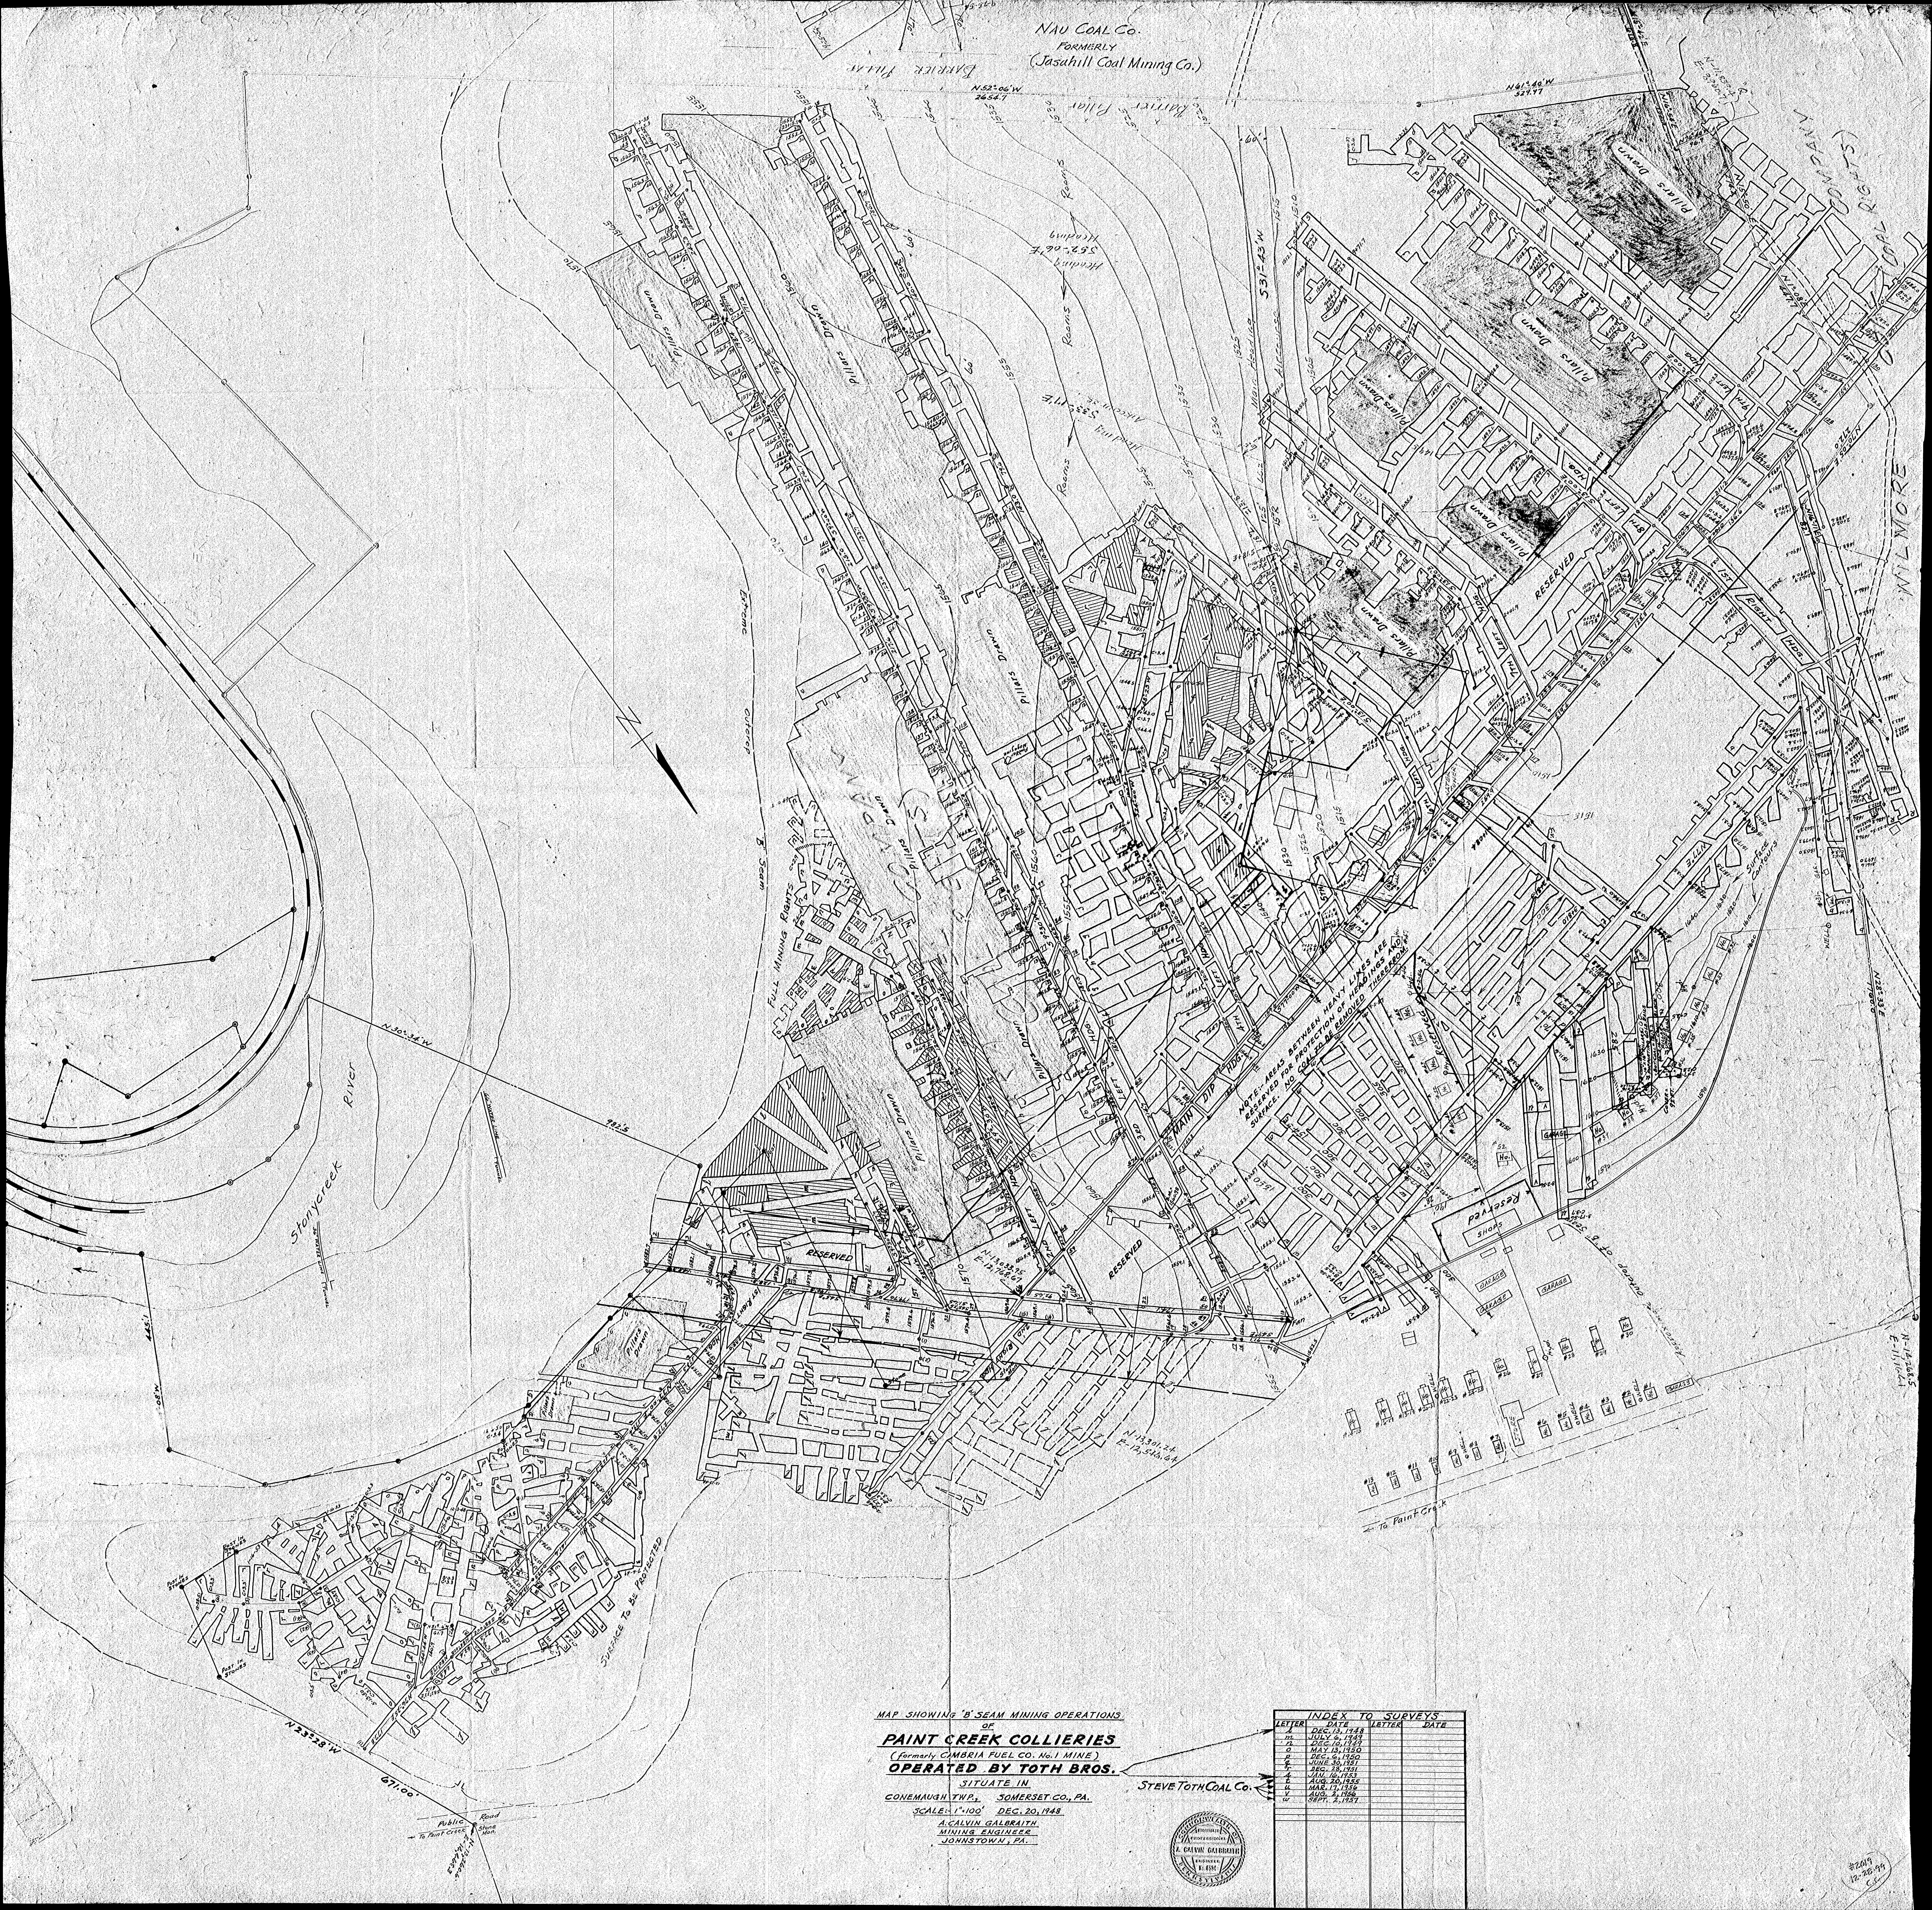

NAU COAL Co.
FORMERLY
(Jasuhill Coal Mining Co.)

MAP SHOWING 'B' SEAM MINING OPERATIONS
PAINT CREEK COLLIERIES
(formerly CUMBRIA FUEL CO. No. 1 MINE)
OPERATED BY TOTH BROS.
SITUATE IN
CONEMAUGH TWP., SOMERSET CO., PA.
SCALE: 1"=100' DEC. 20, 1948
A. CALVIN GALBRAITH
MINING ENGINEER
JOHNSTOWN, PA.

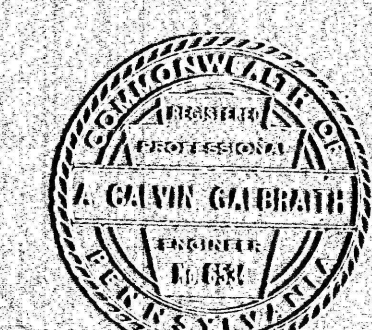

STEVE TOTH COAL Co.

INDEX TO SURVEYS	
LETTER	DATE
A	DEC. 13, 1948
B	JULY 4, 1949
C	DEC. 10, 1949
D	MAY 10, 1950
E	DEC. 9, 1950
F	AUG. 20, 1950
G	DEC. 18, 1951
H	AUG. 20, 1955
I	MAY 17, 1956
J	AUG. 1, 1956
K	SEPT. 1, 1957