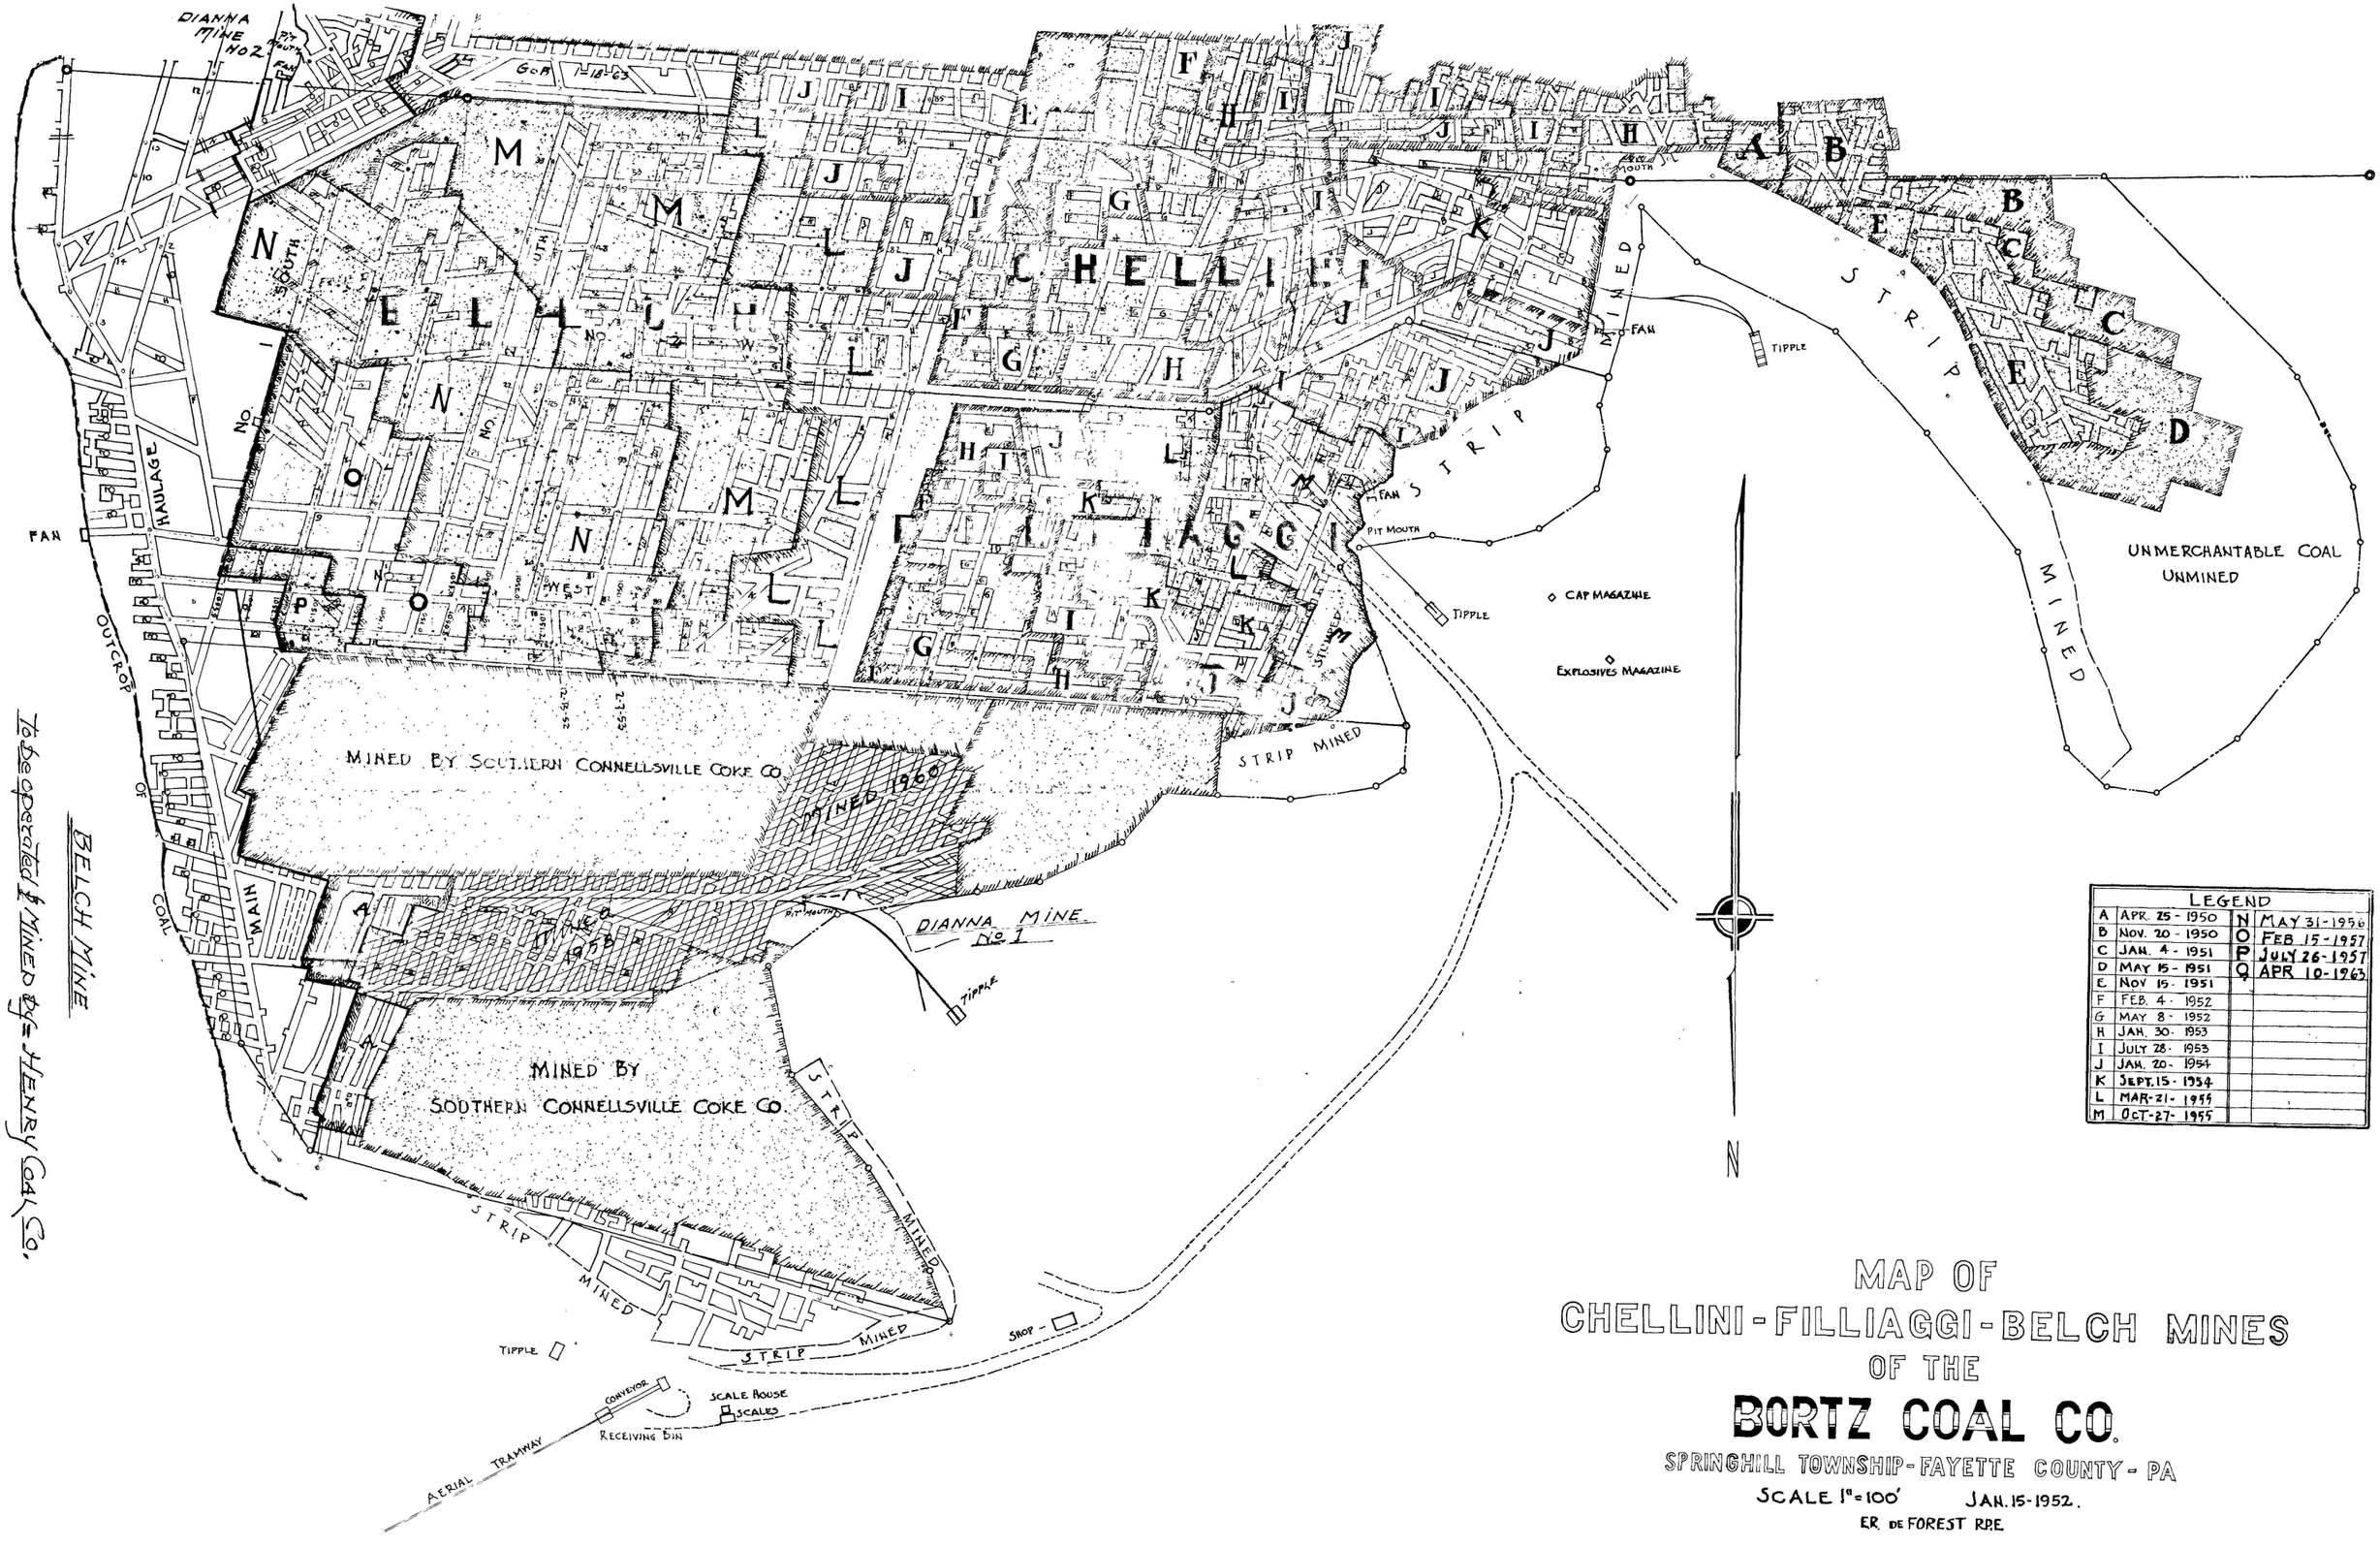

LEGEND			
A	APR. 25 - 1950	N	MAY 31 - 1956
B	NOV. 20 - 1950	O	FEB 15 - 1957
C	JAN. 4 - 1951	P	JULY 26 - 1957
D	MAY 15 - 1951	Q	APR 10 - 1963
E	NOV 15 - 1951		
F	FEB. 4 - 1952		
G	MAY 8 - 1952		
H	JAN. 30 - 1953		
I	JULY 28 - 1953		
J	JAN. 20 - 1954		
K	SEPT. 15 - 1954		
L	MAR. 21 - 1955		
M	OCT. 27 - 1955		

MAP OF CHELLINI - FILLIAGGI - BELCH MINES OF THE BORTZ COAL CO.

SPRINGHILL TOWNSHIP - FAYETTE COUNTY - PA

SCALE 1" = 100' JAN. 15 - 1952.

E.R. DE FOREST R.P.E.

BELCH MINE

To be operated & mined by HENRY COAL CO.

