


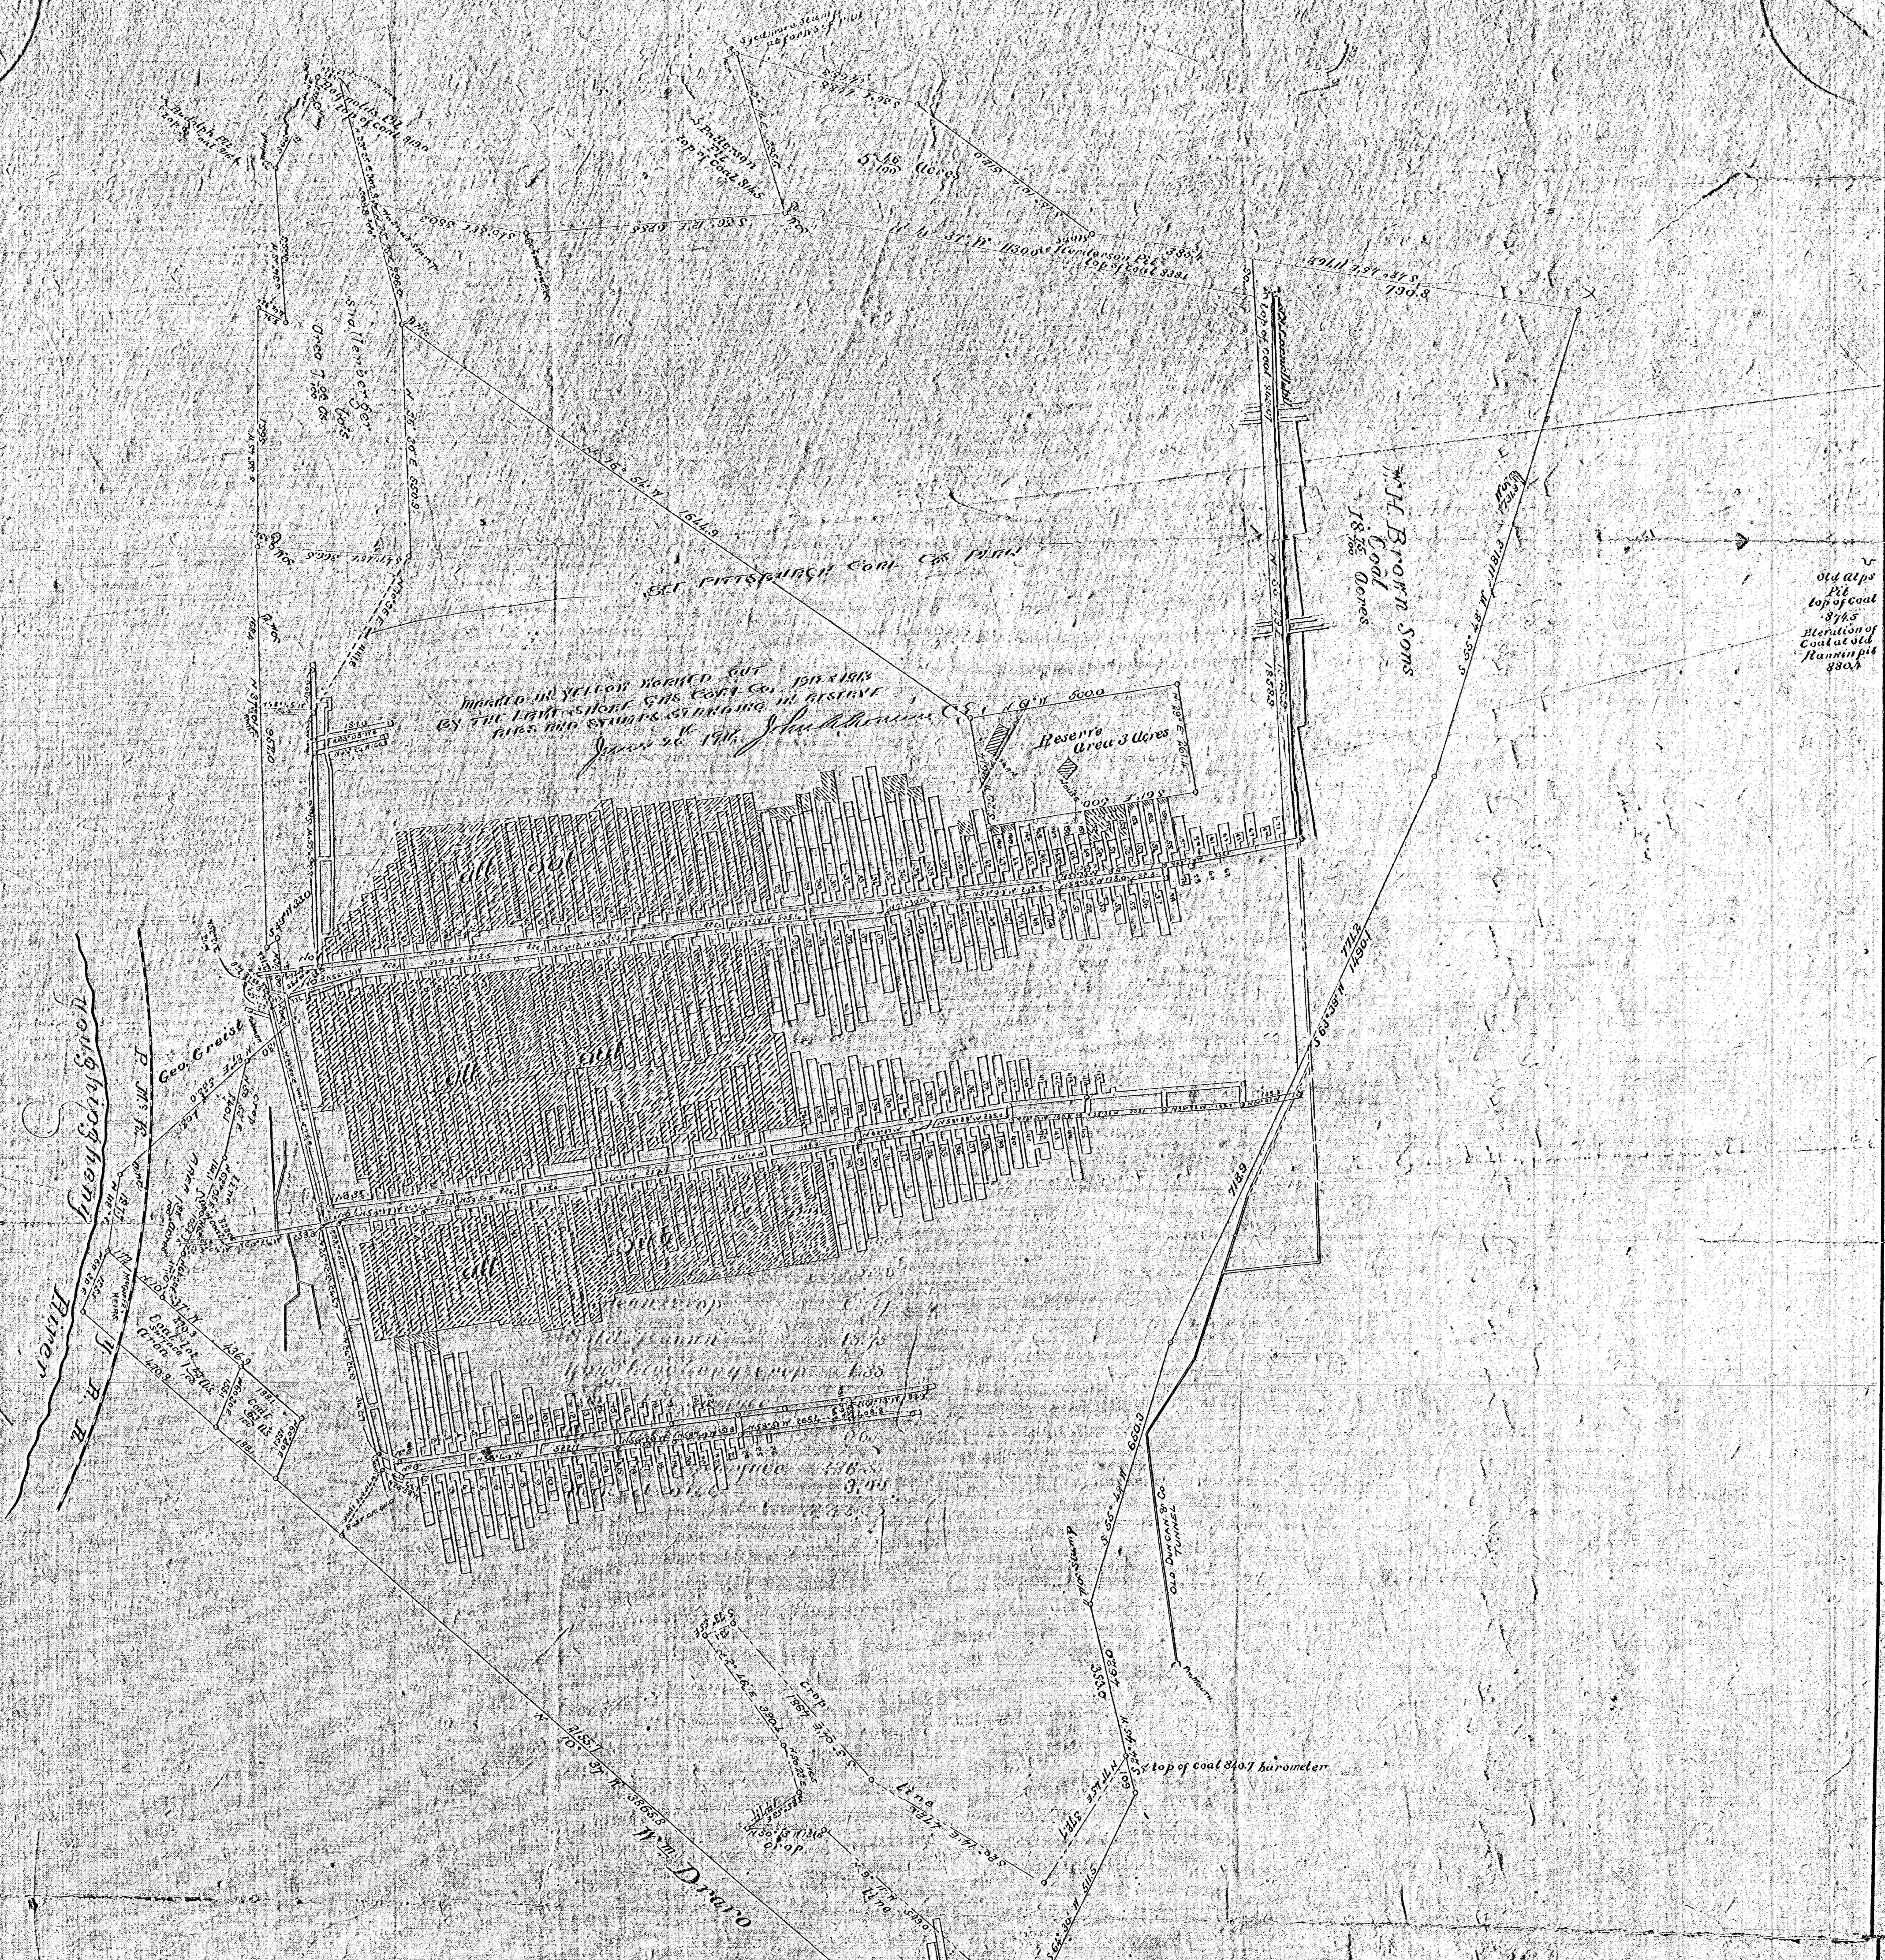

PLAN SHOWING PROPERTY OF PAINTER-CORNELL

Situate in Elizabeth Township, Allegheny

County Pa.
Sept. 1891 Taylor & Downing & Scott
Extended to Dec. 1891 C. H. Newport Pa.

Scale 1" = 200'

1891
1892
1893
1894