



PALMER
H.C. FRICK COKE CO.

FAYETTE COUNTY PA.
SCALE
0 500 1000 1500 2000
Feet

DATE OF LAST SURVEY 11/21/21

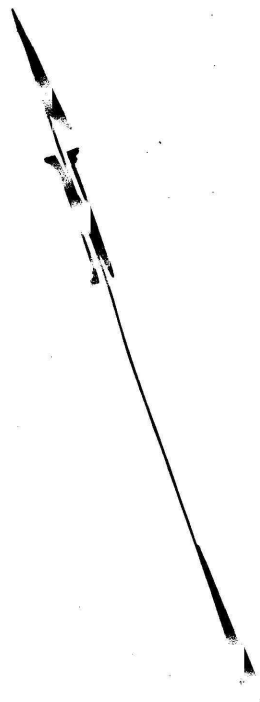

CONNELLSVILLE

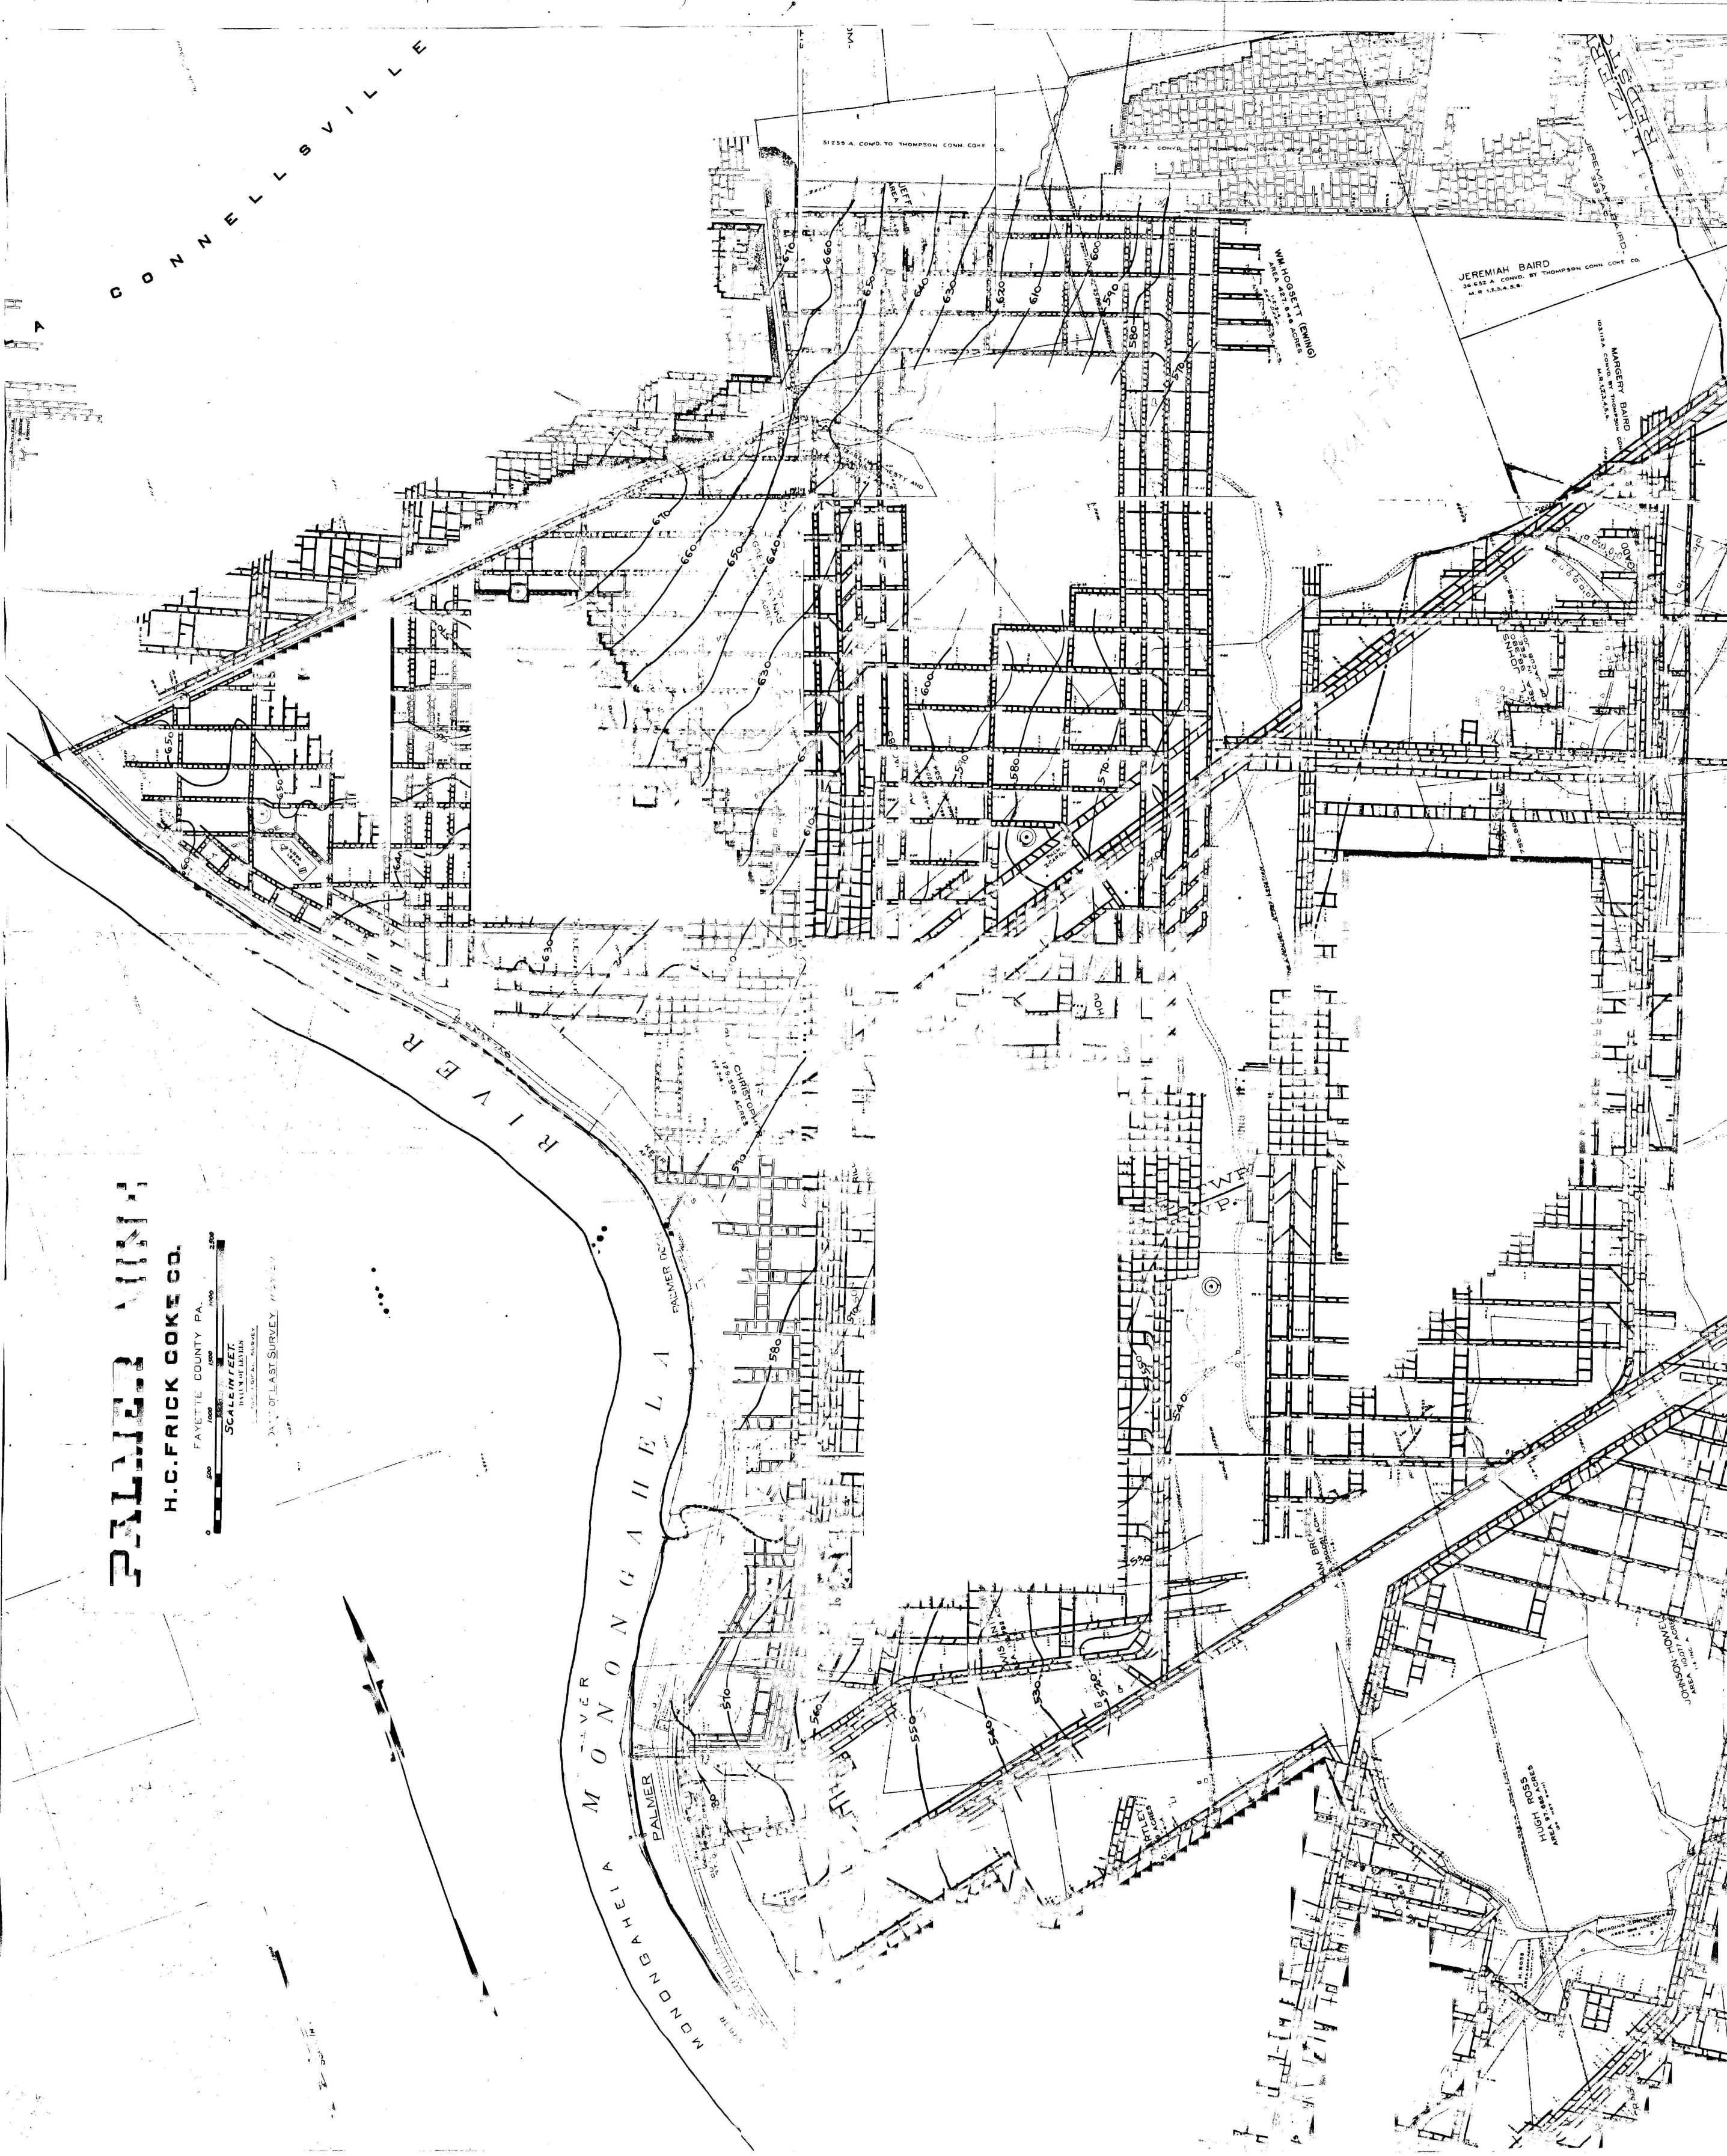

JEREMIAH BAIRD
18652 A. CONVD. BY THOMPSON CONN. COKE CO.

MARSEY BAIRD
18652 A. CONVD. BY THOMPSON CONN. COKE CO.

JOHNSON

HIGH ROSS