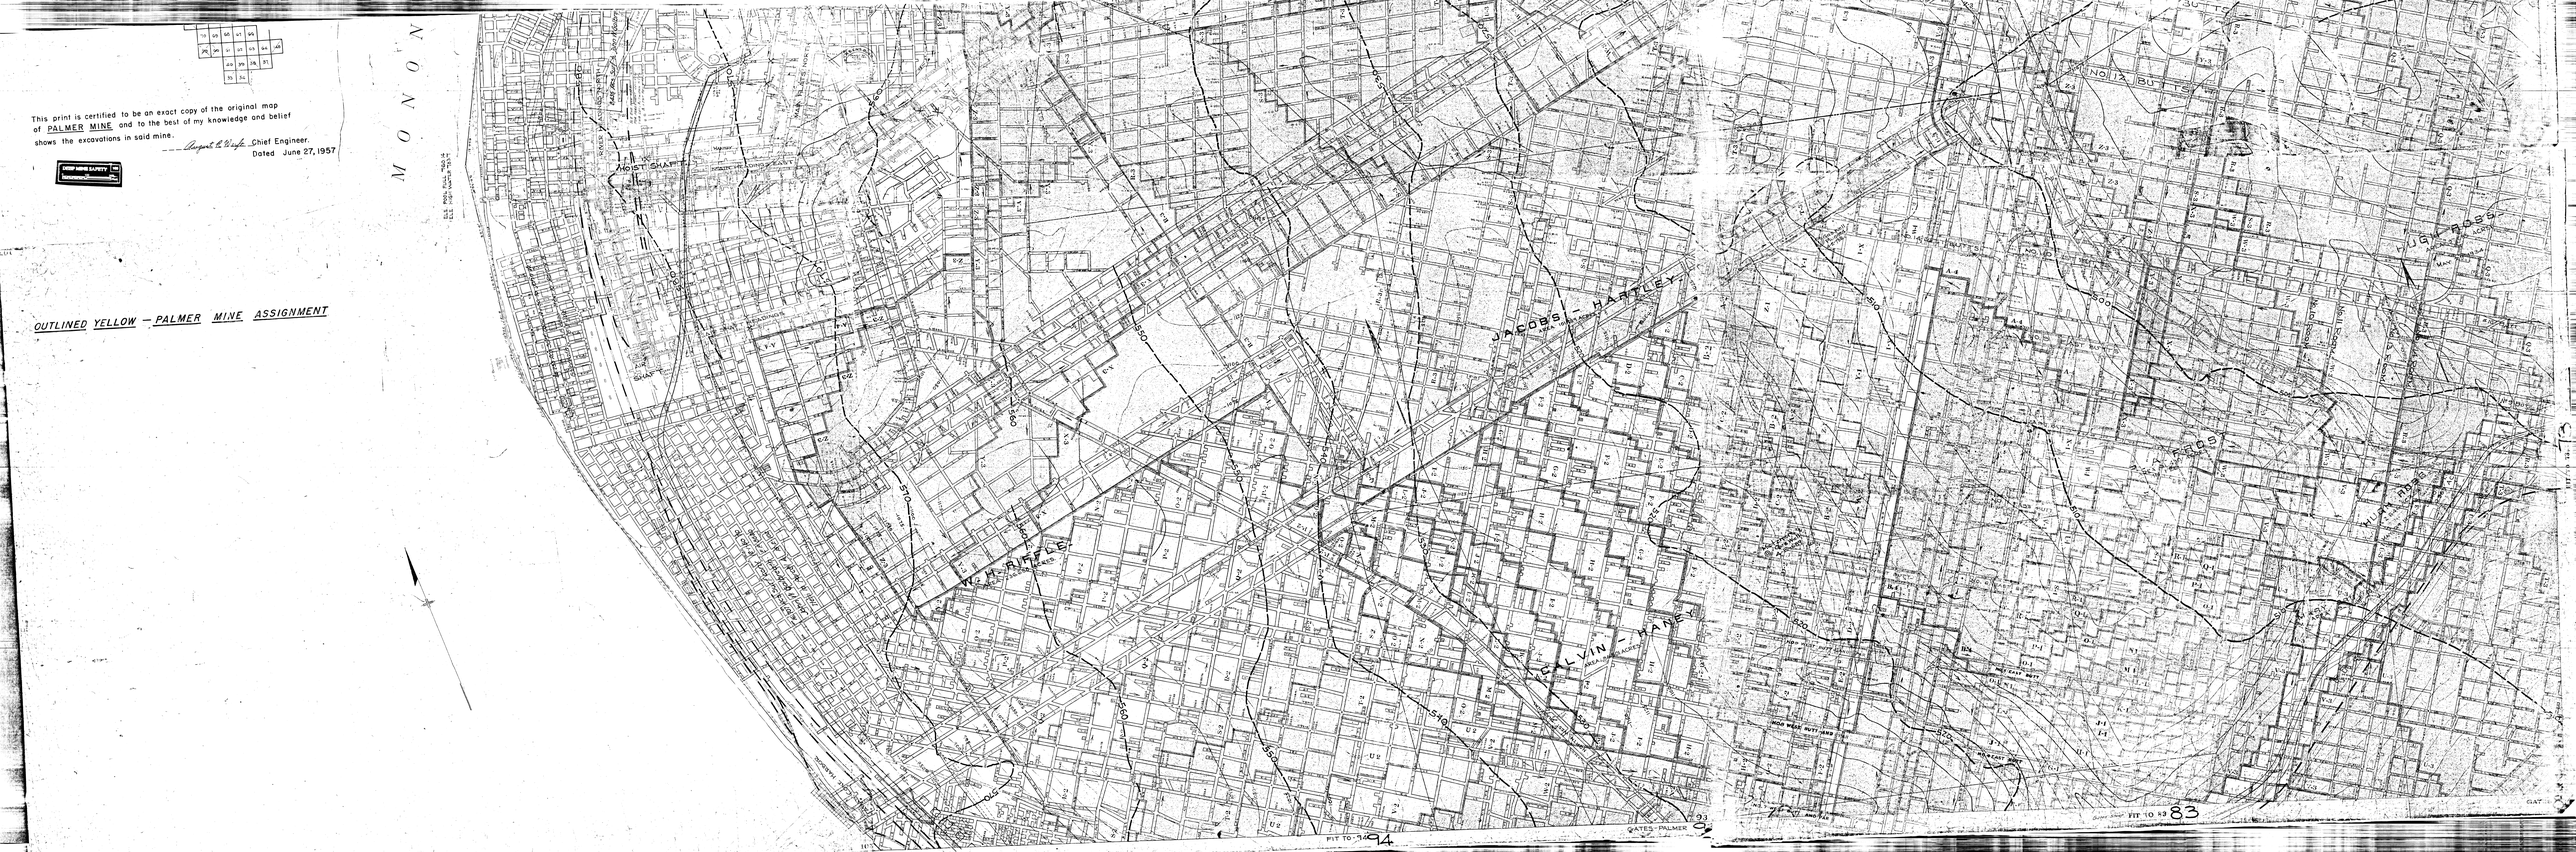

This print is certified to be an exact copy of the original map of PALMER MINE and to the best of my knowledge and belief shows the excavations in said mine.
August L. Wirfs Chief Engineer.
Dated June 27, 1957
OUTLINED YELLOW — PALMER MINE ASSIGNMENT
MONON
SHAFT
JACOBS - HARTLEY
W.H. RIFFLE
PIT TO 83
GATES - PALMER