


H. J. Brown
47 1/2 ac.

J. C. C. Co.
47 1/2 ac.

A. A. Co.
47 ac.

TR 479

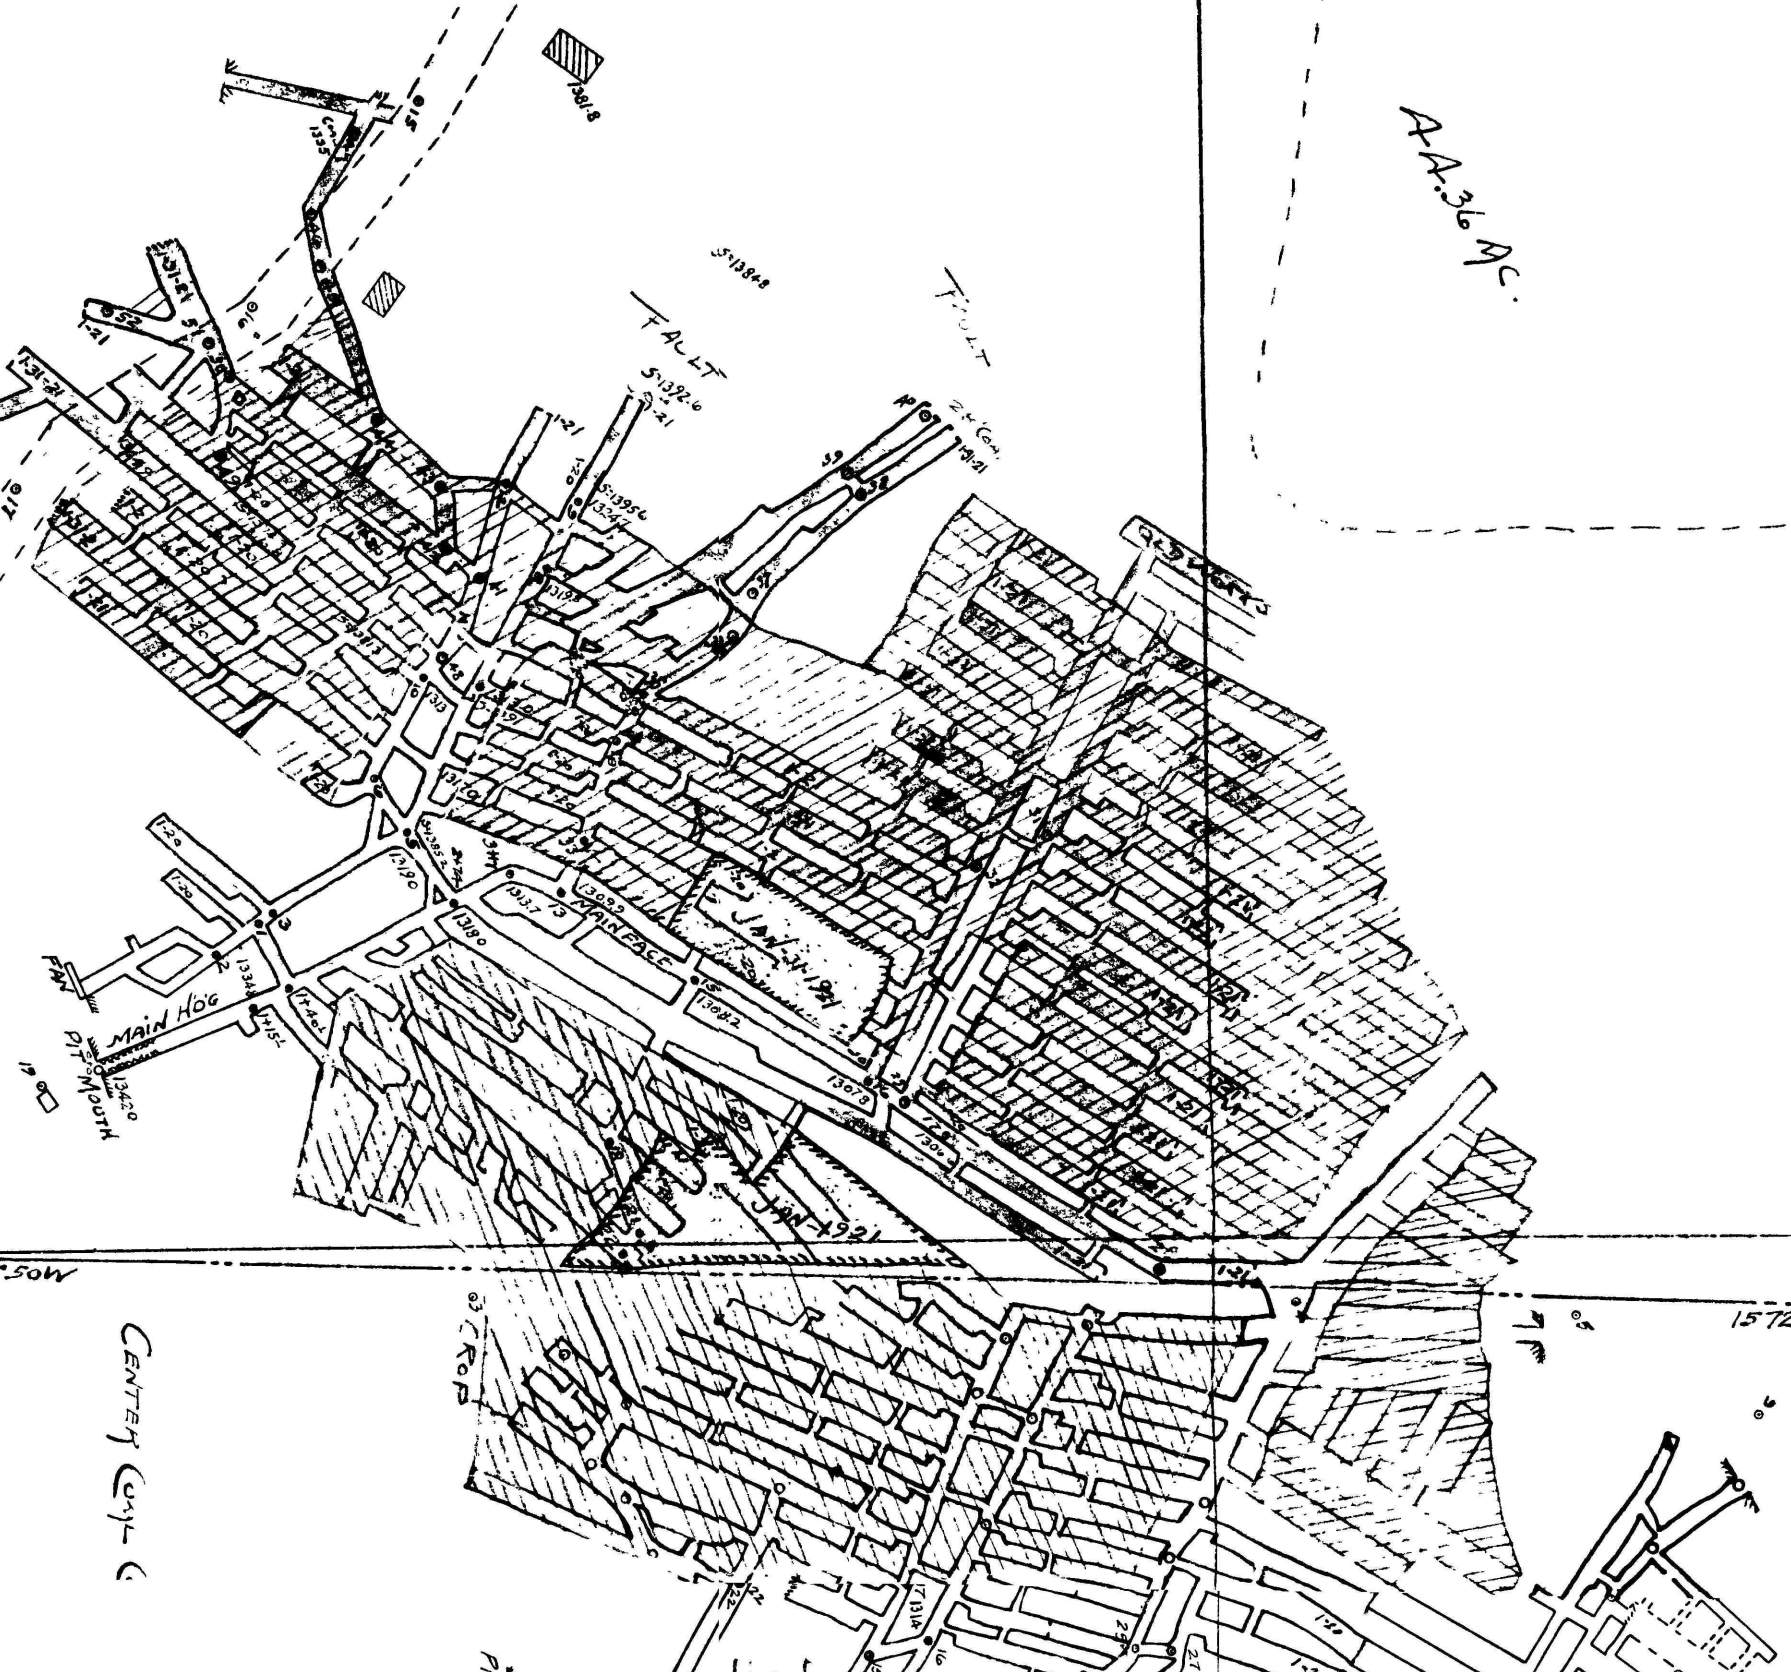

U. C. Co.
Miller

H. J. Brown

J. H. Brown
28 1/2 ac.

MATCH LINE

MAP

PALMER COAL CO.

CLAY TOWNSHIP
SUTHER COUNTY DA.
WESTERN ALLEGHENY RAILROAD
Scale 1"=600'
JAN 1912
DOTTEN PA.

