


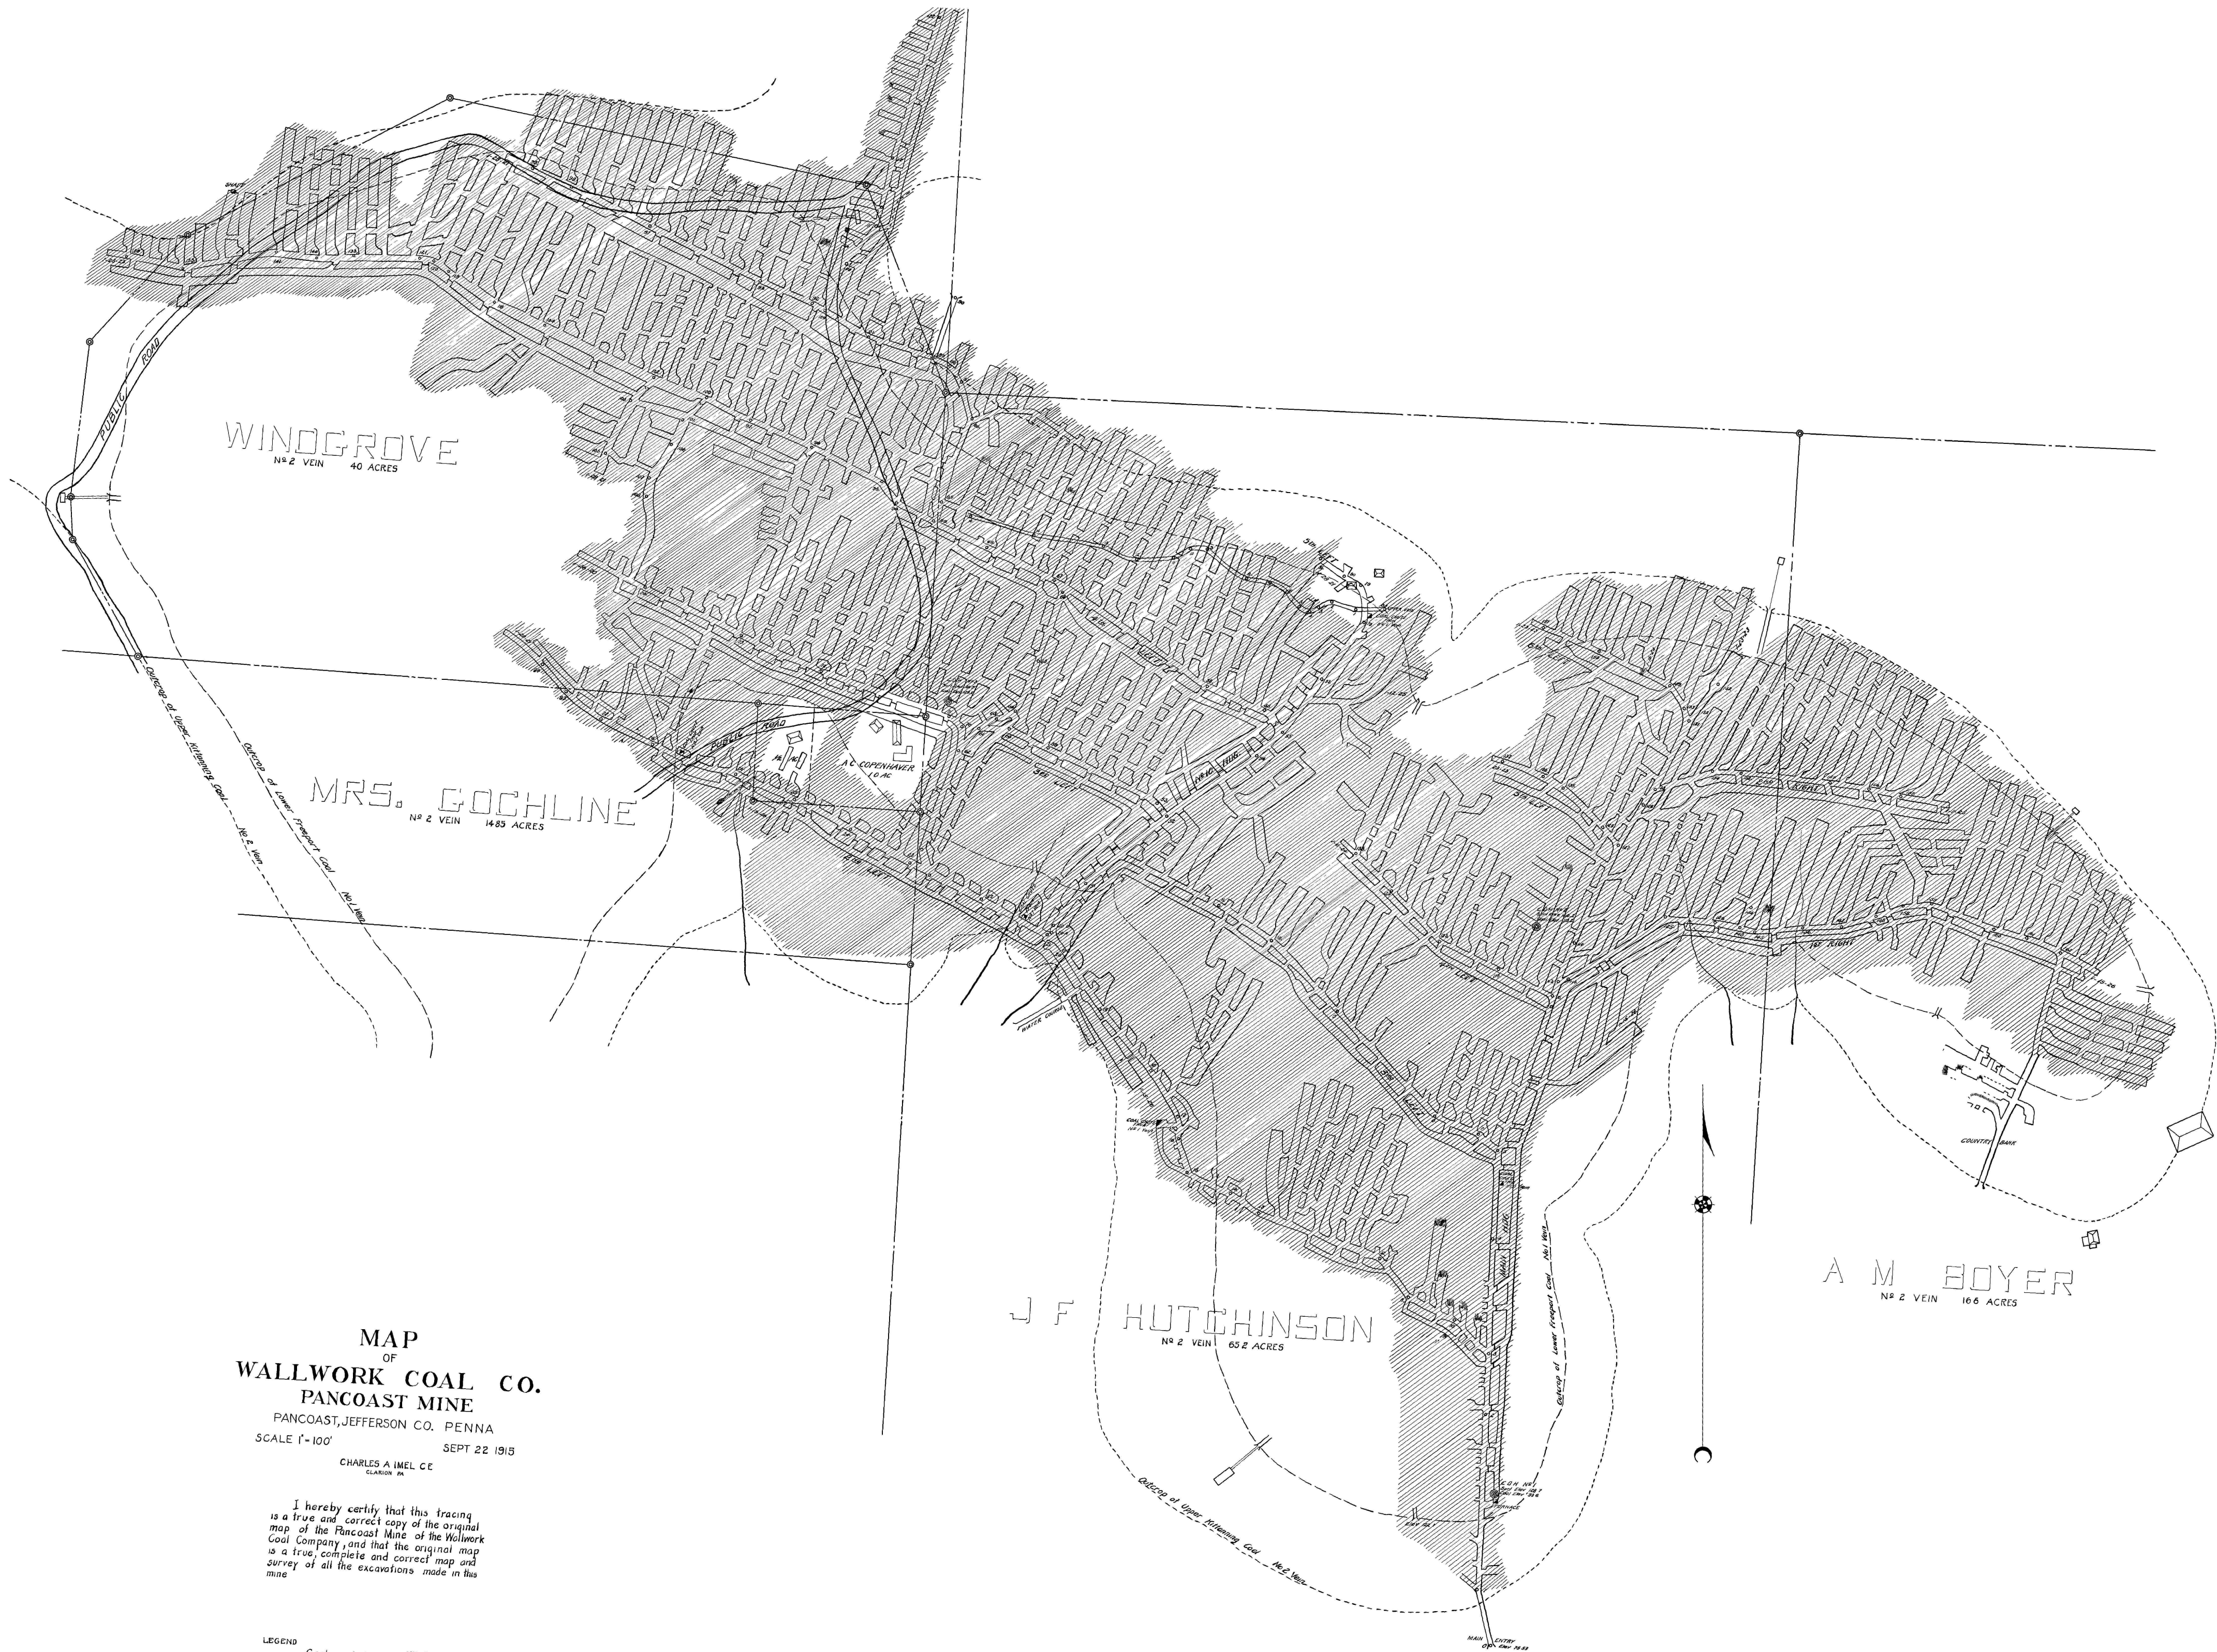

MAP
OF
WALLWORK COAL CO.
PANCOAST MINE
PANCOAST, JEFFERSON CO. PENNA
SCALE 1"=100' SEPT 22 1915
CHARLES A IMEL CE
CLARKSON PA

I hereby certify that this tracing
is a true and correct copy of the original
map of the Pancoast Mine of the Wallwork
Coal Company, and that the original map
is a true, complete and correct map and
survey of all the excavations made in this
mine

LEGEND
Coal worked out, [hatched pattern]