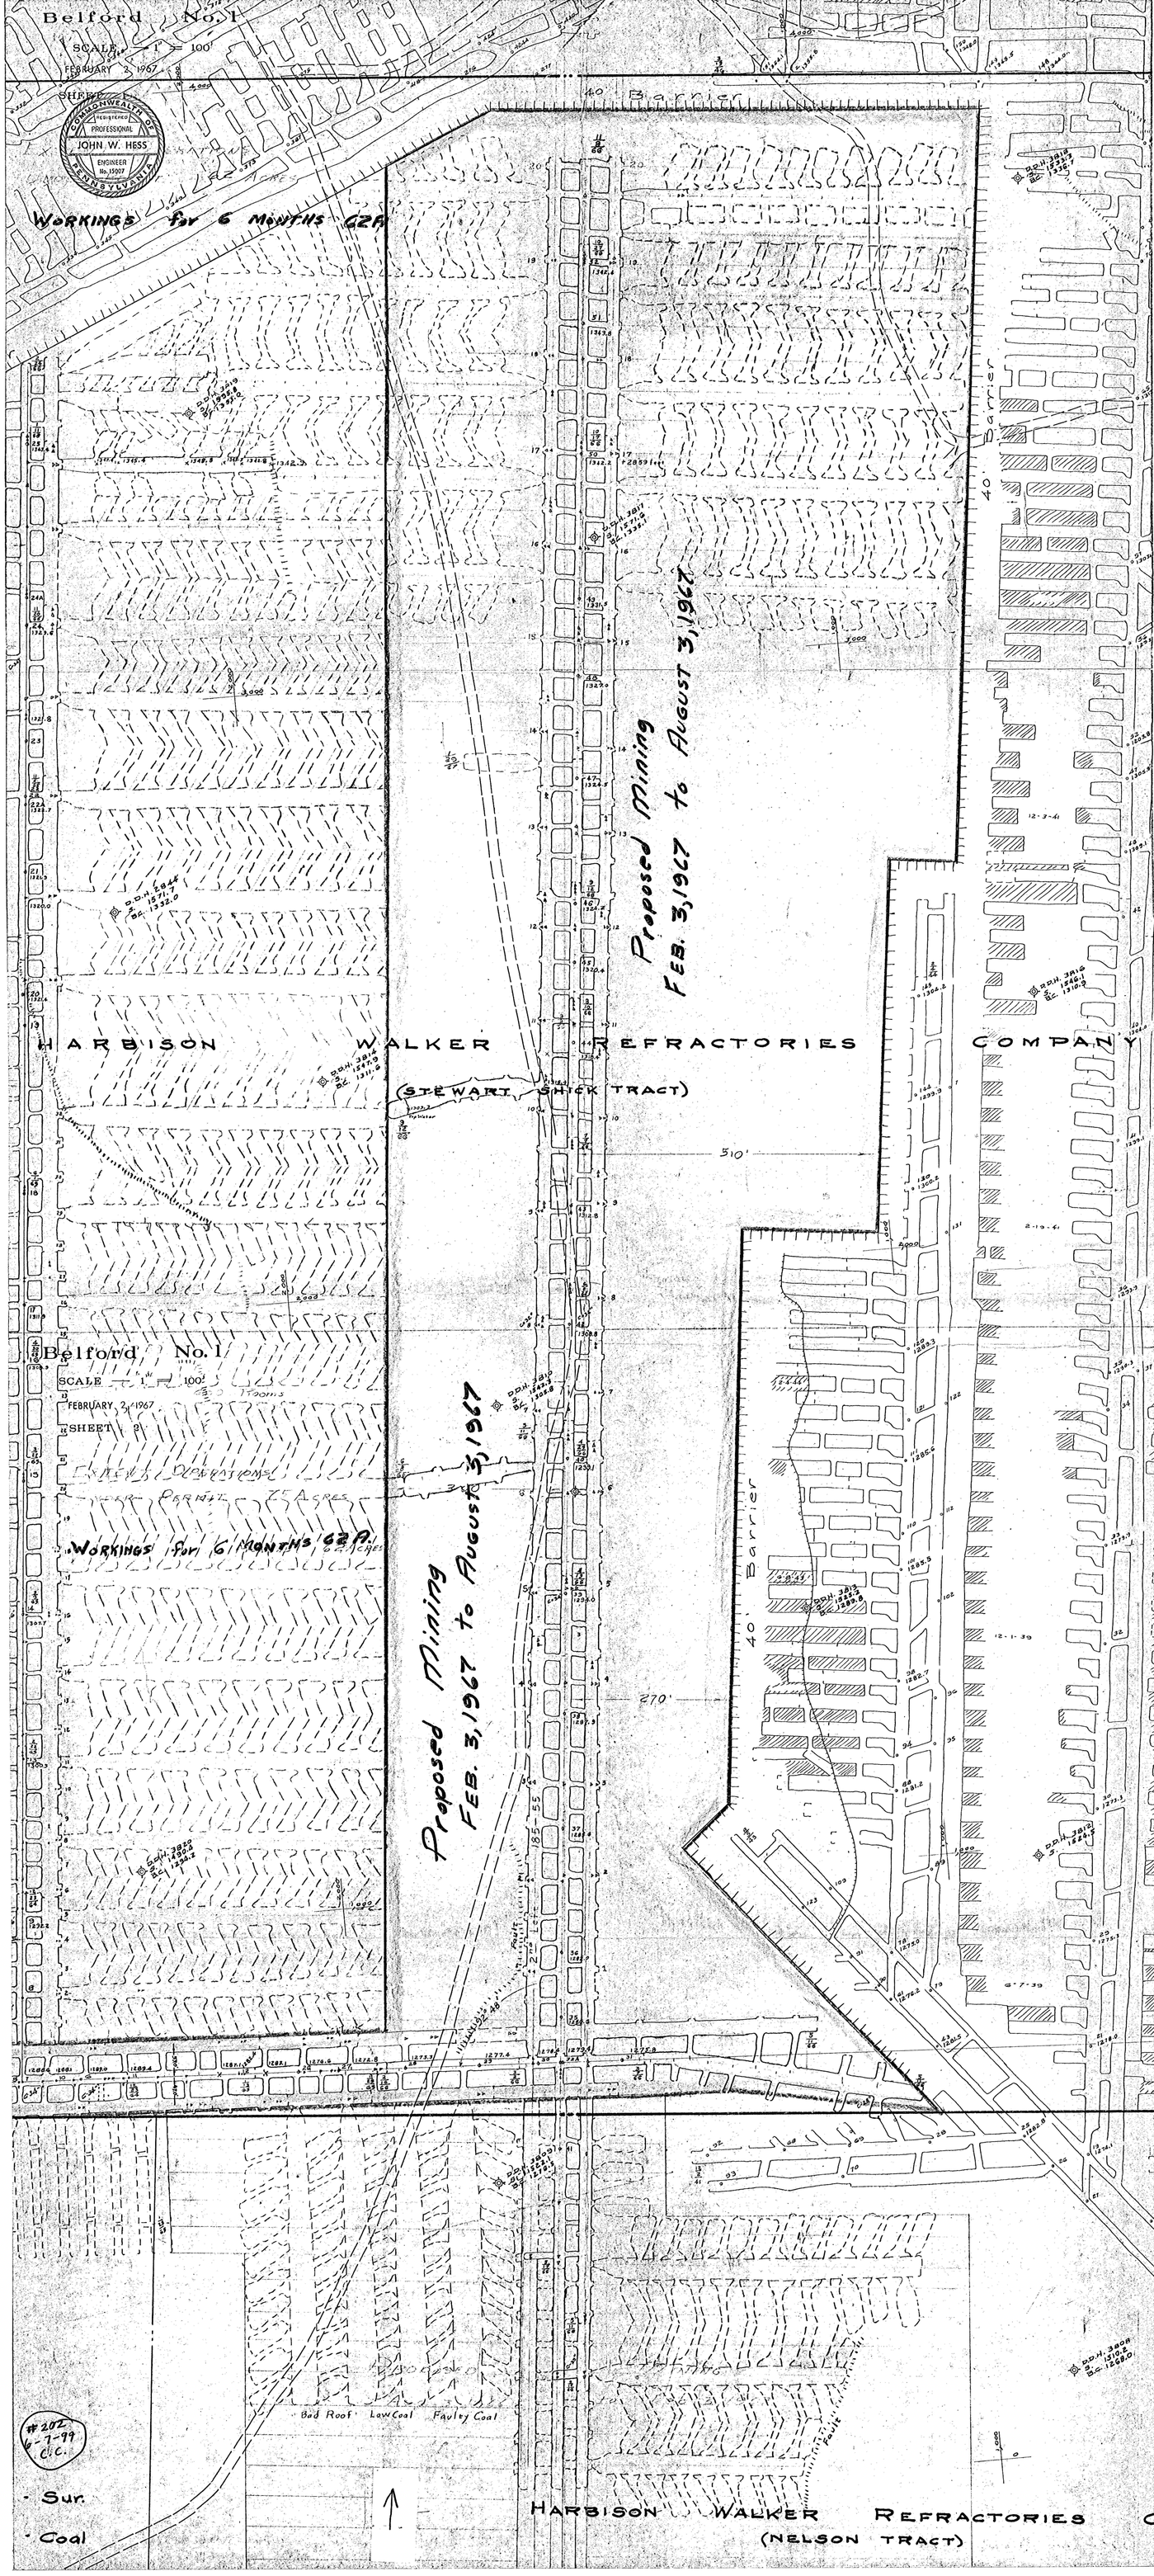

Belford No. 1
SCALE 1" = 100'
FEBRUARY 2, 1967
SHEET 2
COMMONWEALTH OF PENNSYLVANIA
REGISTERED PROFESSIONAL
JOHN W. HESS
ENGINEER
No. 15007
WORKINGS for 6 MONTHS 62A
40' Barrier
Proposed Mining
FEB. 3, 1967 to AUGUST 3, 1967
HARBISON WALKER REFRACTORIES COMPANY
(STEWART SHICK TRACT)
510'
Belford No. 1
SCALE 1" = 100'
FEBRUARY 2, 1967
SHEET 2
WORKINGS for 6 MONTHS 62A
Proposed Mining
FEB. 3, 1967 to AUGUST 3, 1967
40' Barrier
270'
Bad Roof
Low Coal
Faulty Coal
Fault
#202
6-7-99
C.C.
Sur.
Coal
HARBISON WALKER REFRACTORIES
(NELSON TRACT)