


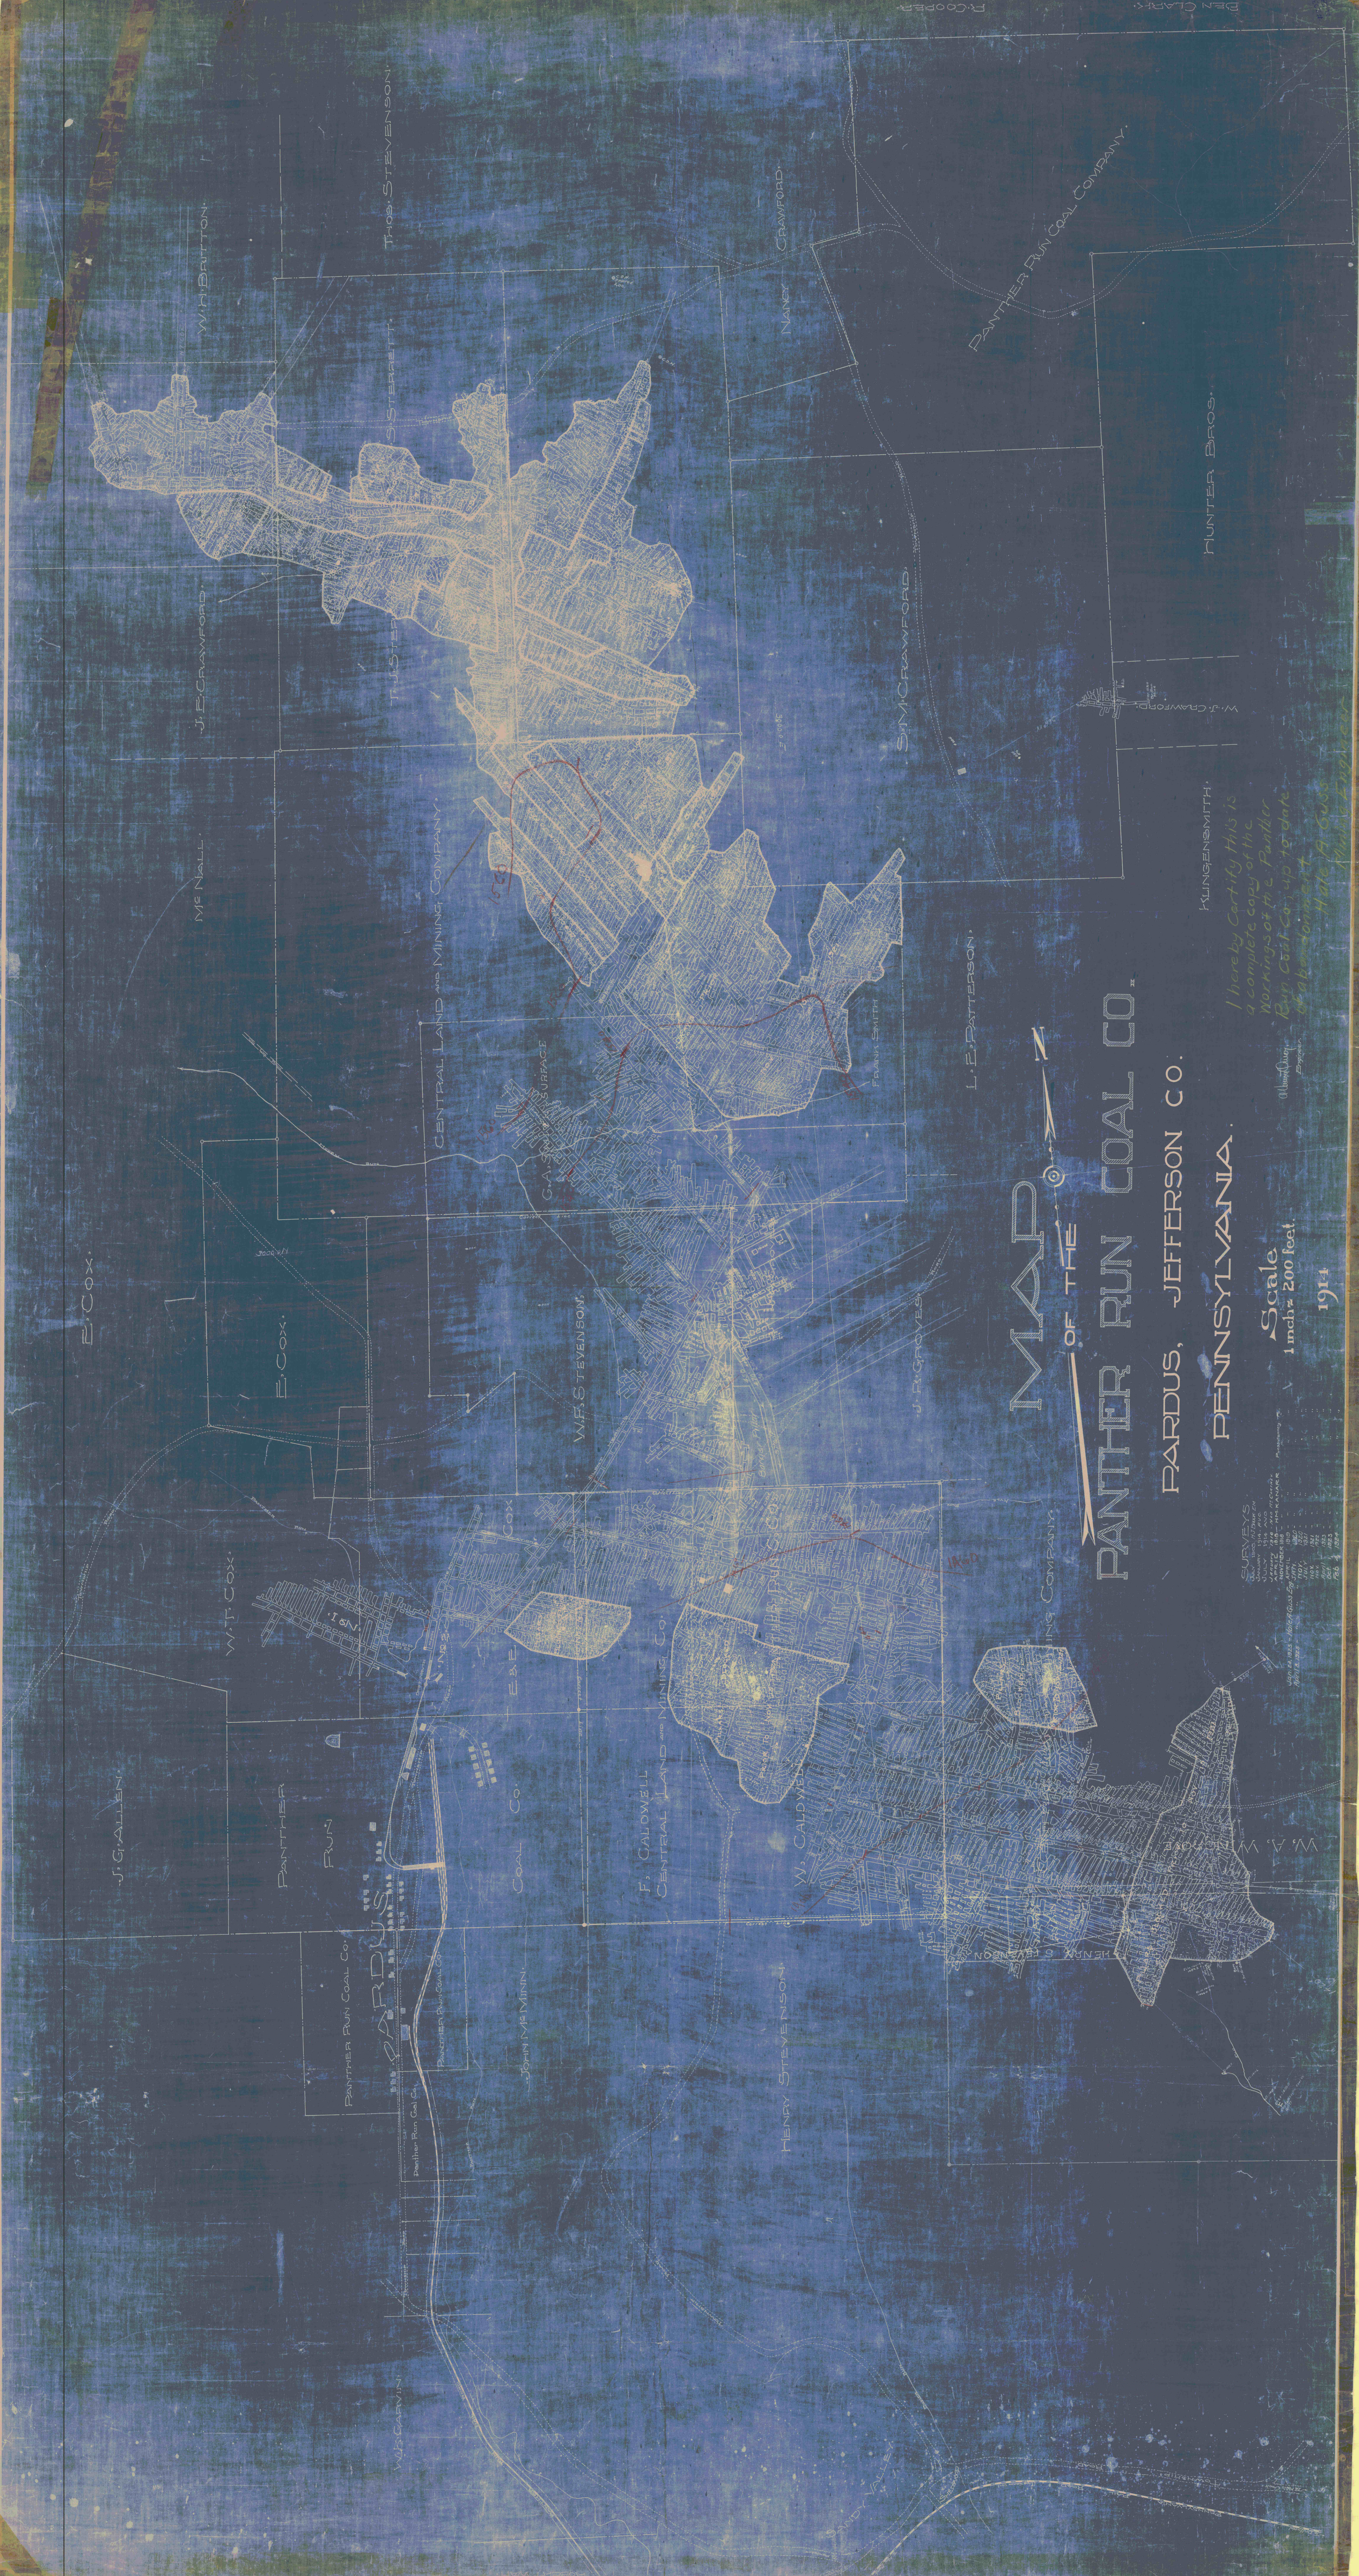

MAP
OF THE
PANTHER RUN COAL CO.

PARDUS, JEFFERSON CO.
PENNSYLVANIA.

Scale
1 inch = 200 feet
1914

SURVEYS


HUNTER BROS.

I hereby certify this is
a complete copy of the
workings of the Panther
Run Coal Co. up to date
of abandonment
Hale M. Guss
Miner & Engineer

KLINGENSMITH

L. E. PATTERSON.

SIM CRAWFORD.

NANCY CRAWFORD.

THOS. STEVENSON.

W. H. BRITTON.

J. E. CRAWFORD.

Mrs. NALL.

E. COX.

E. COX.

W. T. COX.

J. G. ALLEN.

PANTHER

RUN

PANTHER RUN COAL CO.

PANTHER RUN COAL CO.

JOHN M. MINN.

COAL CO.

E. E. COX.

COX

W. F. STEVENSON.

F. CALDWELL

CENTRAL LAND MINING CO.

HENRY STEVENSON.

W. CALDWELL

J. R. GROVES

FRANK SMITH

G. A. SURFACE

CENTRAL LAND MINING COMPANY.

TRUSTEES

PANTHER RUN COAL COMPANY.

P. COOPER

BEN CLARK