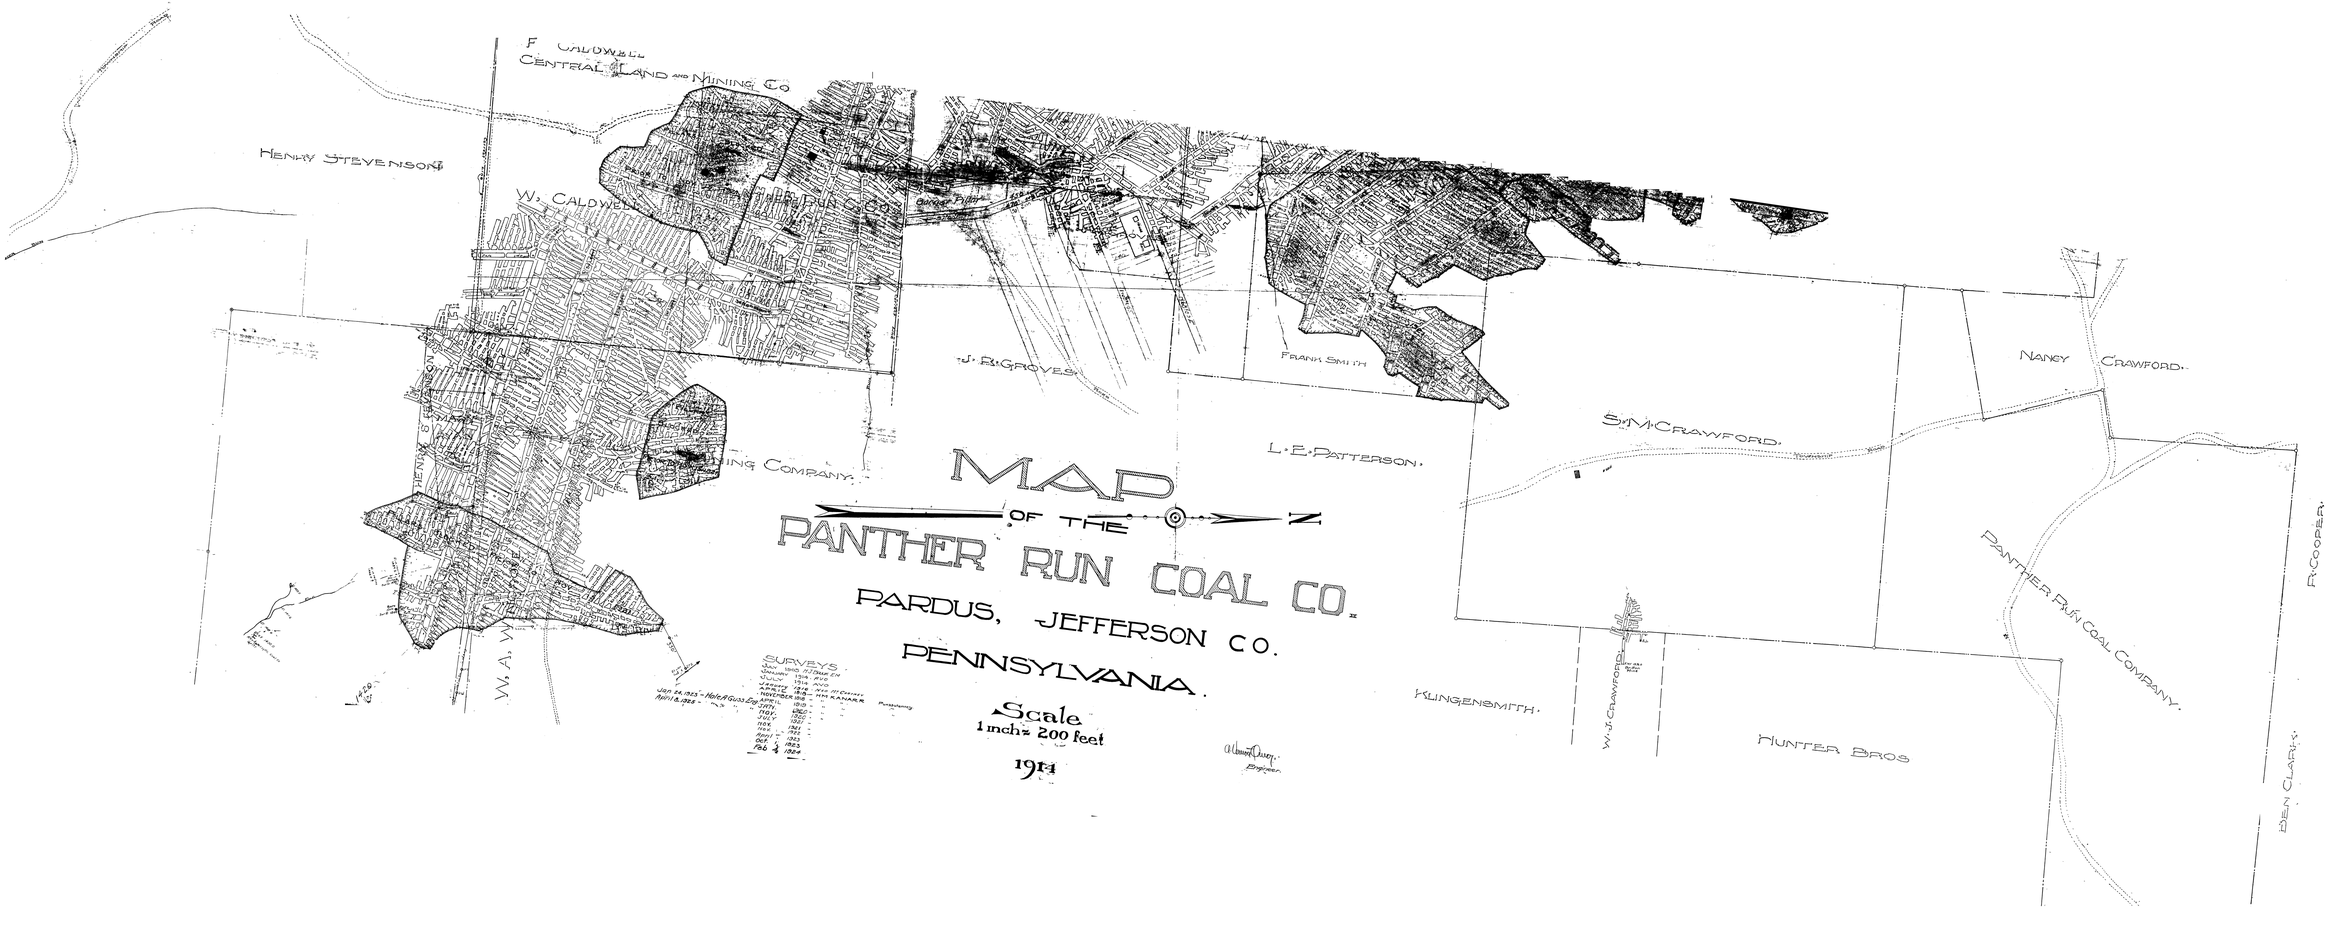

F CALDWELL
CENTERAL LAND AND MINING CO
HENRY STEVENSON
W. CALDWELL
PANTHER RUN CO. CO.
J. R. GROVES
FRANK SMITH
NANCY CRAWFORD.
S. M. CRAWFORD.
L. E. PATTERSON.
ING COMPANY.
MAP
OF THE
PANTHER RUN COAL CO.
PARDUS, JEFFERSON CO.
PENNSYLVANIA.
Scale
1 inch = 200 feet
1914
SURVEYS
KLINGENSMITH.
W. J. CRAWFORD.
HUNTER BROS
PANTHER RUN COAL COMPANY.
R. COOPER.
BEN CLARK.