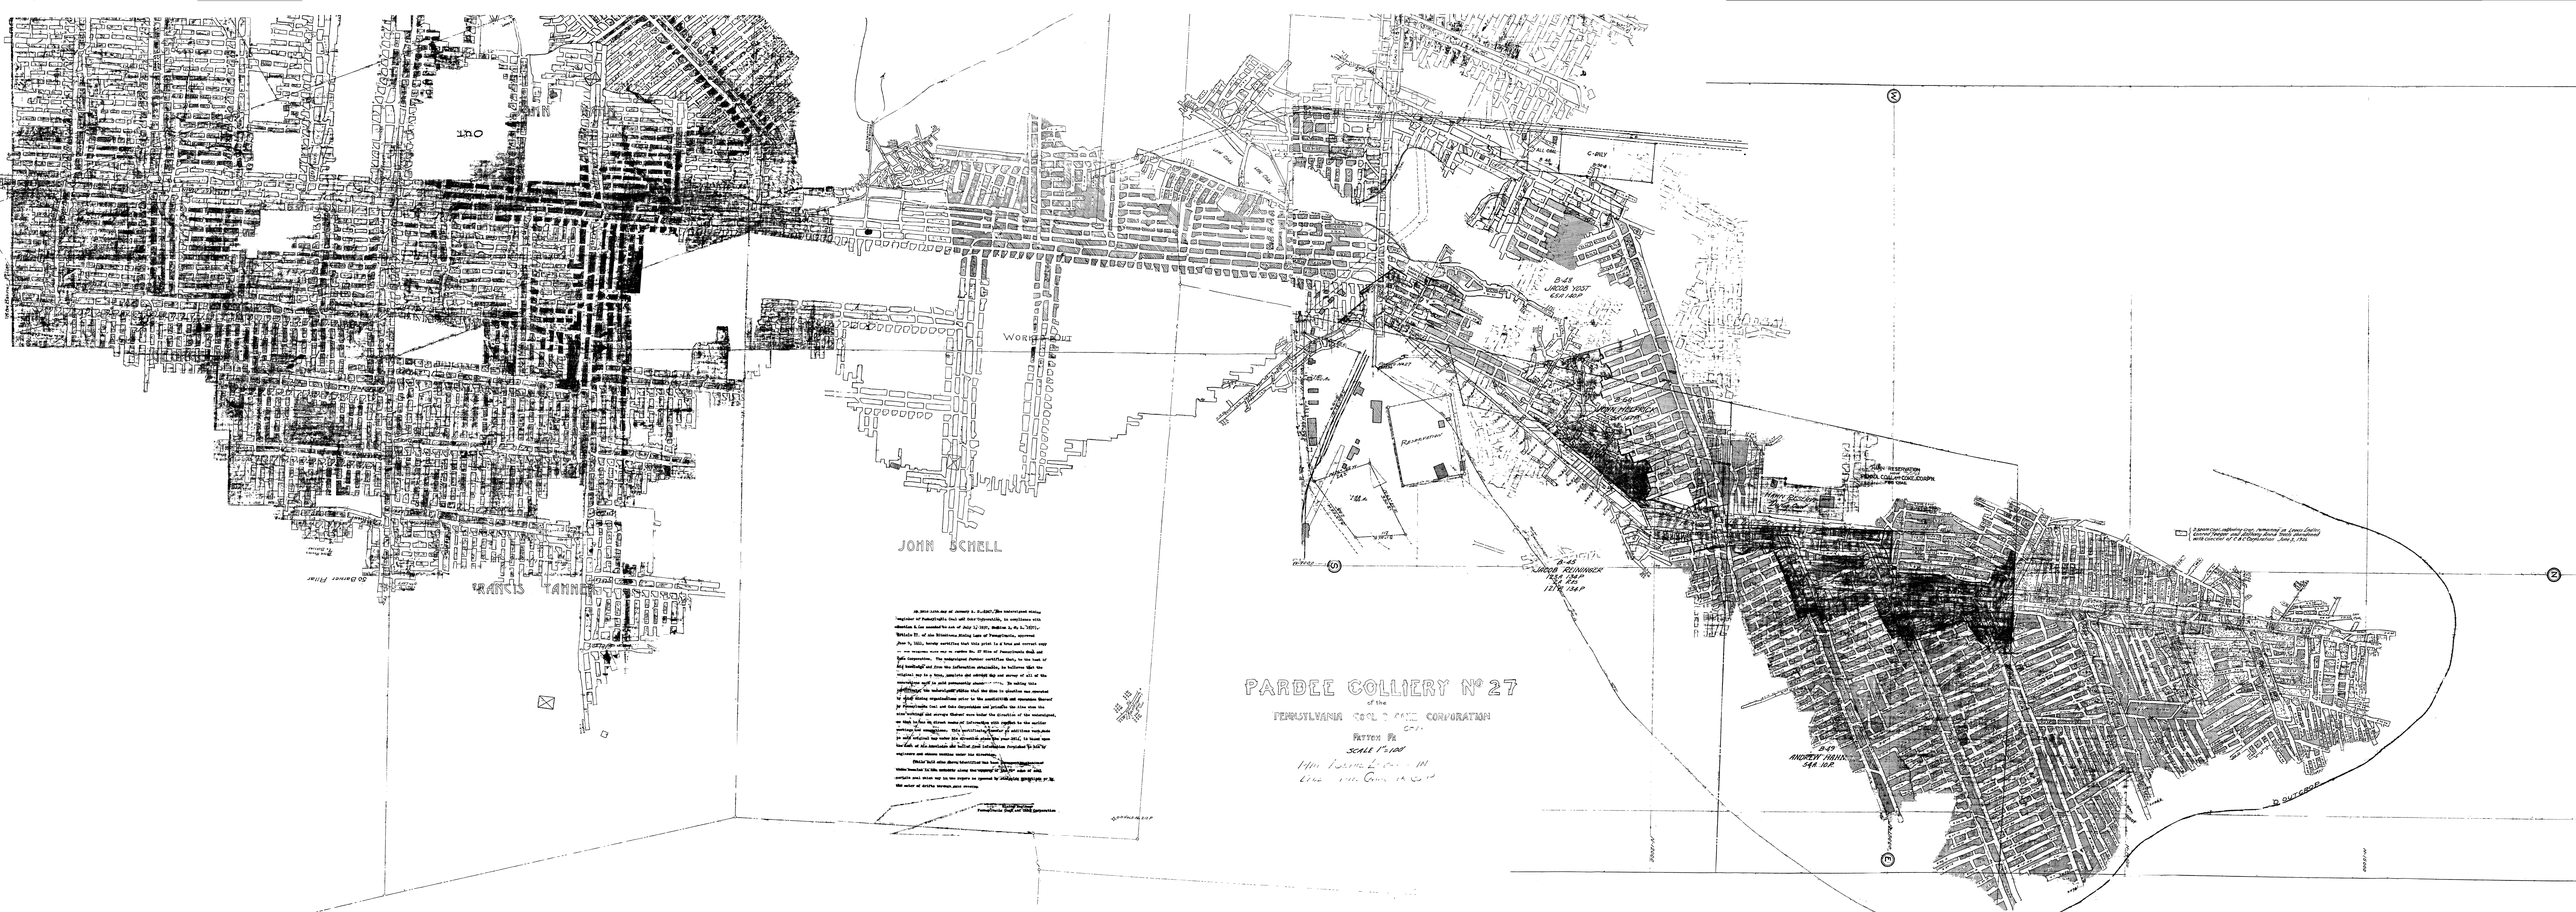

150 Barrier Pillar
50 Barrier Pillar
FRANCIS TANNER
JOHN SCHELL
OUT
WORKED OUT
FRANK SCHWAB COUNTRY MINE
LOW COAL
MAIN HEADING
ALL COAL
C-ONLY
B-50-B
B-48
JACOB YOST
65A 140P
B-45
JACOB REININGER
123A 134P
RESERVATION
HAHN RESERVE
Do Not Own
HAHN RESERVATION
NOW
PENN'A. COAL AND COKE CORP'N.
FEE COAL
B-49
ANDREW HAHN
54A. 10P.
D OUTCROP
ALVIN THOMAS MINE D SEAM
DD HOLE No 212 P
W-7000
N-12000
N-13000
N-14000
N-15000
S
E
W
N

PARDEE COLLIERY No 27

of the

PENNSYLVANIA COAL & COKE CORPORATION

PATTON PA

SCALE 1"=100'

[illegible] IN

[illegible]

On this 11th day of January A. D. 1947, the undersigned mining engineer of Pennsylvania Coal and Coke Corporation, in compliance with Section 4 (as amended by Act of July 1, 1937, Section 2, P. L. 1937), Article II. of the Bituminous Mining Laws of Pennsylvania, approved June 9, 1911, hereby certifies that this print is a true and correct copy of the original mine map of Pardee No. 27 Mine of Pennsylvania Coal and Coke Corporation. The undersigned further certifies that, to the best of his knowledge and from the information obtainable, he believes that the original map is a true, complete and correct map and survey of all of the excavations made in said permanently abandoned mine. In making this certificate, the undersigned states that the mine in question was operated by other mining organizations prior to the acquisition and operation thereof by Pennsylvania Coal and Coke Corporation and prior to the time when the mine workings and surveys thereof were under the direction of the undersigned, so that he has no direct means of information with respect to the earlier workings and excavations. This certificate, insofar as additions were made to said original map under his direction since the year 1914, is based upon the best of his knowledge and belief from information furnished to him by engineers and others working under his direction.

(While said mine above identified has been permanently abandoned there remains in the property along the outcrop of the "D" seam of coal certain coal which may in the future be removed by stripping operations or by the entry of drifts through said outcrop.

Mining Engineer
Pennsylvania Coal and Coke Corporation

▭ D Seam Coal, including Crop, remaining in Lewis Endler, Conrad Yeager and Anthony Anna Tracts abandoned with concent of C B C Corporation June 3, 1926