


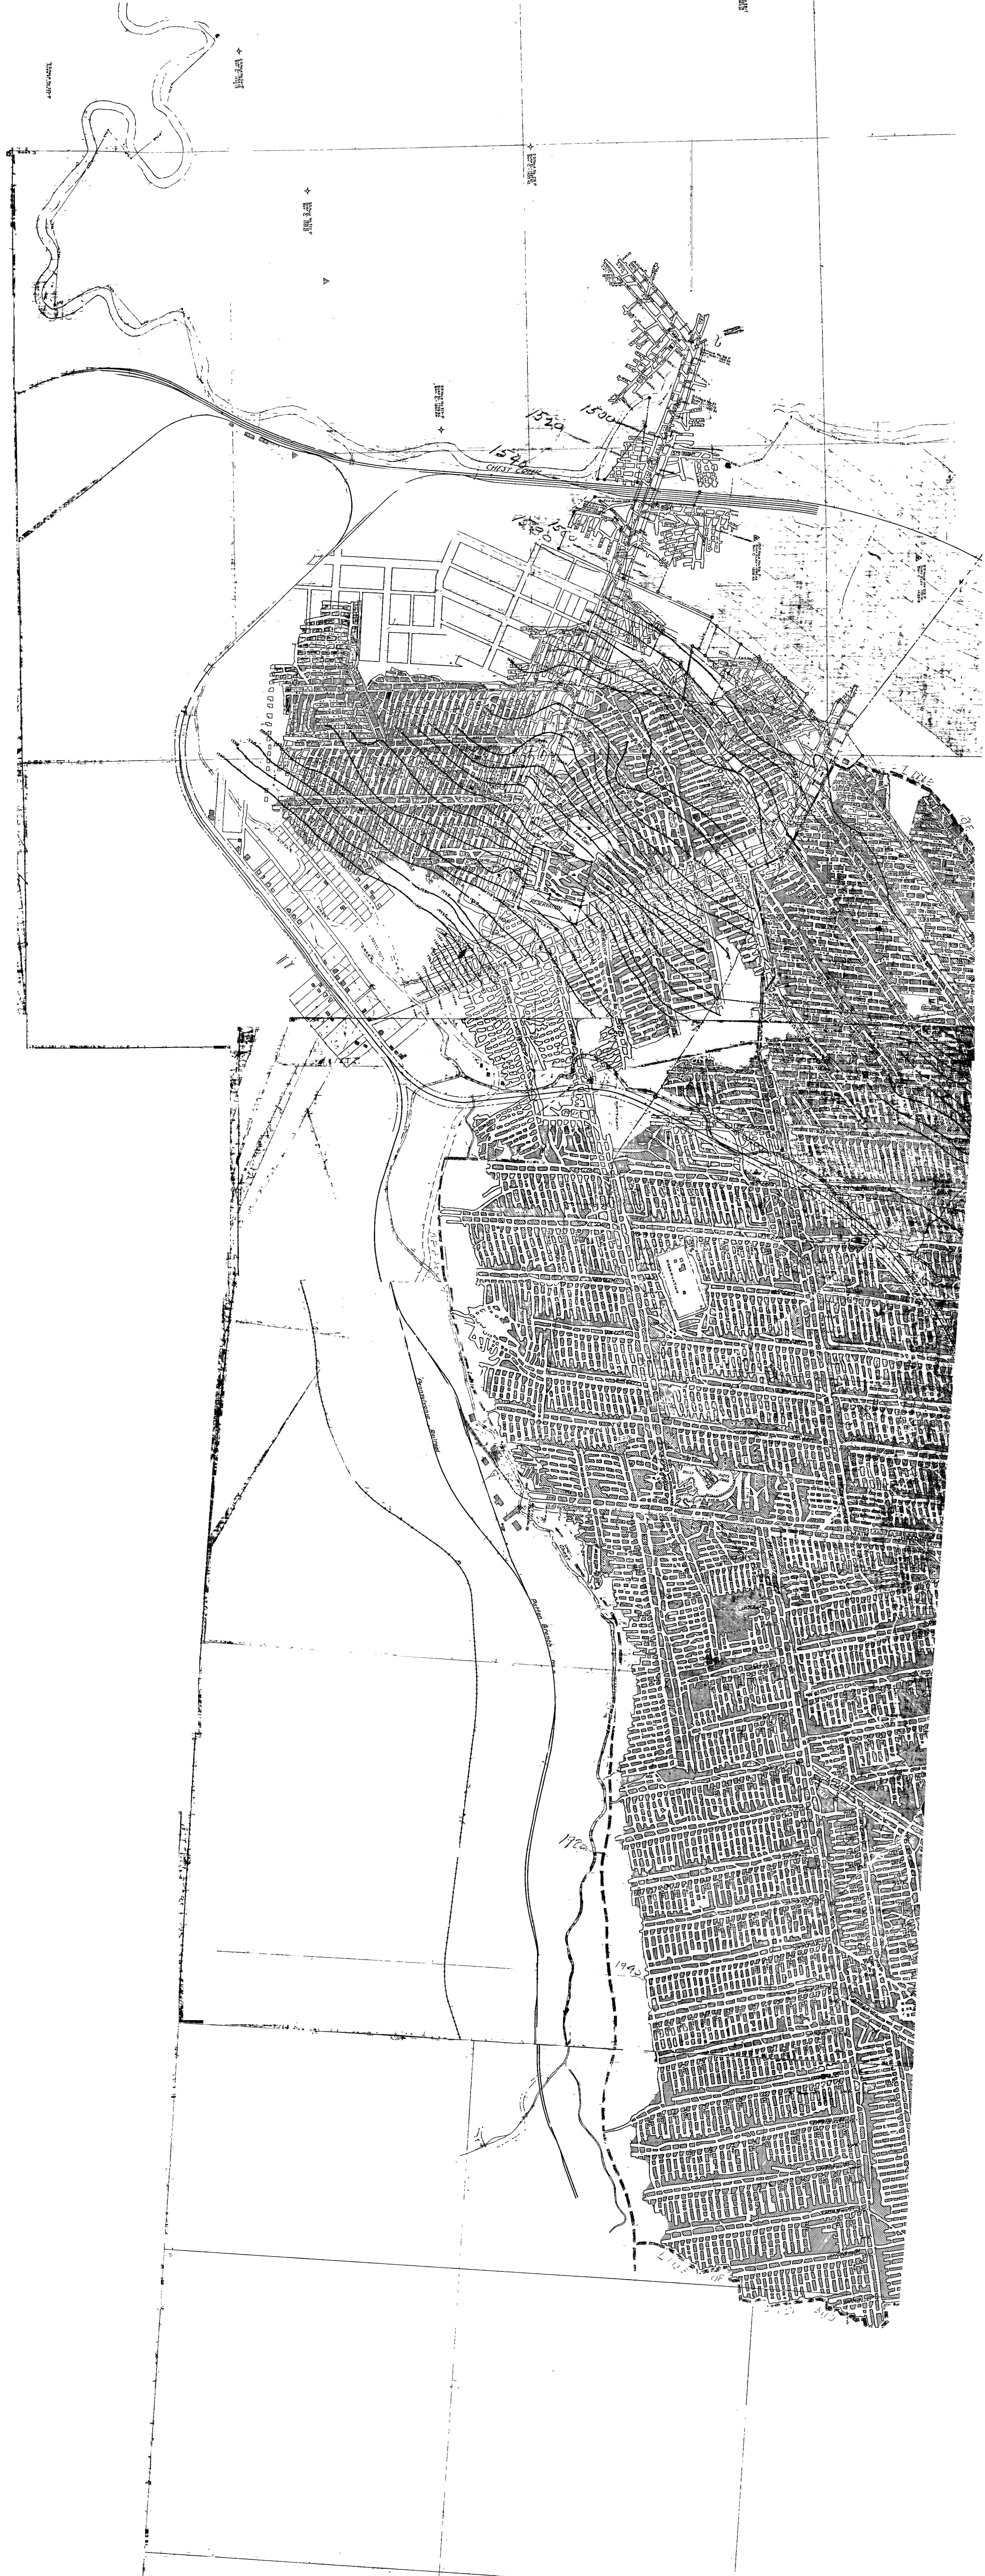

PENNA. COAL & COKE
MAP OF
PARDEE COLLIERY NO.
6 SEAM
NEAR PATTON, PA. EAST CARROLL TOWNSHIP
PAID DEPT. P. C. & C. CO. PATTON, PA. 1920
CAMERON CO.

