


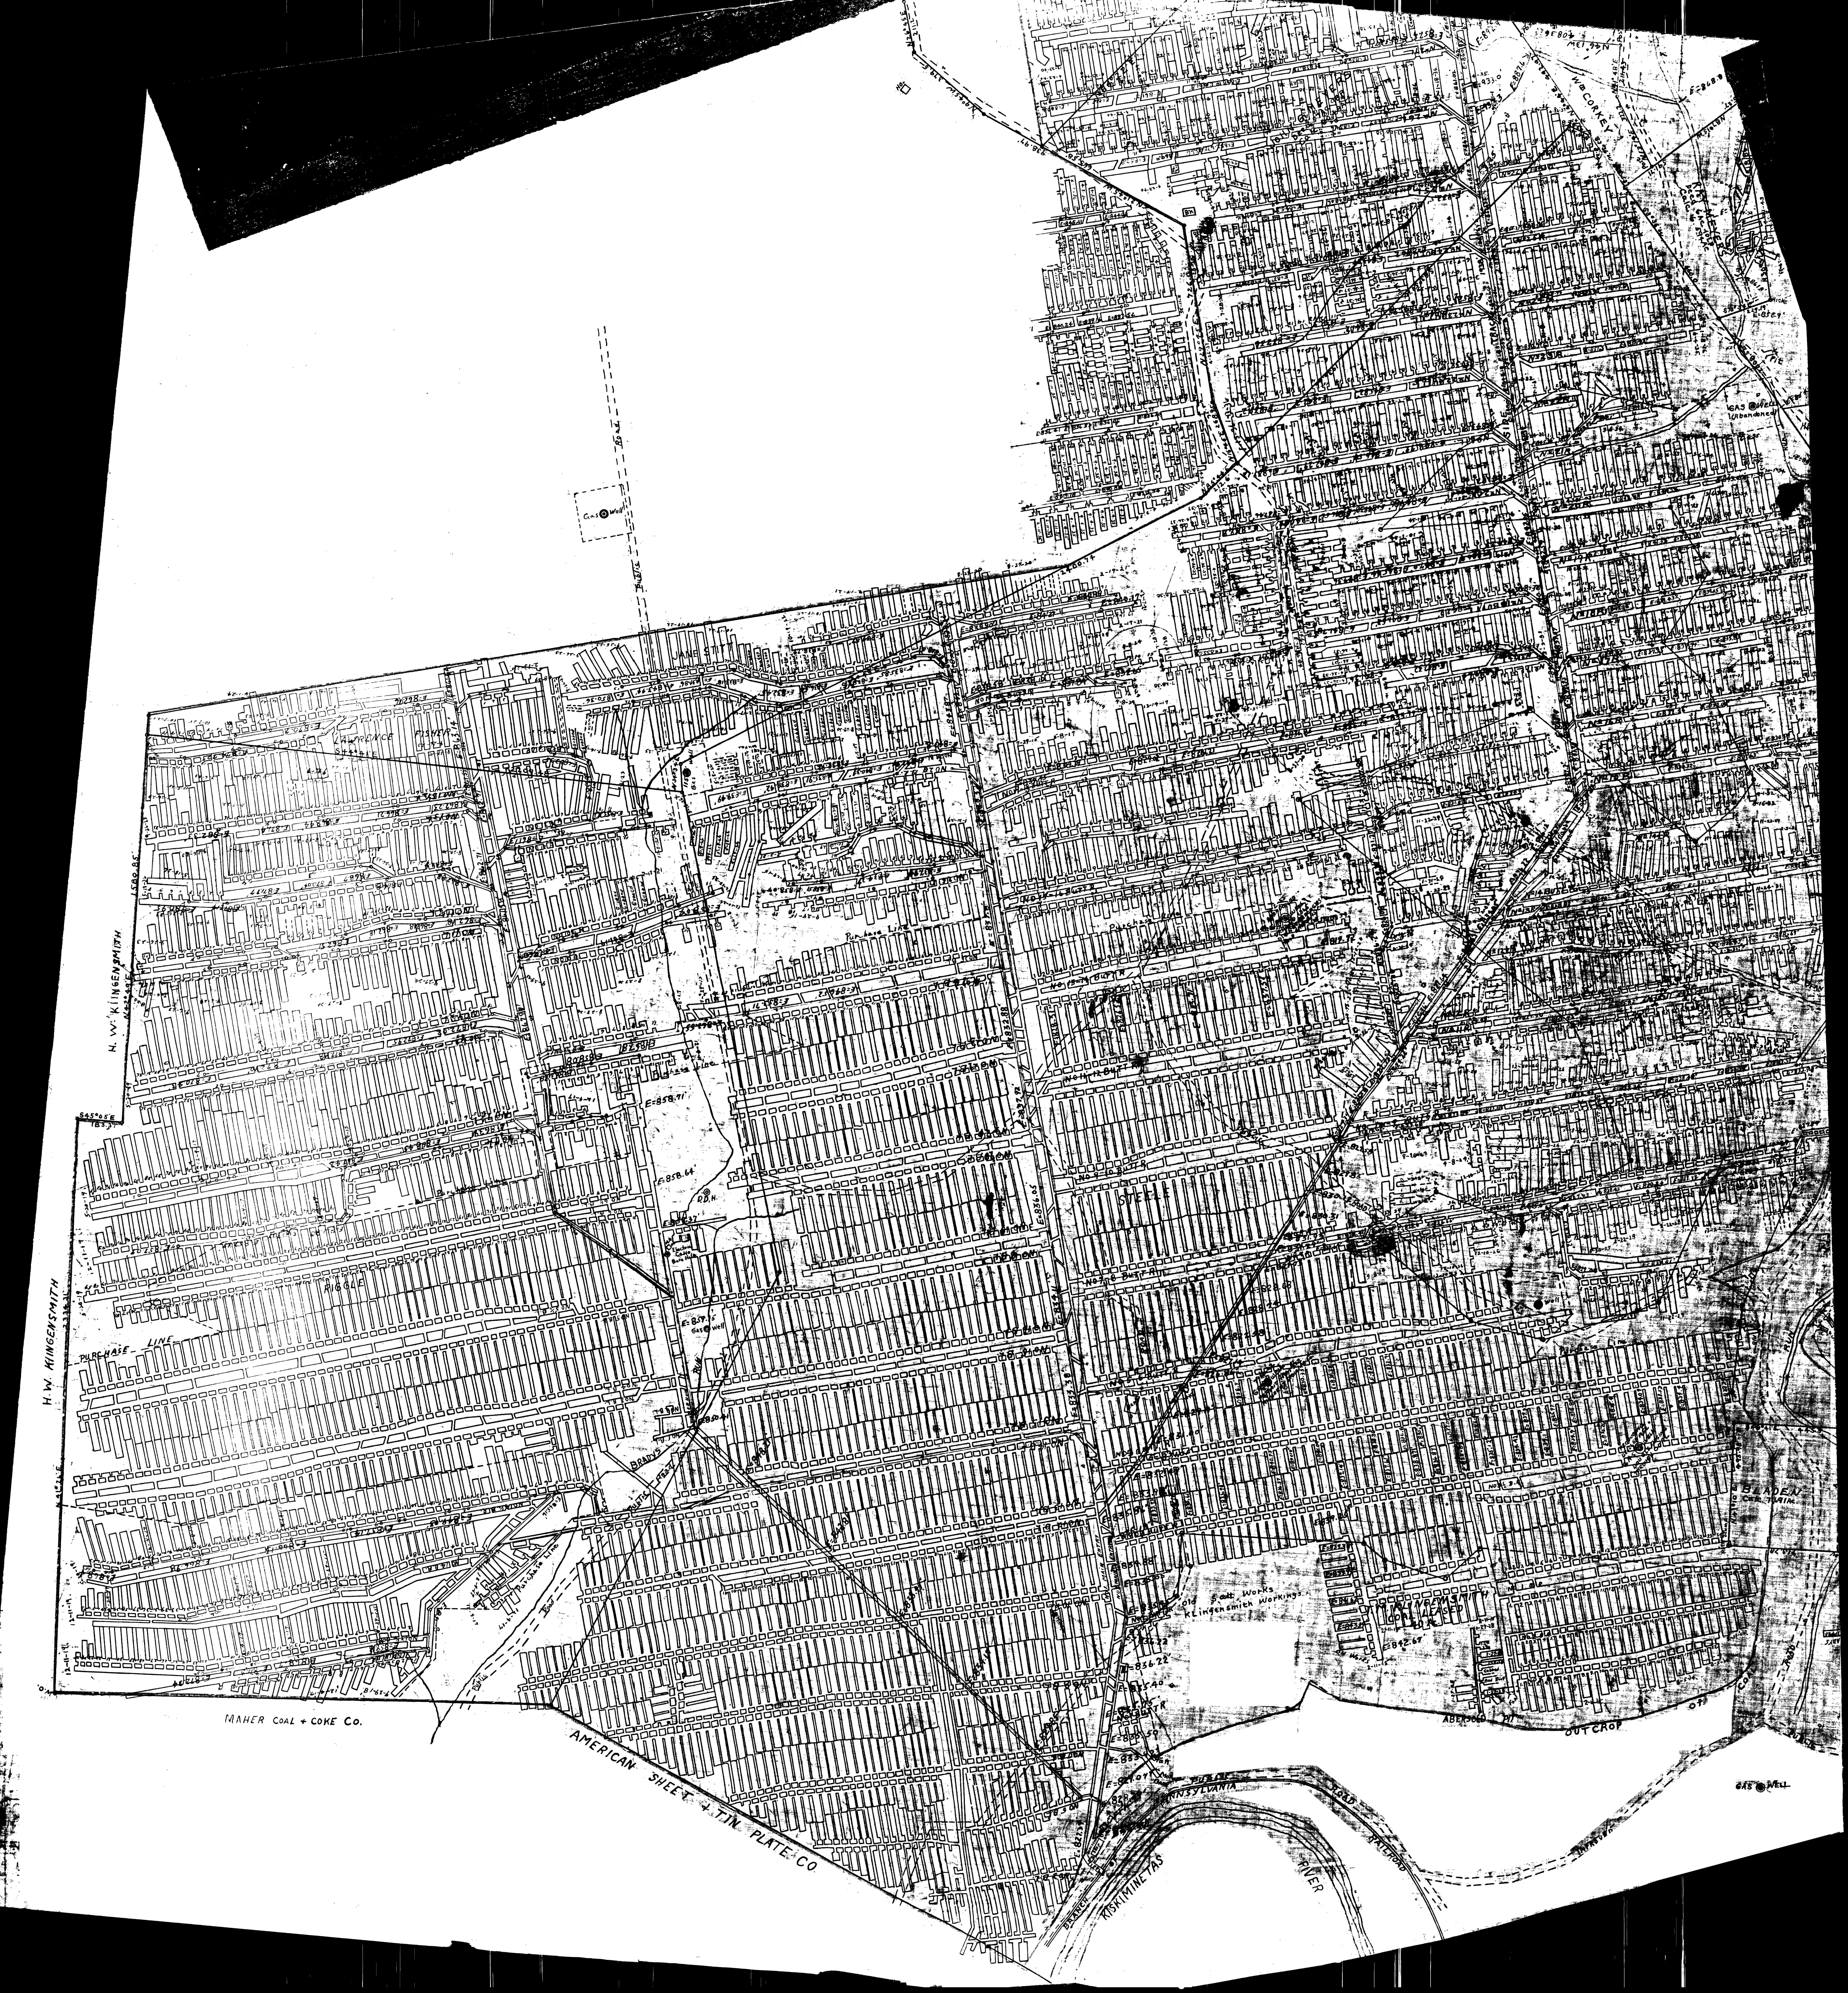

MAHER COAL + COKE CO.

AMERICAN SHEET & TIN PLATE CO.

Old Post Works
Kingsmith Works

OUT CROP

615 MELL