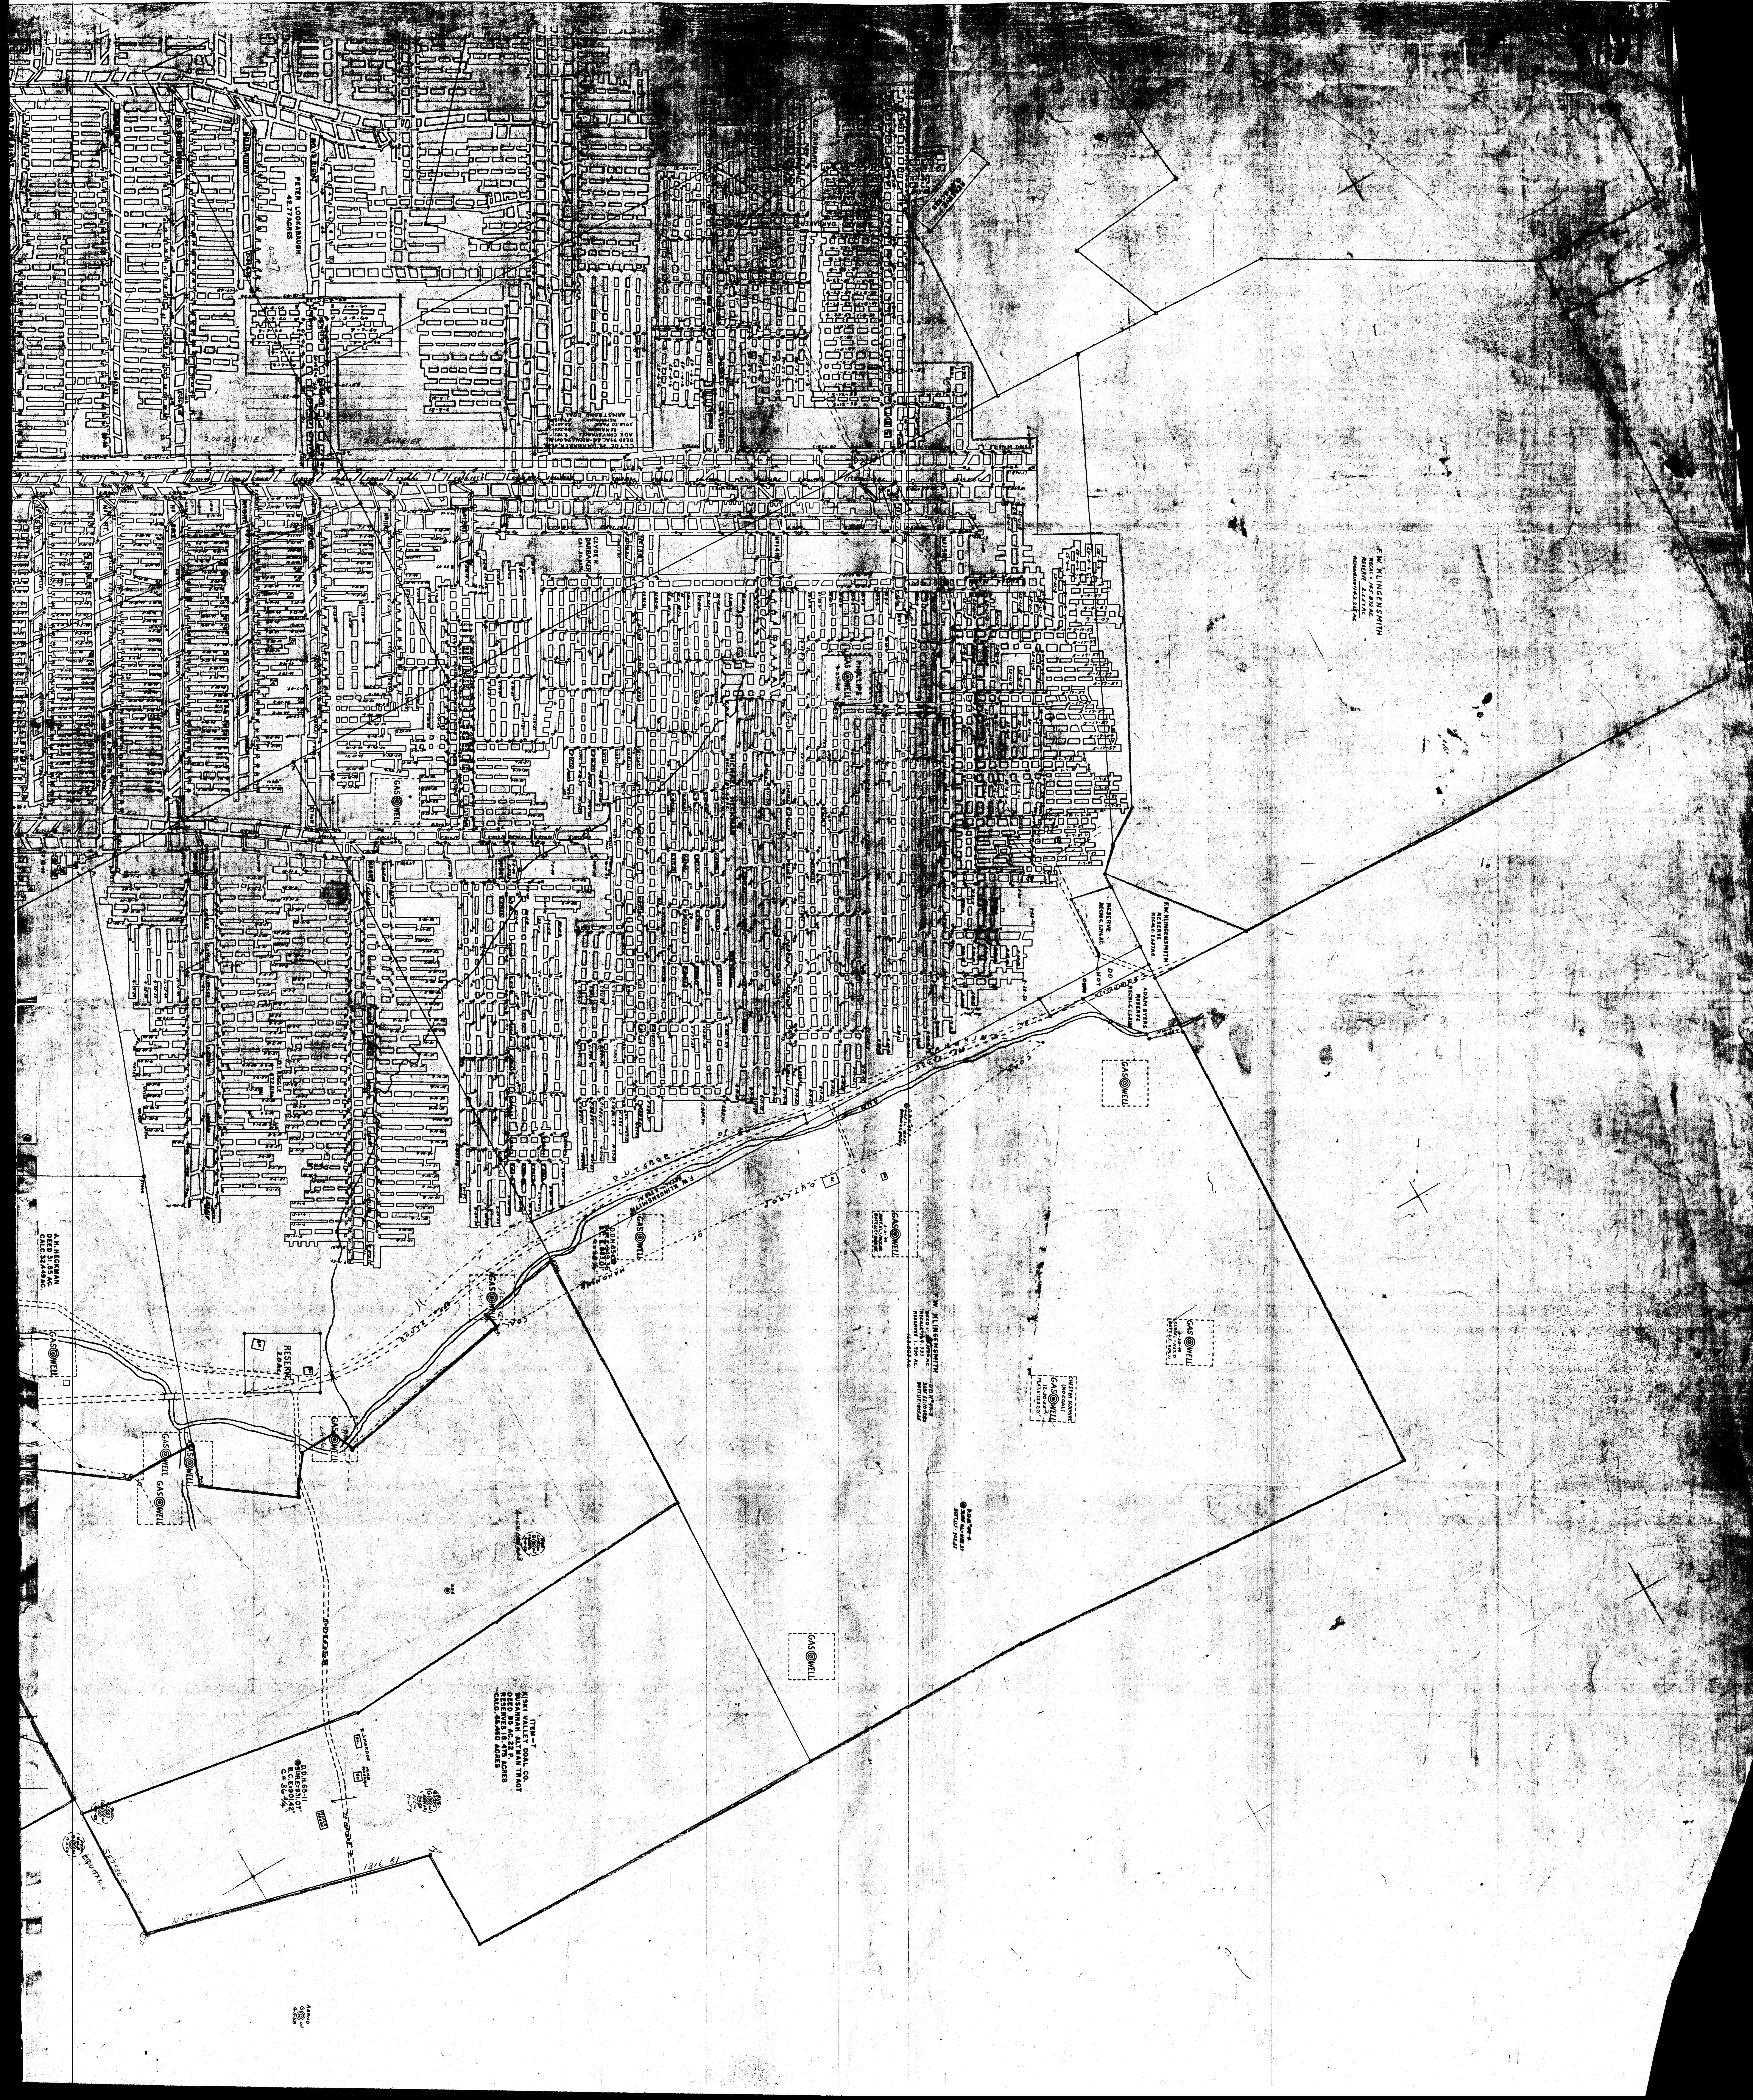
PETER LOOKABAUGH
42.77 ACRES
RIGHT
200 BARRIER
F.W. KLINGENSMITH
RECAL = 145.872 AC.
RESERVE 2.657 AC.
REMAINING 143.215 AC.
RESERVE
RECALC. 1.316 AC.
F.W. KLINGENSMITH
RESERVE
RECALC. 2.657 AC.
DO
NOT
OWN
KITTANNING
ADAM BYERS
RESERVE
RECALC. 1.631 AC.
GAS WELL
F.W. KLINGENSMITH
DEED
1980 AC.
RECALC. 169.733
RESERVES 1.730 AC.
168.003 AC.
D.D.H. 49-3
SURF. EL. 1061.83
BOTT. U.F. 855.85
GAS WELL
3-2-41
CHESTER DUNMIRE
(NO COAL)
GAS WELL
12-30-55
PLAT.E: 1227.71'
J.H. HECKMAN
DEED 31.85 AC.
CALC. 32.449 AC.
RESERVE
2.0 AC.
ITEM - 7
KISKI VALLEY COAL CO.
SUSANNAH ALTMAN TRACT
DEED 85 AC. 22 P.
RESERVES 18.475 ACRES
CALC. 66.450 ACRES
R.J. KARDOS
MIKE KASKAN
No.
NO
FNG
#2405
(G W)
ACTIVE
4-58
N CW
HILTY
1316.81
IP