


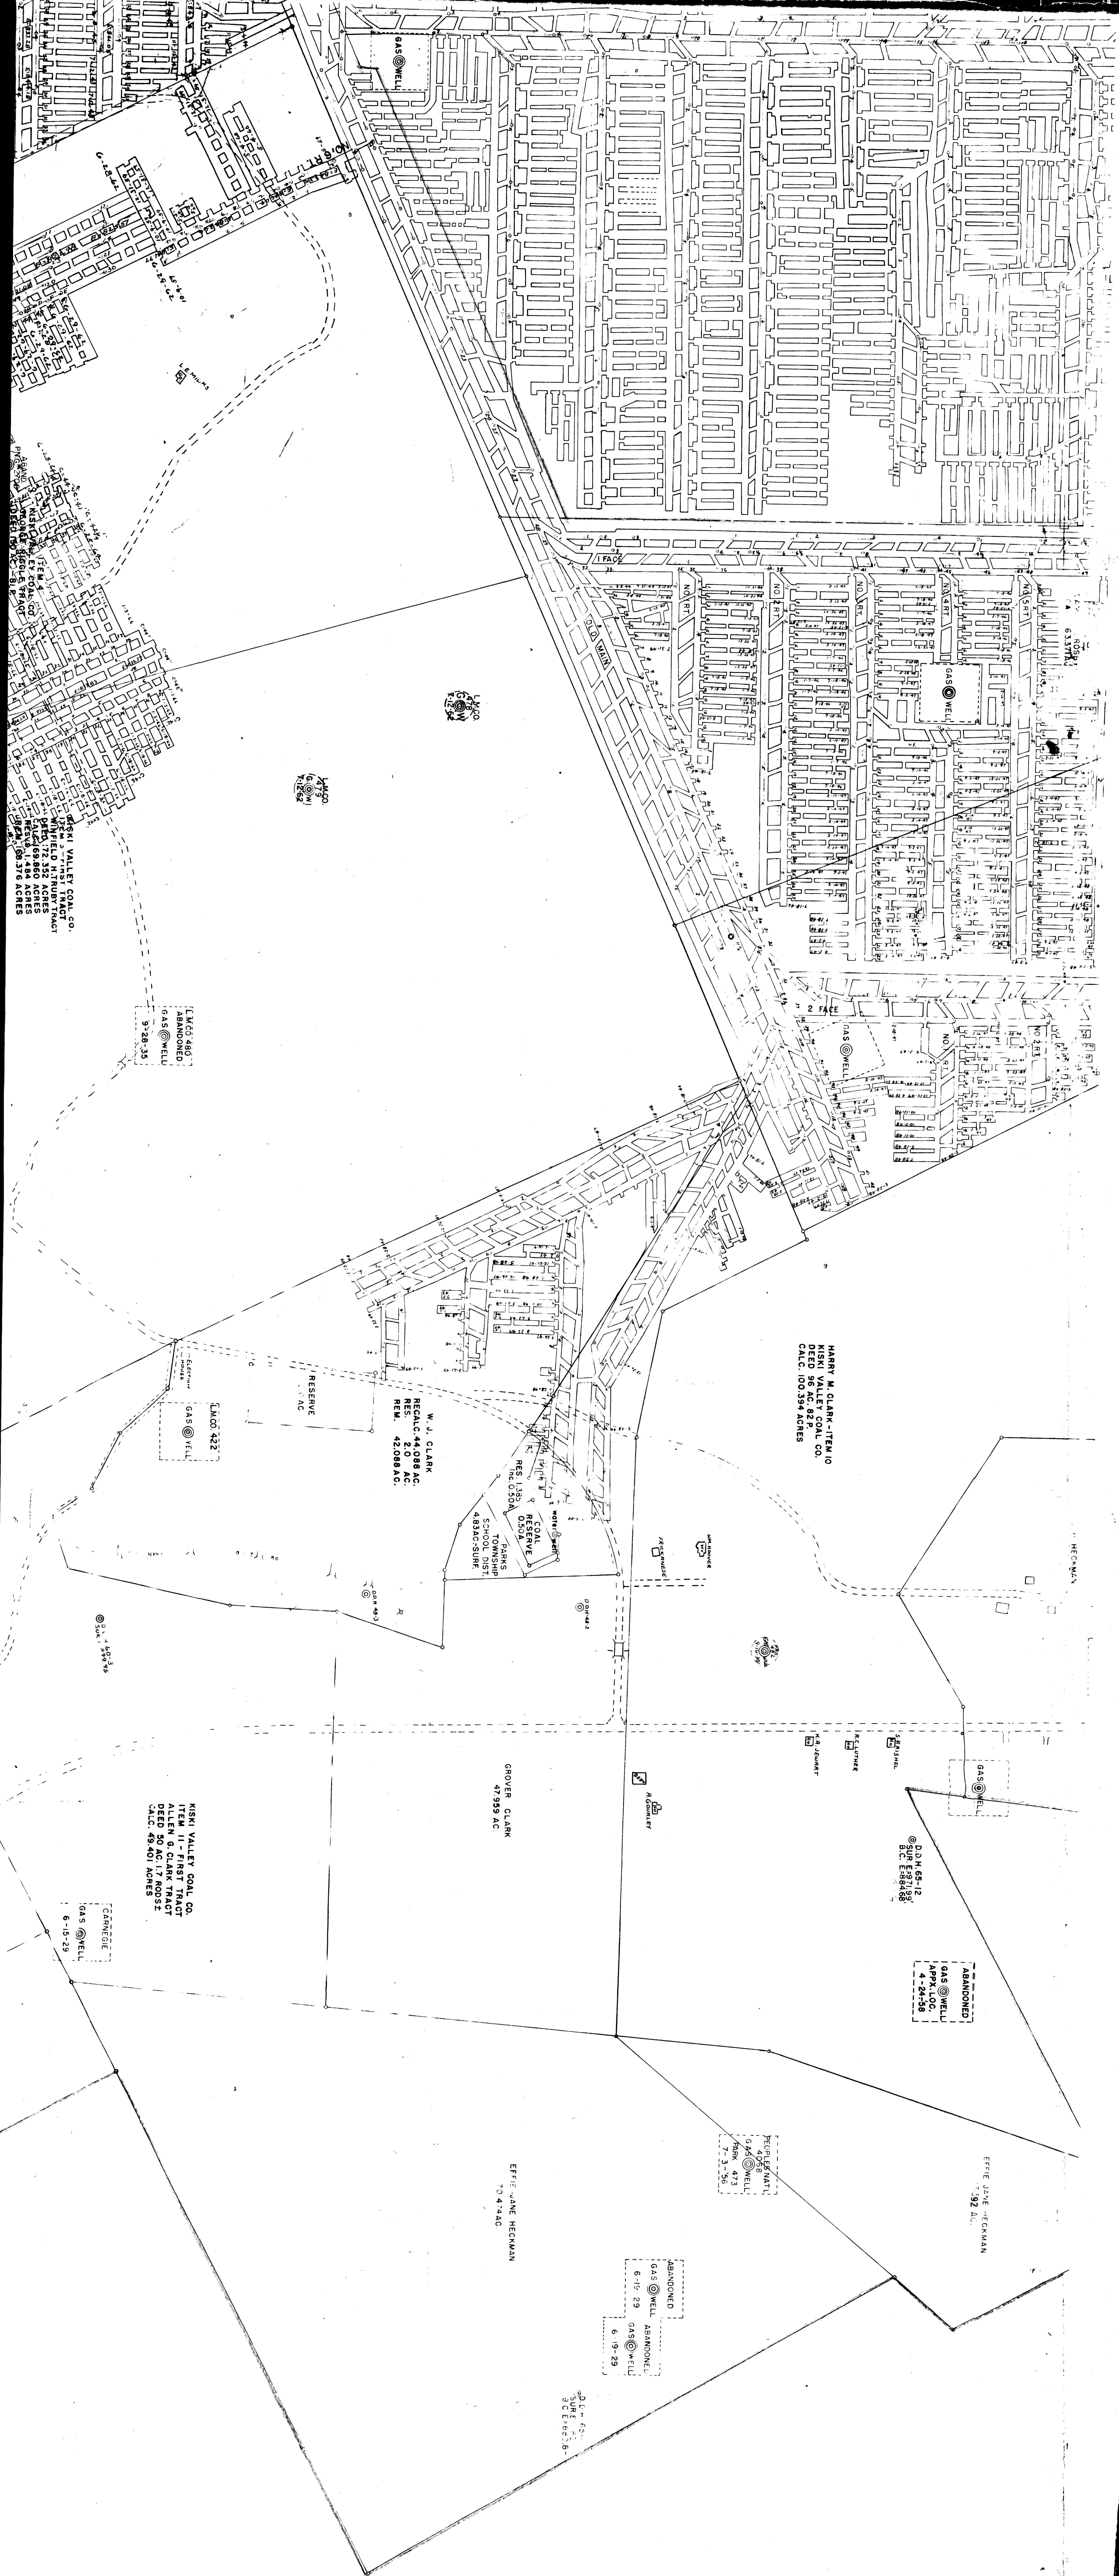

KISKI VALLEY COAL CO.  
ITEM 1 - FIRST TRACT  

LMKOT 422  
GAS @ WELL  
ABANDONED  
9-28-35

W. J. CLARK  
REGALC 44.088 AC.  
RES. 2.0 AC.  
REM. 42.088 AC.

COAL RESERVE  
TOWNSHIP  
SCHOOL DIST.  
4.83 AC-SURF

HARRY M. CLARK - ITEM 10  
KISKI VALLEY COAL CO.  
DEED 96 AC. 82 P.  
CALC. 100.394 ACRES

KISKI VALLEY COAL CO.  
ITEM 11 - FIRST TRACT  
ALLEN G. CLARK TRACT  
DEED 50 AC. 17 RODS  
CALC. 49.401 ACRES

GROVER CLARK  
47.959 AC

D.O.M. 65-12  
SURF 527.59  
B.C. 538.68

ABANDONED  
GAS @ WELL  
APX. LOC.  
4-24-38

PEOPLE'S NATL.  
GAS @ WELL  
BANK 473  
7-3-56

EFFIE JANE HECKMAN  
7-32 D.C.

ABANDONED  
GAS @ WELL  
6-15-29

ABANDONED  
GAS @ WELL  
6-19-29

D.O.M. 65-12  
SURF 527.59  
B.C. 538.68