



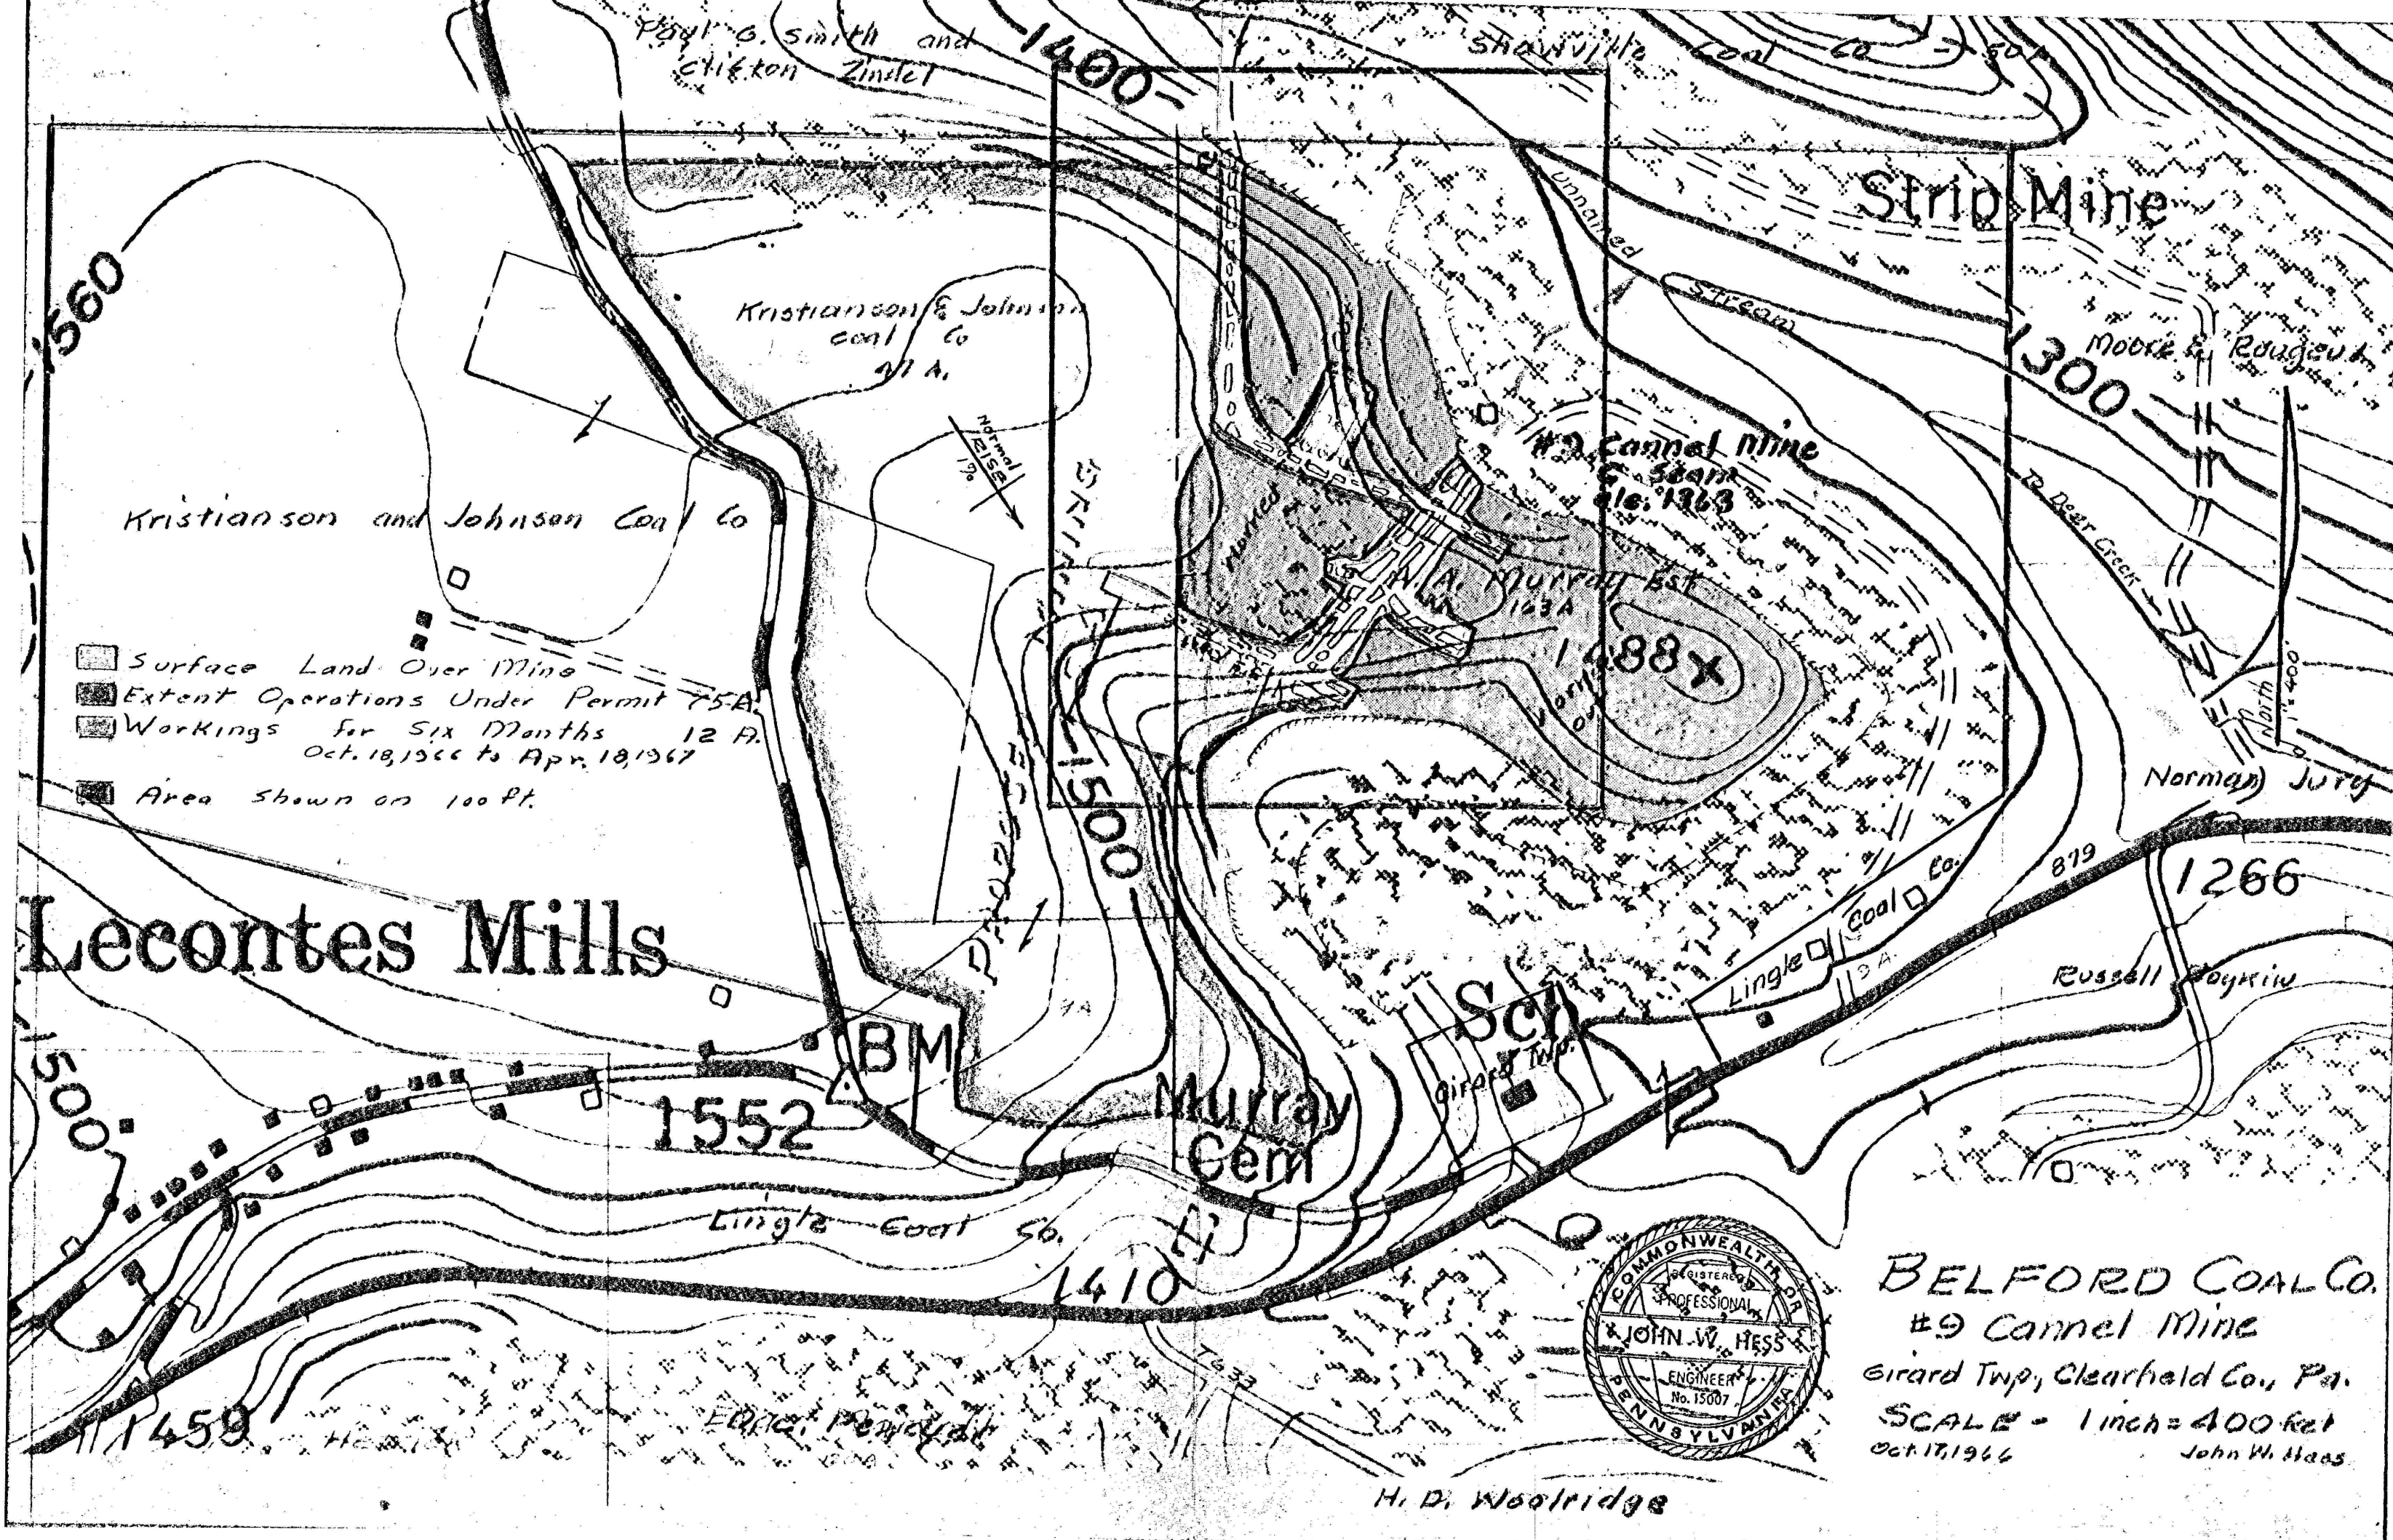

- Surface Land Over Mine
- Extent Operations Under Permit 75A
- Workings For Six Months 12 A.
Oct. 18, 1966 to Apr. 18, 1967
- Area Shown on 100 Ft.

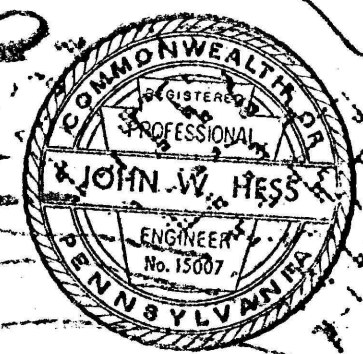

BELFORD COAL CO.
#9 Cannel Mine
Girard Twp, Clearfield Co., Pa.
SCALE - 1 inch = 400 feet
Oct. 17, 1966
John W. Hess

H. D. Woolridge