


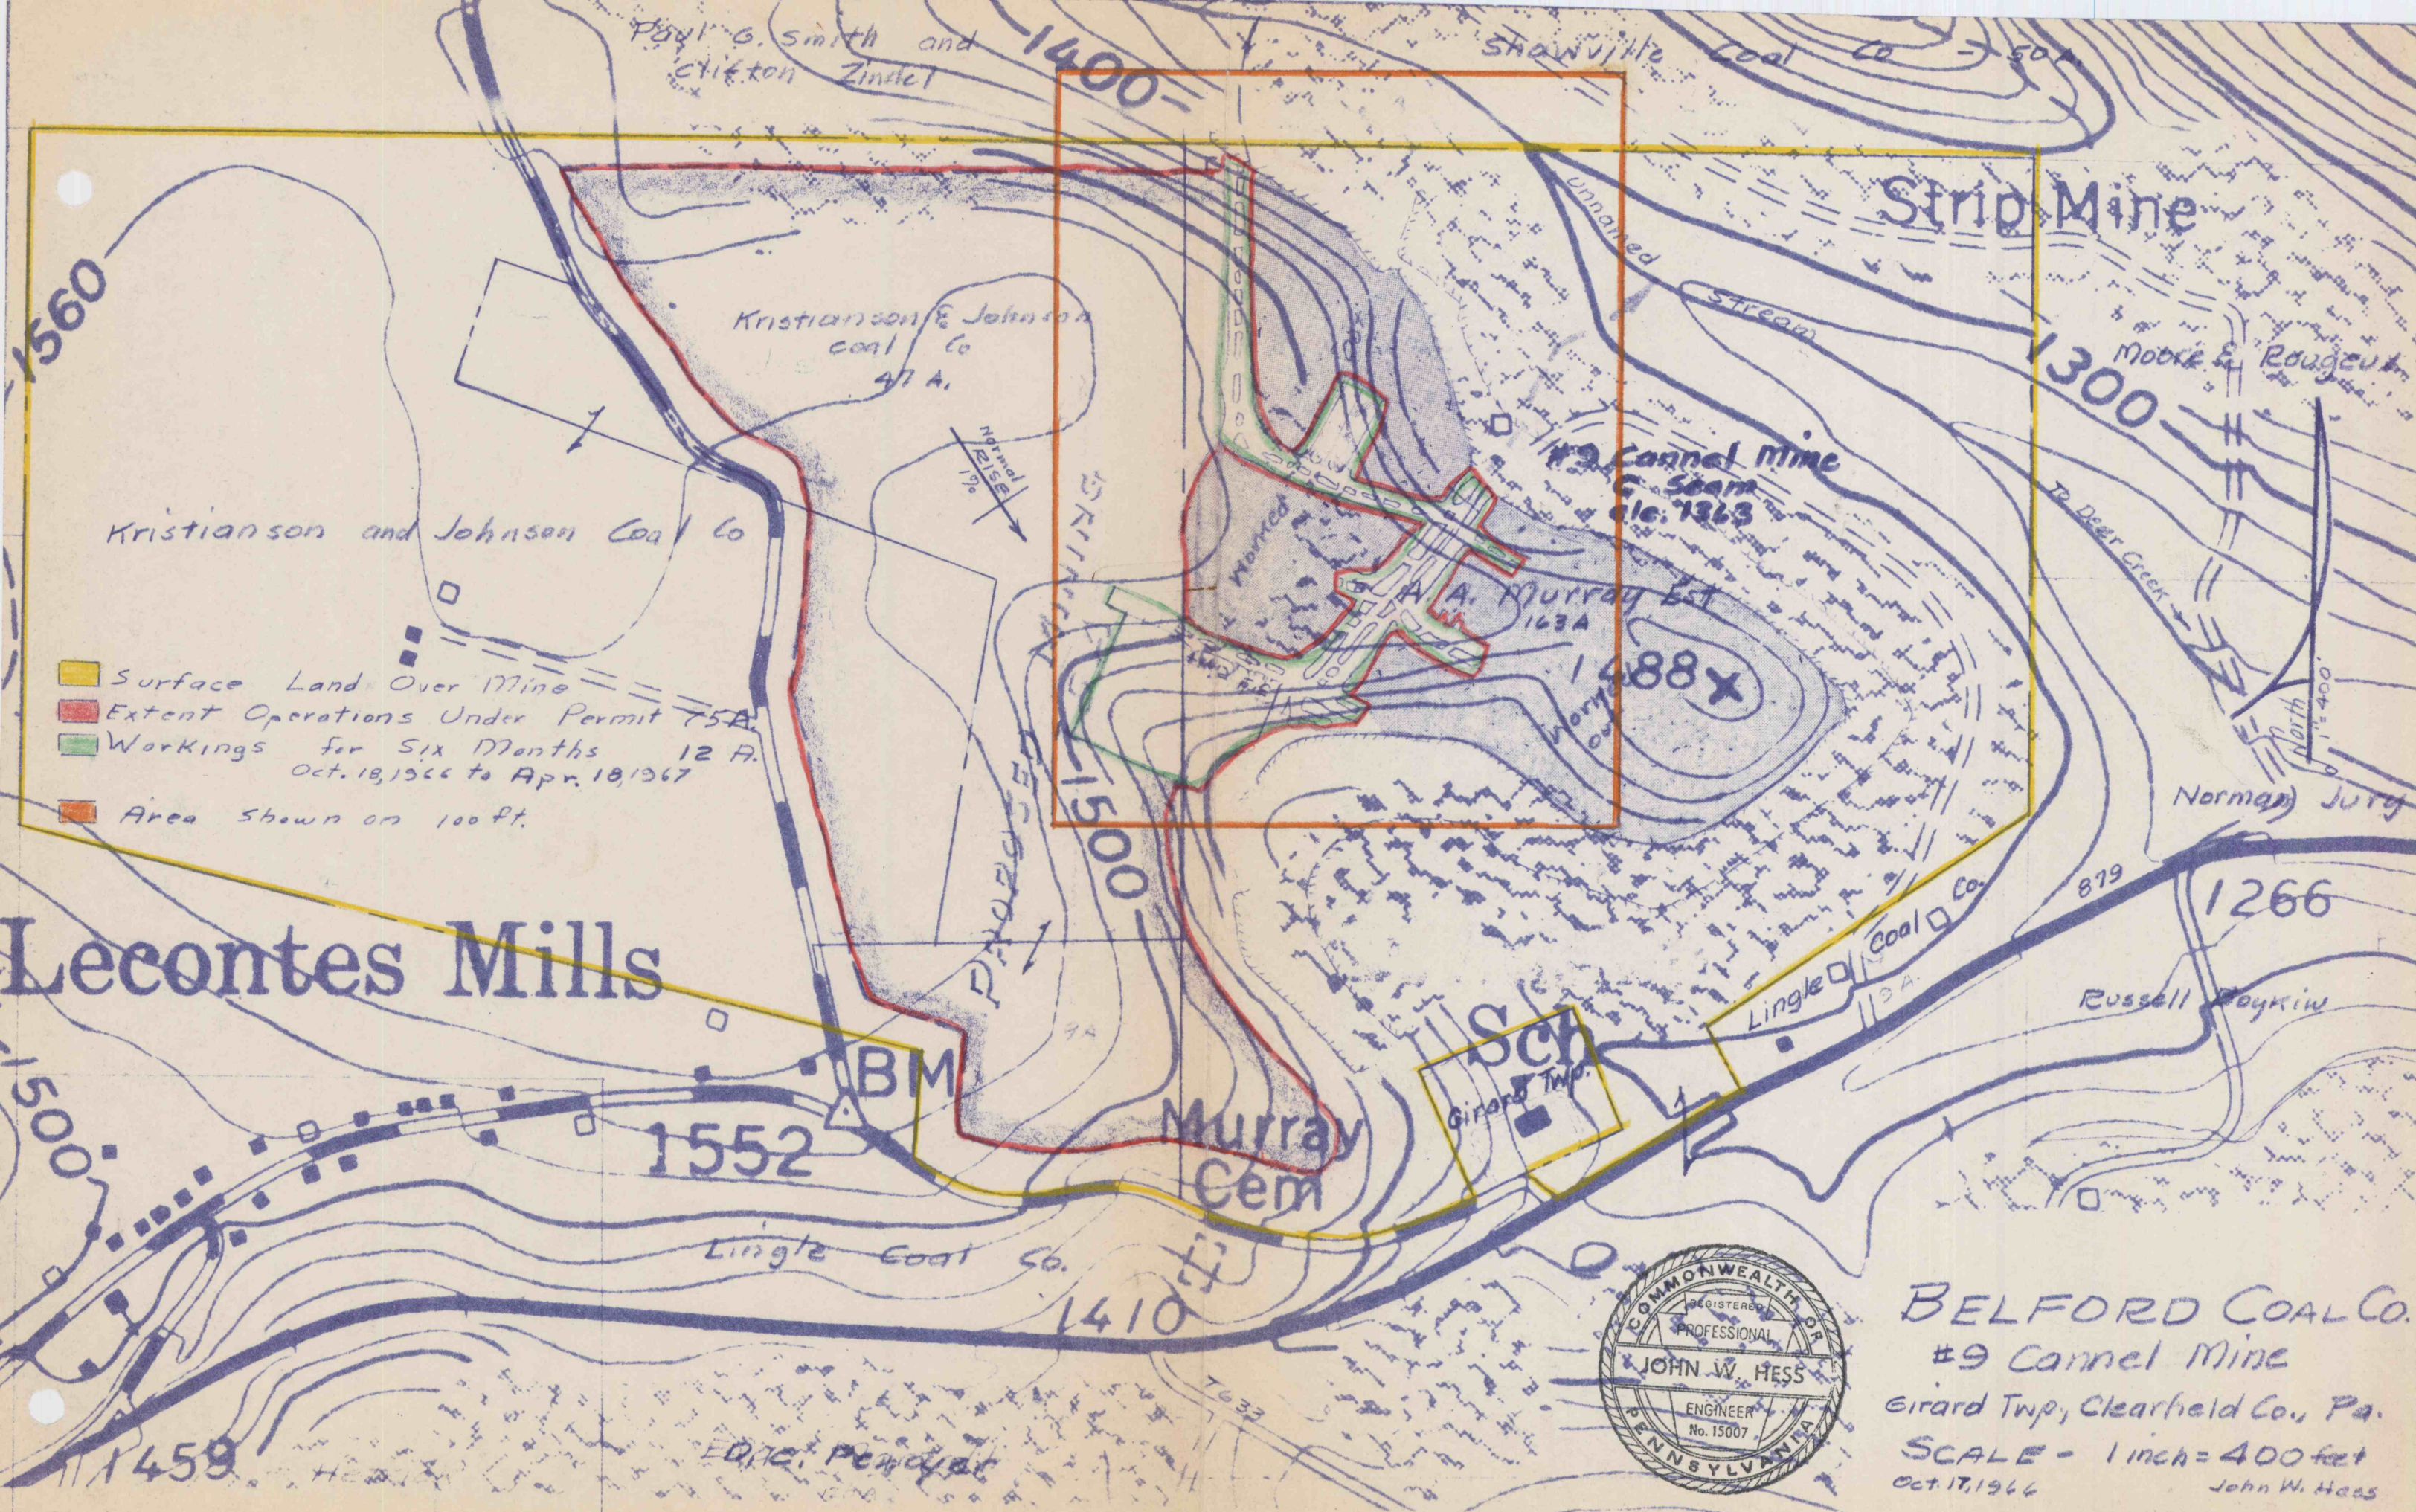

Paul G. Smith and  
Clifton Zindel

Shawville Coal Co. - 50 A.

Strip Mine

Moore & Rougeau

Kristianson & Johnson  
Coal Co.  
47 A.

#9 Cannel mine  
Seam  
ele. 1363

A. Murray Est  
163 A.

1488x

Kristianson and Johnson Coal Co

- Surface Land Over Mine
- Extent Operations Under Permit 75 A.
- Workings for Six Months 12 A.  
Oct. 18, 1966 to Apr. 18, 1967
- Area Shown on 100 Ft.

Lecontes Mills

BM

1552

Murray Cem

Sch  
Girard Twp.

Lingle Coal Co.  
119 A.

Russell Boykin

Lingle Coal Co.

1410



BELFORD COAL CO.  
#9 Cannel Mine

Girard Twp, Clearfield Co., Pa.

SCALE - 1 inch = 400 feet  
Oct. 17, 1966 John W. Hess

H. D. Woolridge