

9 CANNEL MINE

SCALE - 1 inch = 100 feet


Permit #16-2

October 17, 1966

Revised for Subsidence
April 11, 1967

Workings for six Months
12 A.

Apr. 18, 1967 to Oct. 18, 1967

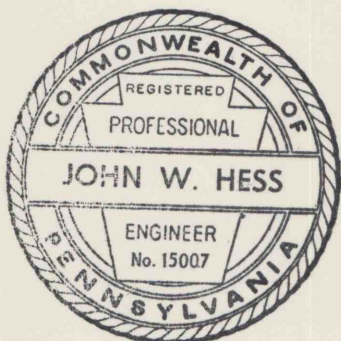

BELFORD COAL COMPANY

9 CANNEL MINE

SCALE - 1 inch = 100 feet

Permit #16-2

October 17, 1966

Revised for Subsidence

April 11, 1967

Workings for six Months

12 A.

Apr. 18, 1967 to Oct. 18, 1967