


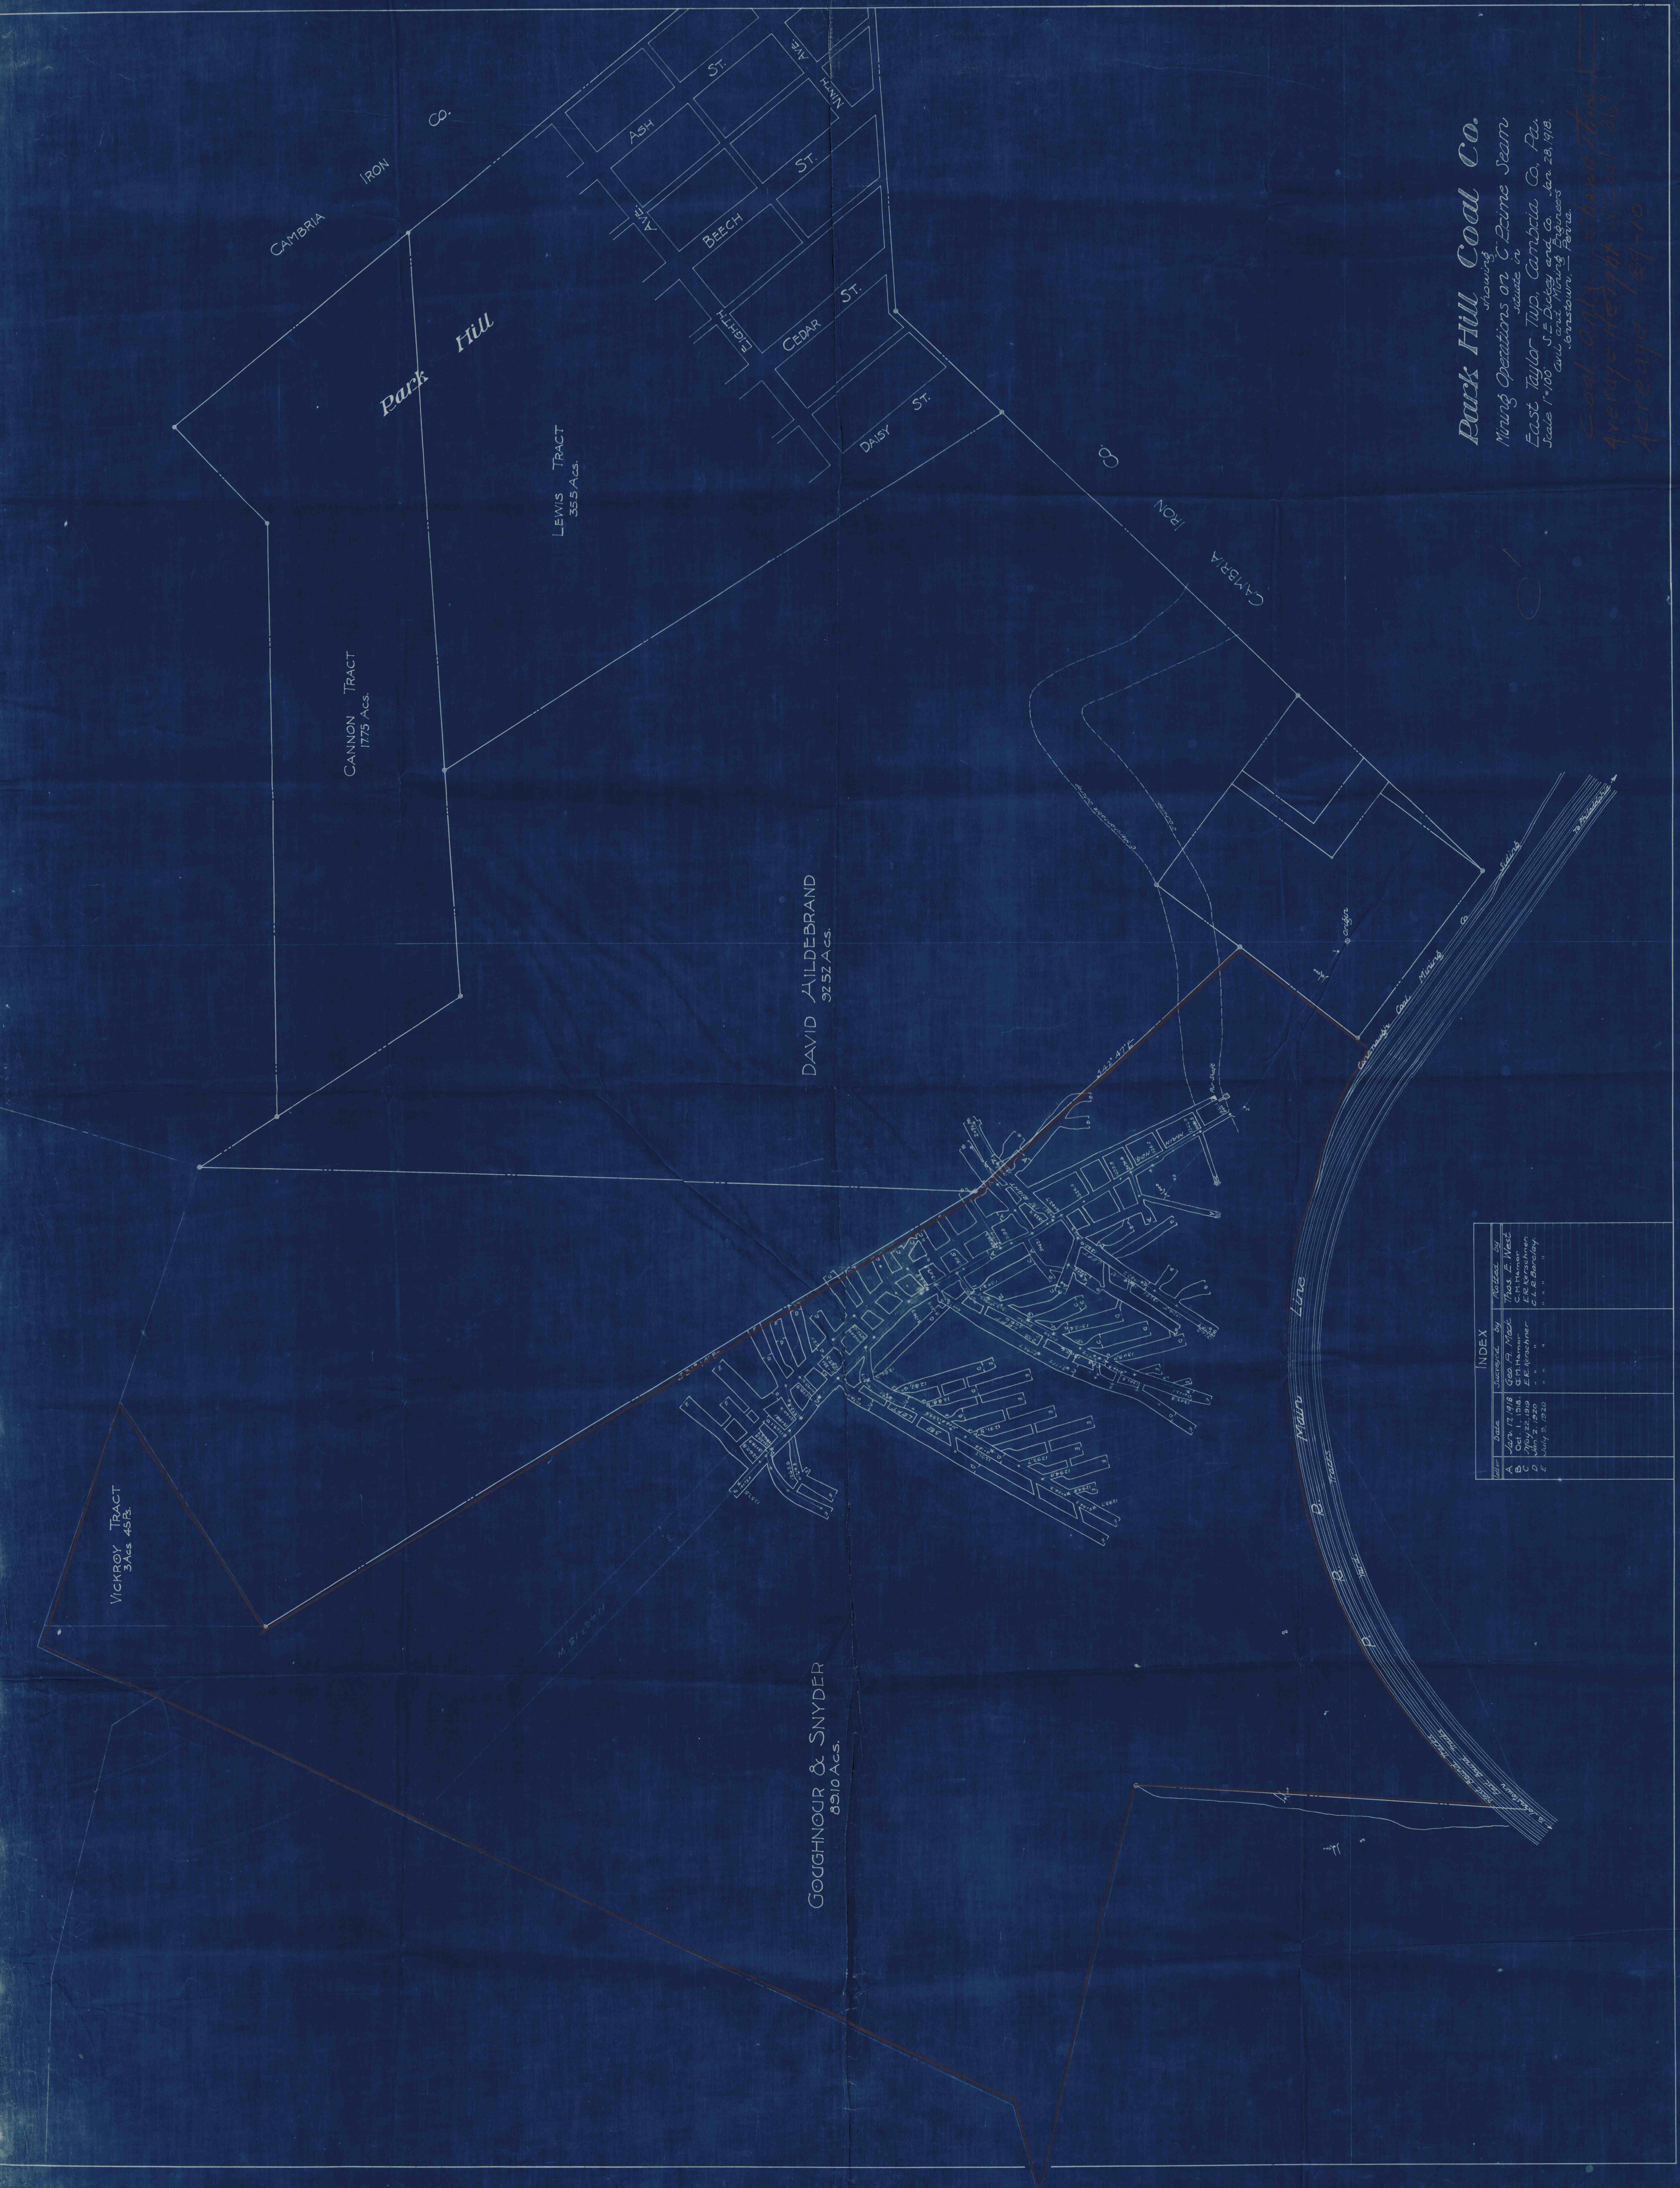

Park Hill Coal Co.

showing
Mining Operations on C. D. Lane Seam
located in
East Taylor Twp. Cambria Co., Pa.
Scale 1"=100' S.E. Dwyer and Co. Jan. 28, 1918.
Civil and Mining Engineers
Pittsburgh, Pa.

Coal only shown
Average depth 10' to 15'
Average 18' to 20'

INDEX			
Map	Date	Owner	Notes
A	Jan. 17, 1918	G. D. Lane	Tract E West
B	Oct. 1, 1918	C. M. Hannon	E. R. & G. Schenck
C	July 2, 1919	E. R. & G. Schenck	" "
D	July 2, 1920	" "	" "
E	" "	" "	" "
F	" "	" "	" "
G	" "	" "	" "
