


W. J. NUGENT

MAP OF NO 1 MINE
PATCHIN COAL COMPANY
EMIGH, CAMBRIA CO. PA.
Scale 100' = 1" May 15, 1918.
Office of
H. F. VanVolzoh
Mining Eng.
Clearfield Pa.

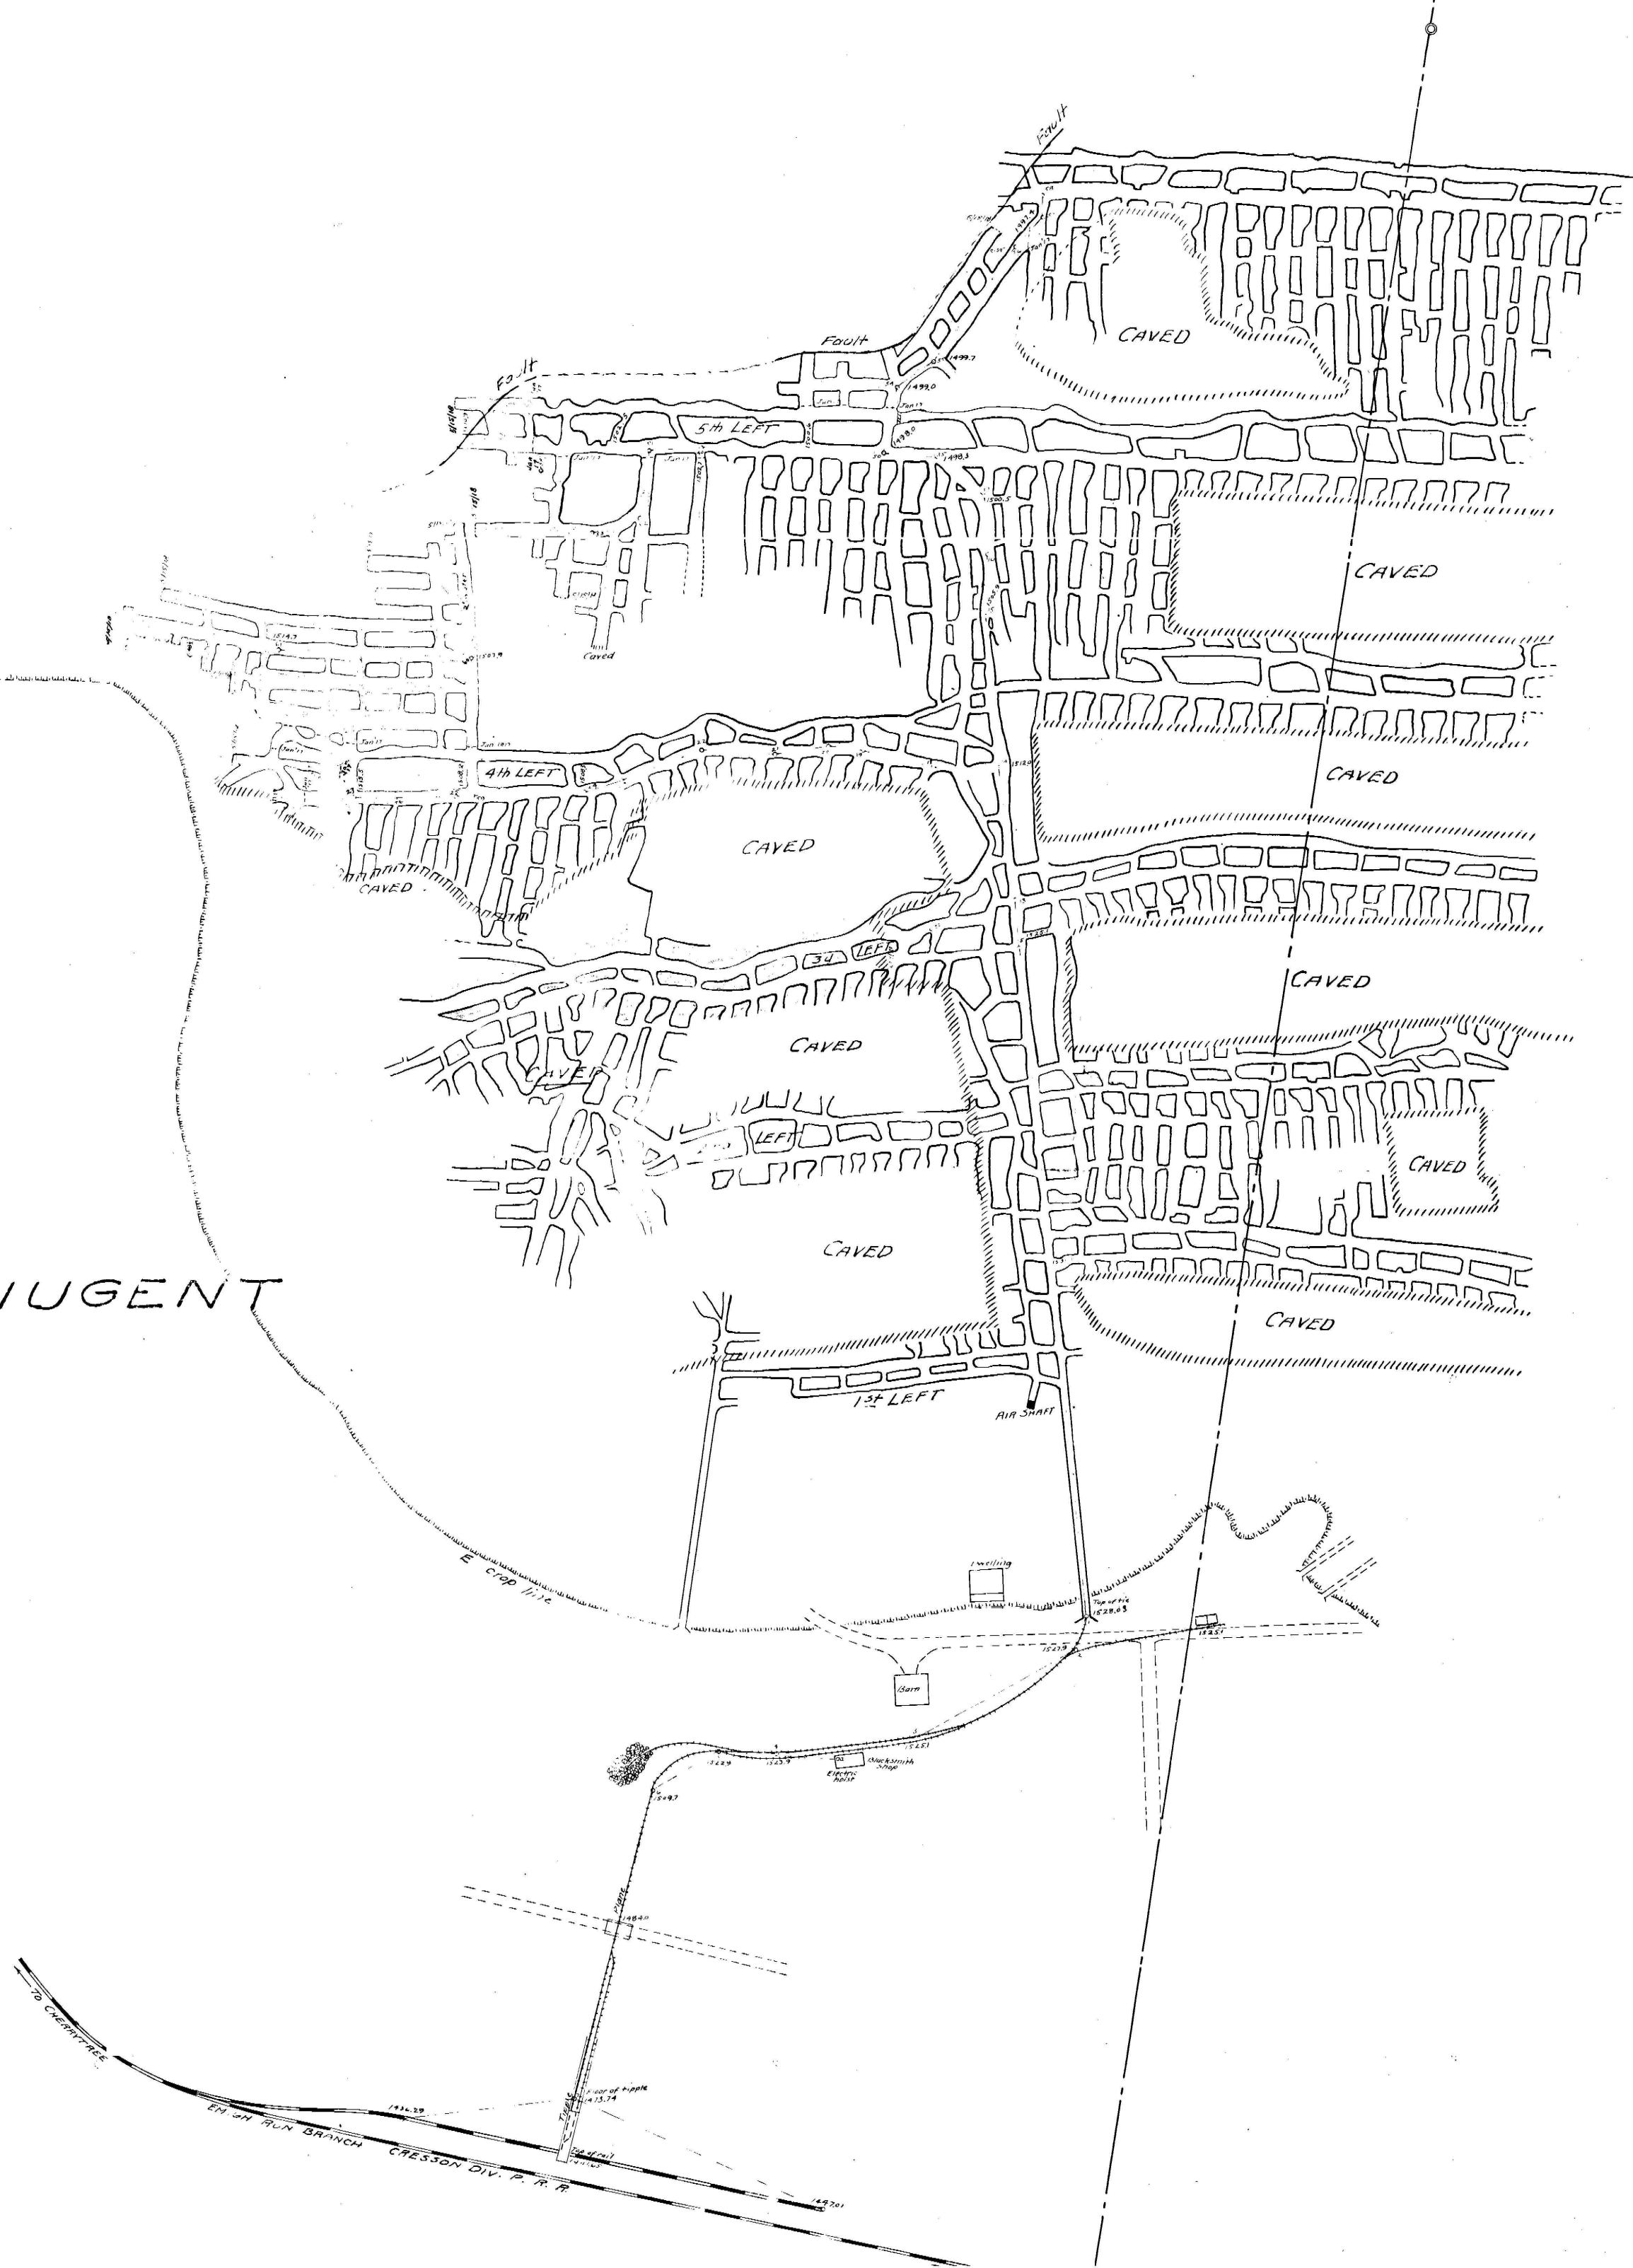

CHERRYTREE COAL CO