


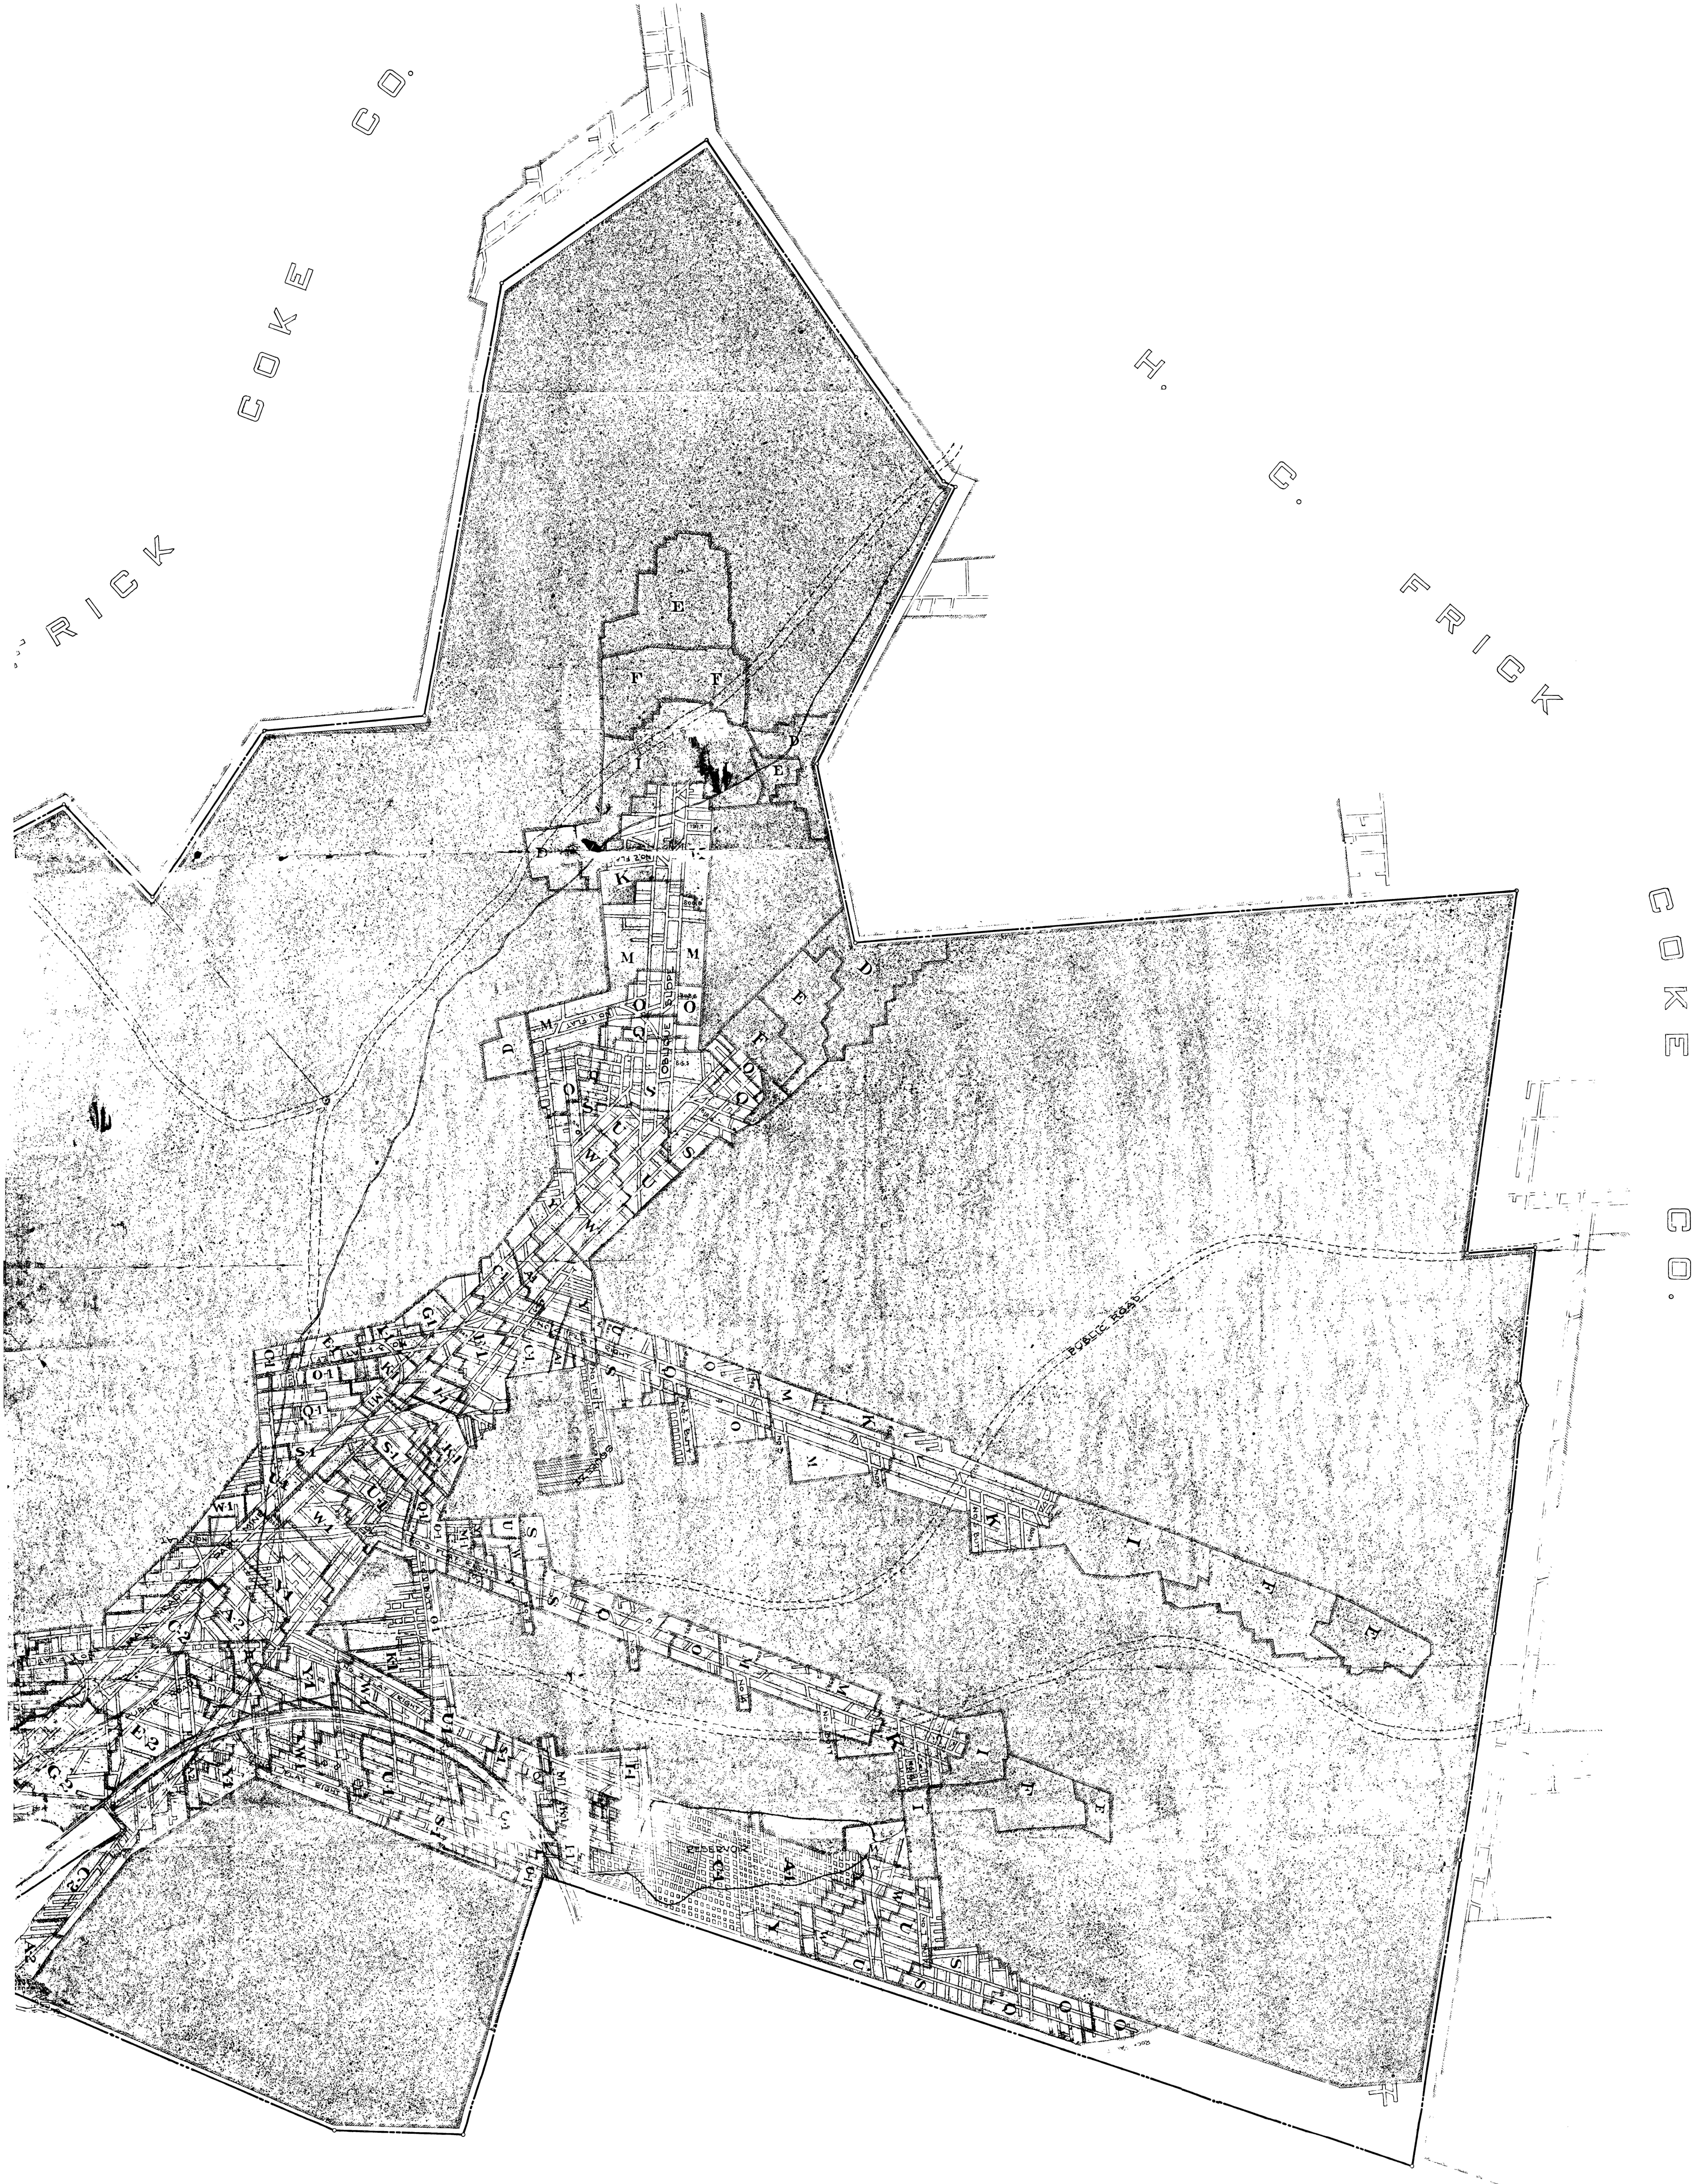

OF
& PAUL MINES

INEY

AYETTE CO., PA.

DATE OF SURVEY			
A =	F =	E 1 =	U 1 =
B =	Q =	1 =	W 1 =
C =	R =	2 =	X 1 =
D =	S =	3 =	A 2 =
E =	T =	4 =	C 2 =
F =	U =	5 =	E 2 =
G =	V =	6 =	G 2 =
H =	W =	7 =	H 2 =
I =	X =	8 =	
J =	Y =	9 =	
K =	Z =	10 =	
L =	A 1 =	11 =	
M =	B 1 =	12 =	
N =	C 1 =	13 =	
O =	D 1 =	14 =	