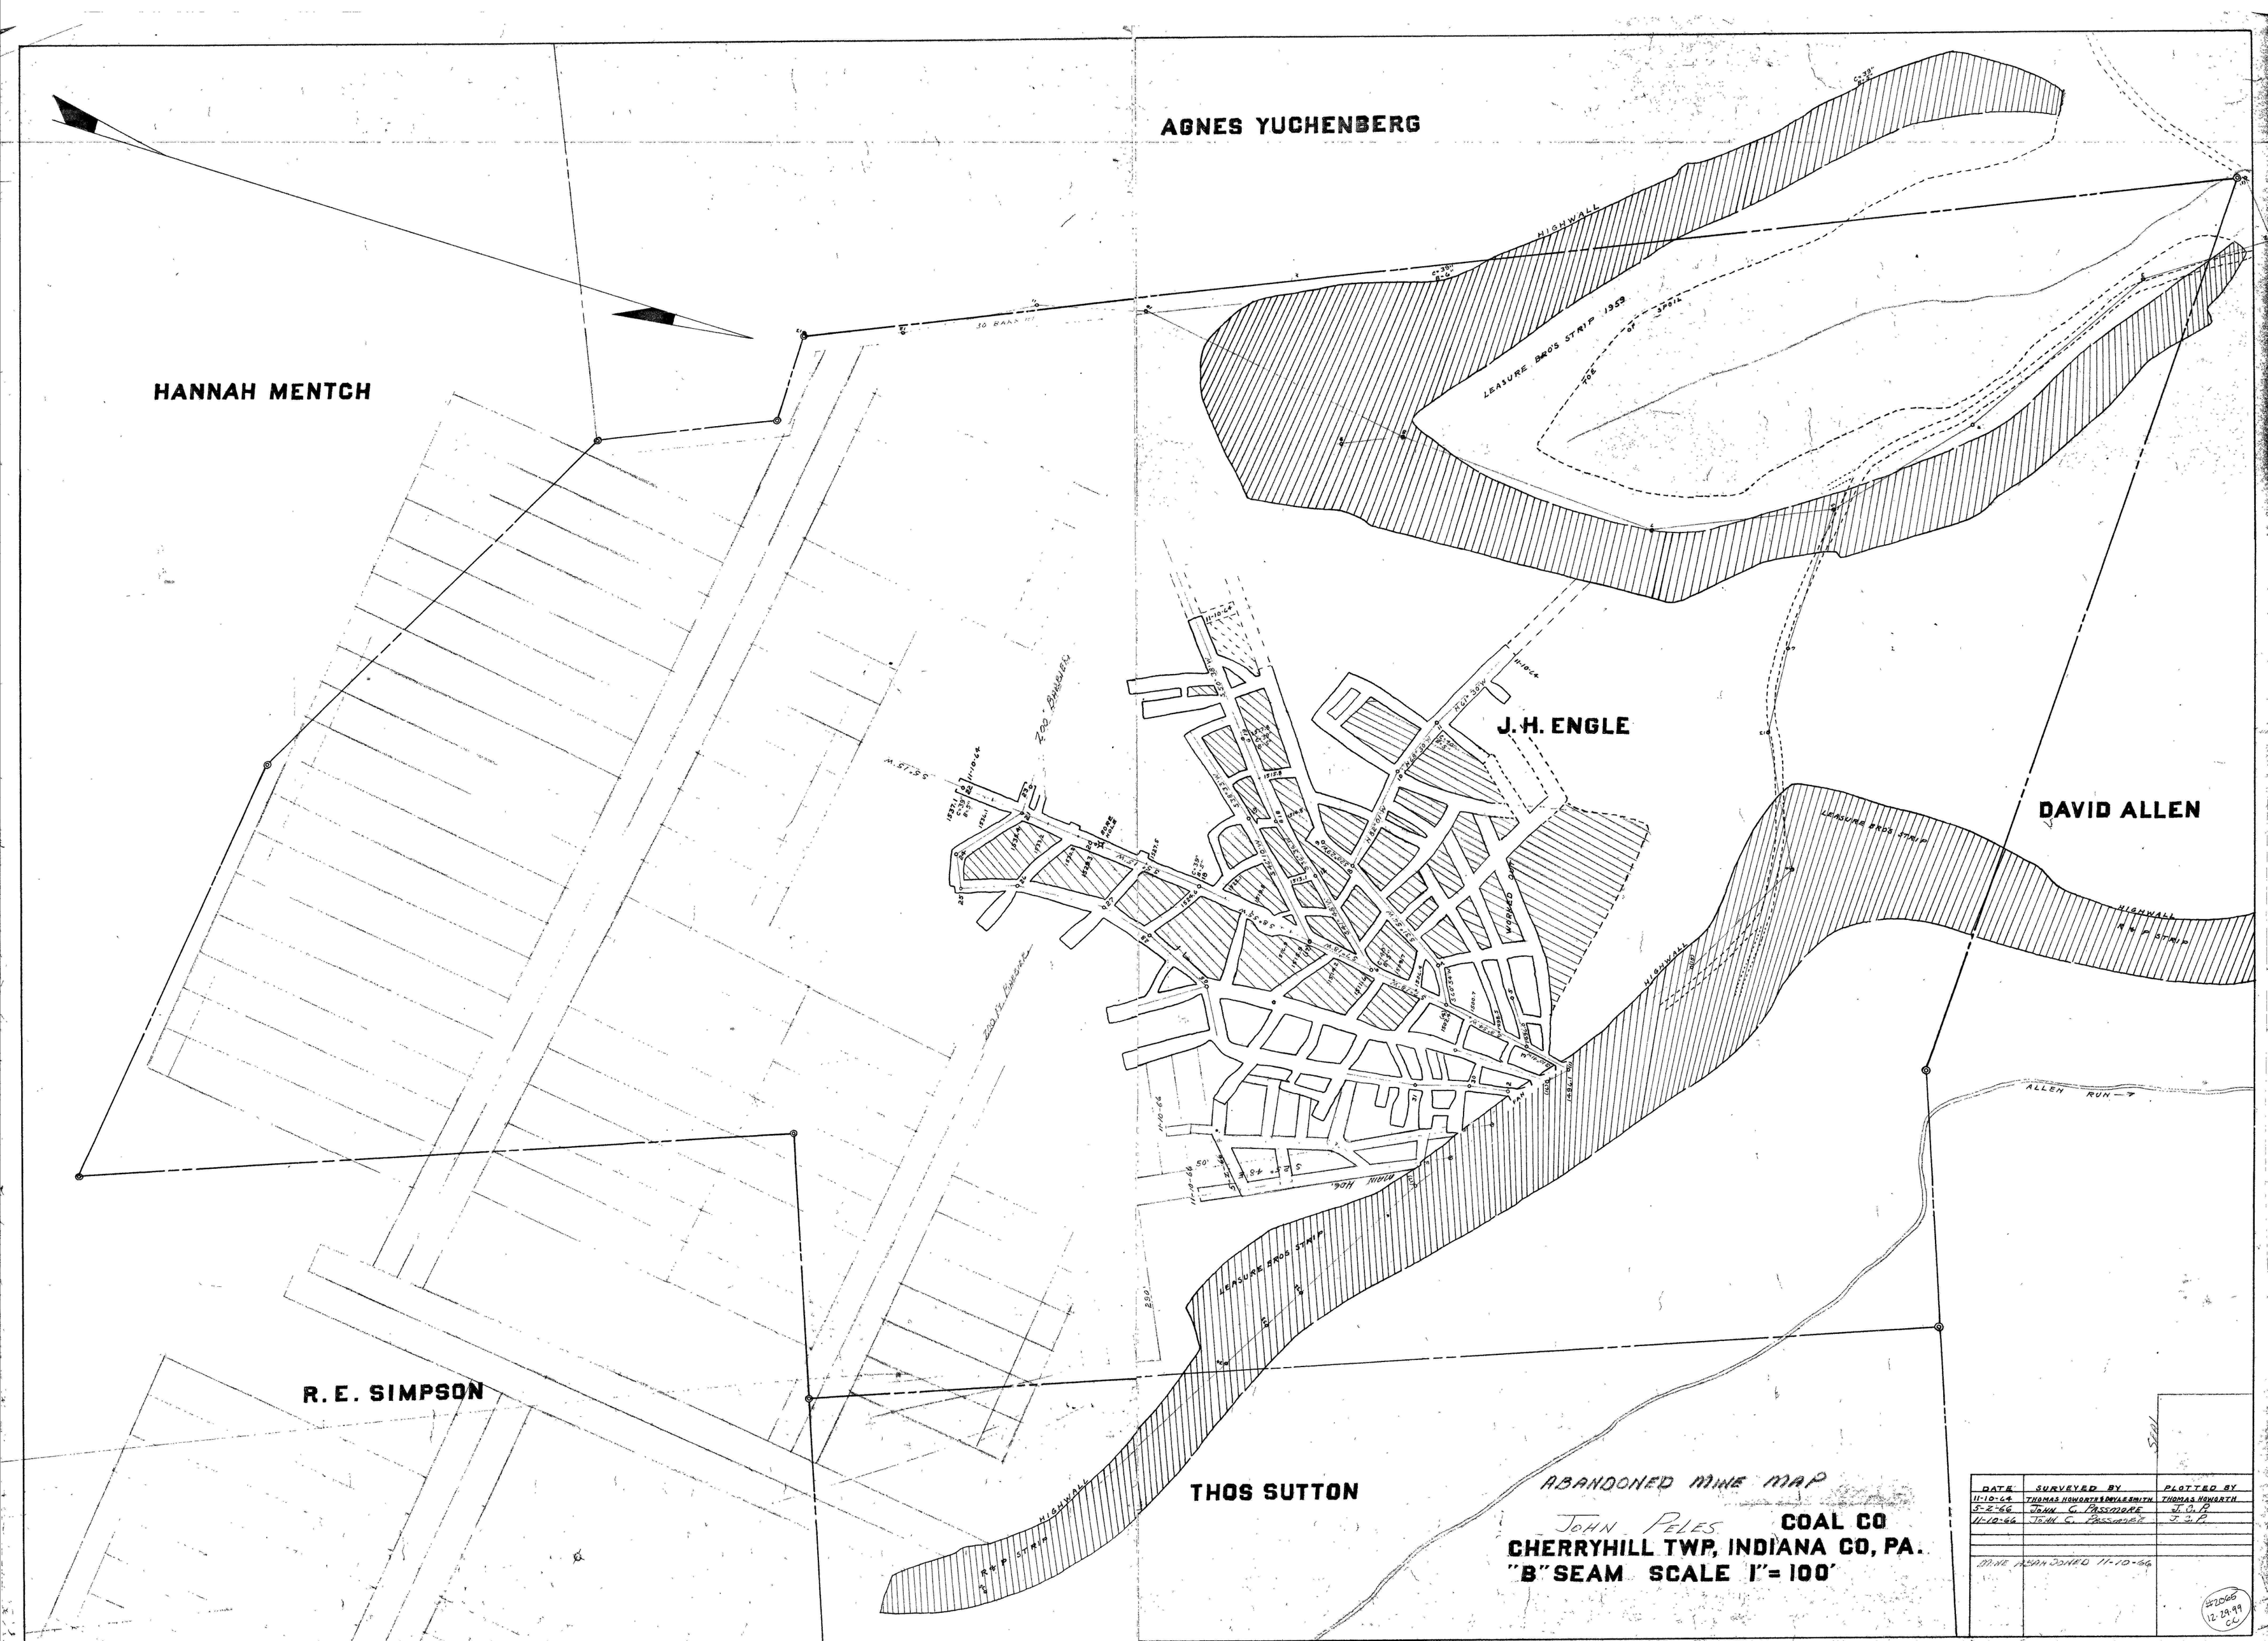
AGNES YUCHENBERG
HANNAH MENTCH
J.H. ENGLE
DAVID ALLEN
R.E. SIMPSON
THOS SUTTON
HIGHWALL
LEASURE BROS STRIP
R&P STRIP
ALLEN RUN
MAIN HOL
ABANDONED MINE MAP
JOHN PELES COAL CO
CHERRYHILL TWP, INDIANA CO, PA.
"B" SEAM SCALE 1"= 100'
DATE | SURVEYED BY | PLOTTED BY
11-10-64 | THOMAS HOWORTH & NYLE SMITH | THOMAS HOWORTH
5-2-66 | JOHN C. PASSMORE | J.O.P.
11-10-66 | JOHN C. PASSMORE | J.O.P.
MINE ABANDONED 11-10-66
#20066
12-29-99
CC